FED.ROAD DIV.NO.	STATE	FED.AID PROJ.NO.
	VT	

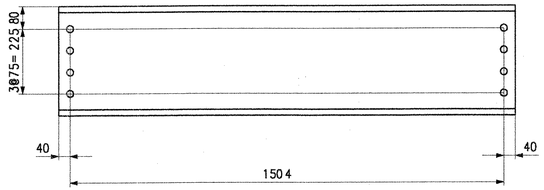

DIAPHRAGM MK.D1

BILL OF MATERIAL

SHIP.	QTY. EA.	MARK	COMM.	DESCRIPTION					LENGTH	SPEC	GRADE	TEST	REMARKS	GRP.	ITEM	SHIP WEIGHT EA. (KG)
				DIAPHRAGMS												
1	8	D1	C	380	x	50.4			1584	M270M	345W		(C15x33.9)	10	1	79.83
2	12	D1	C	380	x	50.4			1584	M270M	345W		(C15x33.9)	10	1	79.83
TOTAL WEIGHT THIS SHEET:													1596.67 kg			

RECEIVED
CK'D BY VHB CK'D BY
AUG 21 2006
RESUBMIT APPROVED As Noted
BY WJK DATE 9/19/06

SHOP DRAWING REVIEW

☐ REVIEWED AS REQUIRED BY THE CONSTRUCTION CONTRACT DOCUMENTS AND APPROVED, BUT ONLY FOR CONFORMANCE TO THE DESIGN CONCEPT OF THE WORK, AND SUBJECT TO FURTHER LIMITATIONS AND REQUIREMENTS CONTAINED IN THE CONSTRUCTION CONTRACT DOCUMENTS.

☐ REJECTED ☐ REVISE AND RESUBMIT ☒ FURNISH AS CORRECTED

CORRECTIONS OR COMMENTS MADE ON THE SHOP DRAWINGS DURING THIS REVIEW DO NOT RELIEVE CONTRACTOR FROM COMPLIANCE WITH REQUIREMENTS OF THE DRAWINGS AND SPECIFICATIONS. THIS CHECK IS ONLY FOR REVIEW OF GENERAL CONFORMANCE WITH THE DESIGN CONCEPT OF THE PROJECT AND GENERAL COMPLIANCE WITH THE INFORMATION GIVEN IN THE CONTRACT DOCUMENTS. THE CONTRACTOR IS RESPONSIBLE FOR: CONFIRMING AND CORRELATING ALL QUANTITIES AND DIMENSIONS; SELECTING FABRICATION PROCESSES AND TECHNIQUES OF CONSTRUCTION; COORDINATING HIS WORK WITH THAT OF ALL OTHER TRADES; AND PERFORMING HIS WORK IN A SAFE AND SATISFACTORY MANNER.

VHB Vanasse Hangen Brustlin, Inc. Engineers, Planners, and Scientists Six Bedford Farms, Kitton Rd. Bedford, NH 03110 603 644 0888

Job Number: 50549
Reviewed By: C.S. CAPONER
Date: 9/6/06

NOTES:

HOLES: 15/16" Ø
BOLTS: NONE
PAINT: NONE
FOR GENERAL SHOP NOTES, SEE DWG. GN1.

CODE: 56

NO.	REVISION	BY	DATE
△			
△			
△			

HIGH STEEL STRUCTURES, INC.
1770 Hempstead Road
Lancaster, PA 17605-0008
Phone 717/299-5211
A Division of High Industries, Inc.

FAYSTON

DIAPHRAGM D1
VT 17 OVER MILL BROOK
VT 17 STA. 0+944.700 TO STA. 0+968.560
TOWN OF FALSTON, WASHINGTON COUNTY, VT
STATE OF VERMONT
AGENCY OF TRANSPORTATION

STATE CONTRACT OR REF. NO. BRIDGE NO. 36
CONTRACTOR WINTERSET, INC.
IN CHARGE: CHRISTMAN (IH) MADE BY: ERS CHK'D. BY: MGK DATE: 8-7-06
CONTRACT NUMBER: VT-06062-1&2 DRAWING NUMBER: 1 OF 7

089 55

PLOTTED: DATE567890123456 7 BY: USERNAME

06062 X1 8/11/06 8/11/06Approval TO:Winterset, Inc.