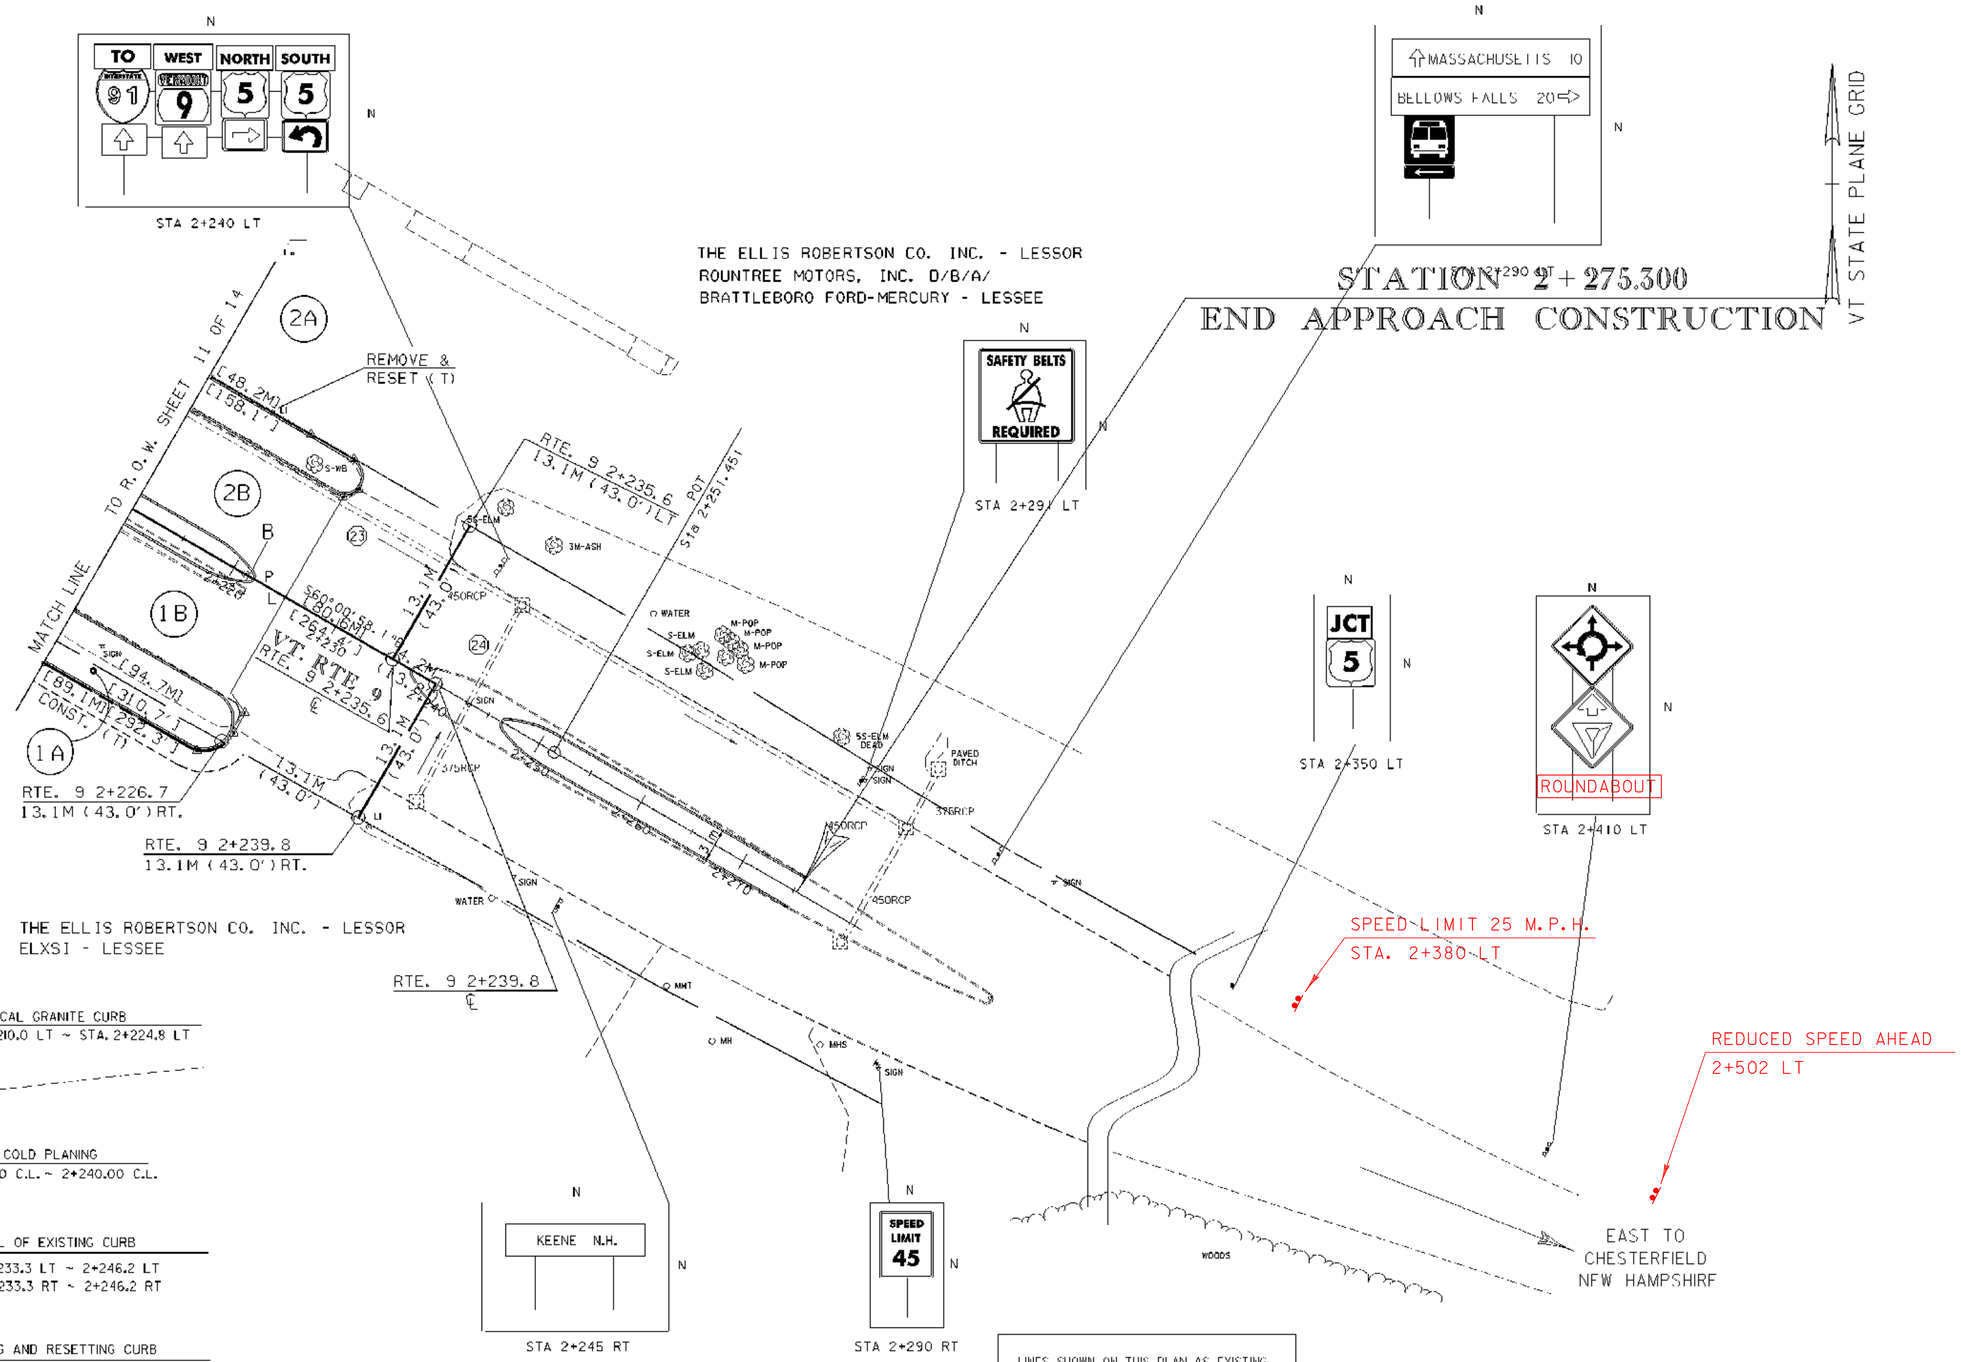

FOR R.O.W. USE ONLY

Metric

rd9114r.1

PROJECT: BRATTLEBORO	PROJECT NO.: NH 2000(18)
DESIGN FILE NAME: /prop/93d191/rd9112zz.dgn	
IPARM FILE NAME: rd9114r.i	PLOT DATE: 8-APR-1999
SURVEYED BY: R. GILMAN	SURVEY DATE: 10-95
SQUAD LEADER: S. MENARD	DRAWN BY: K. UPMAL
R.O.W. SHEET 13 OF 14	SHEET 18 OF 67