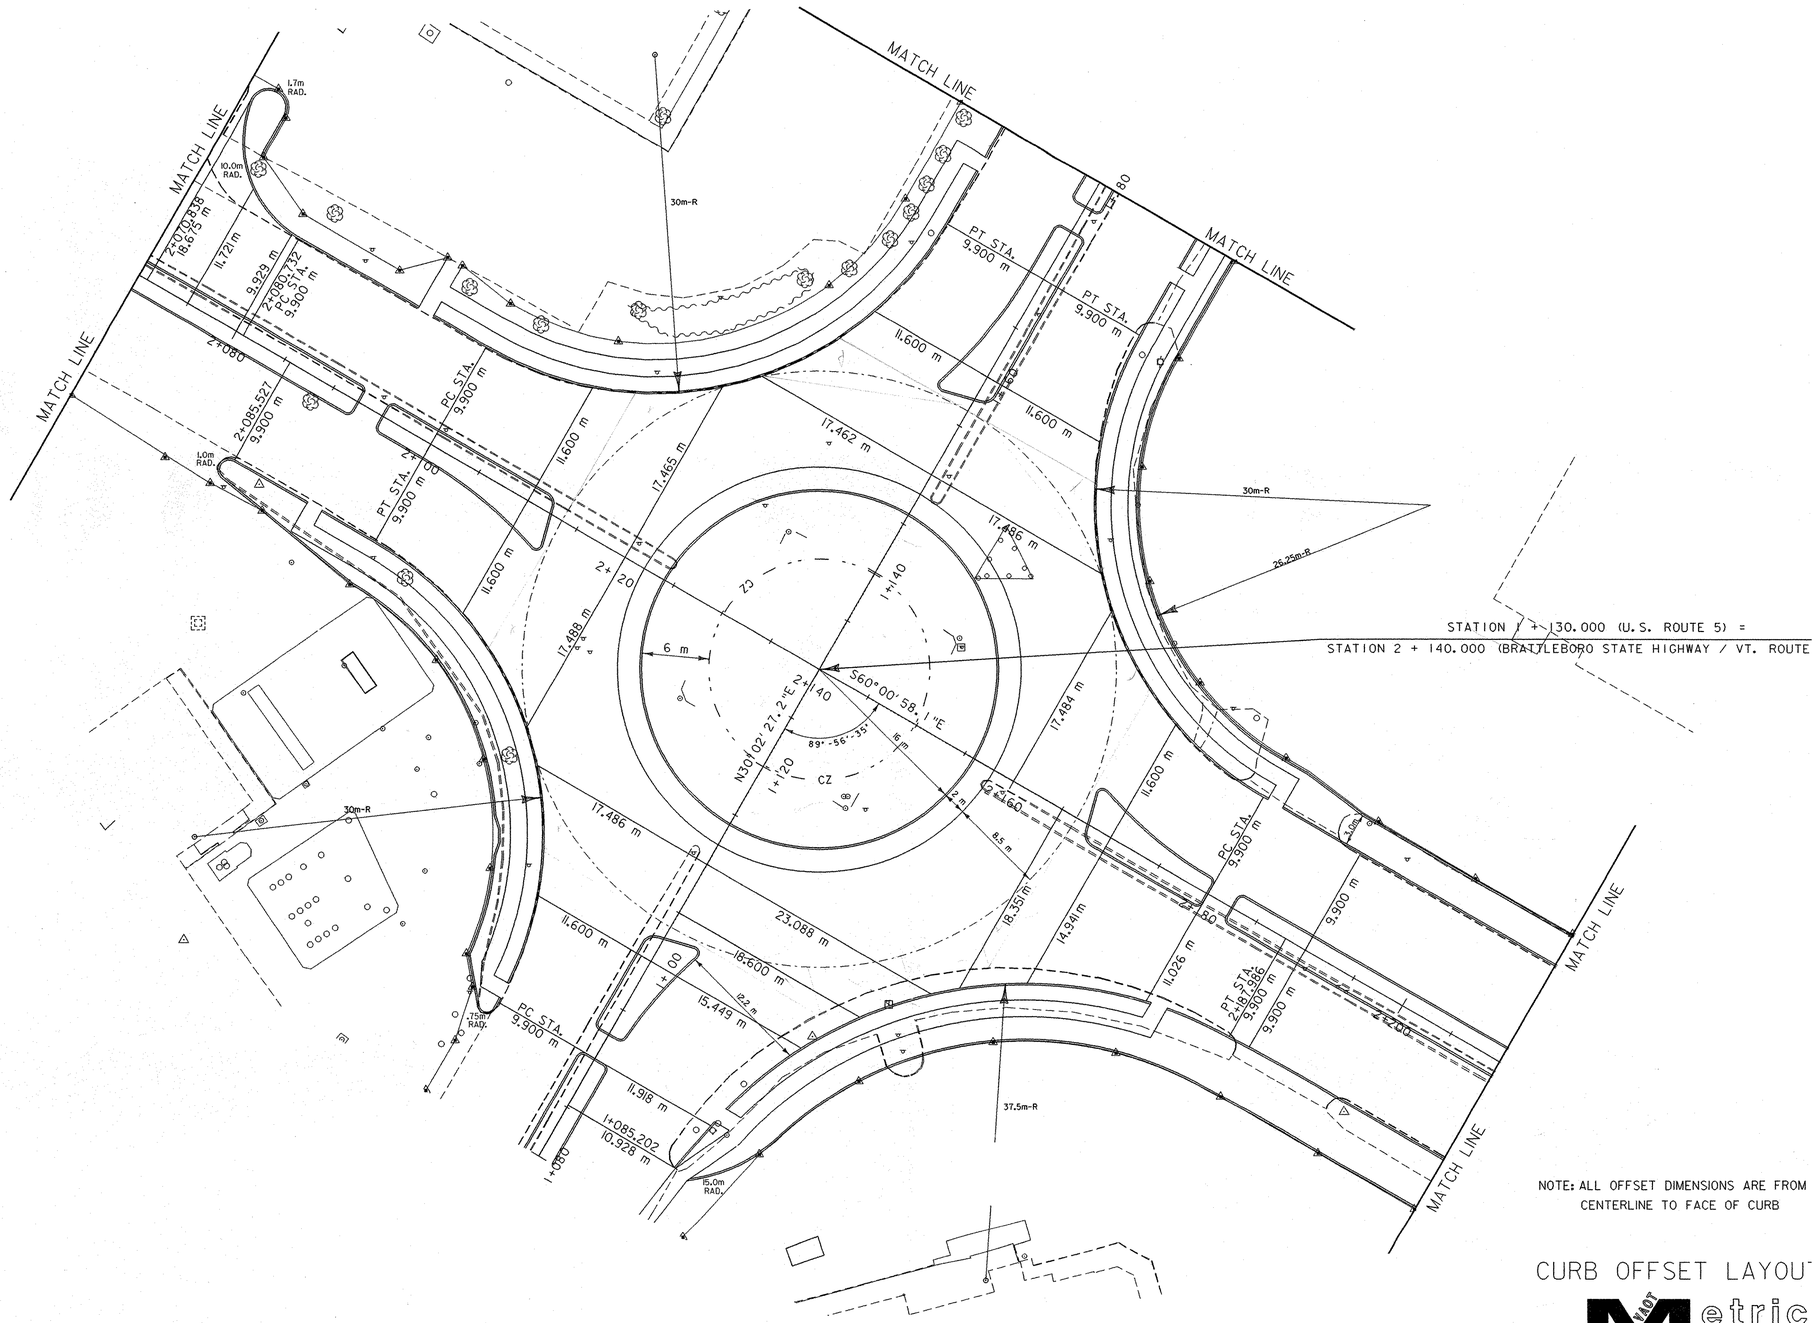

NOTE: ALL OFFSET DIMENSIONS ARE FROM CENTERLINE TO FACE OF CURB

CURB OFFSET LAYOU

Metric

PROJECT: BRATTLEBORO	PROJECT NH
DESIGN FILE NAME: /sqdc/93d191/dd191bdr.dgn	
IPARM FILE NAME: dd191crb.i	PLOT DA
SURVEYED BY: R. GILMAN	SURVEY D
SQUAD LEADER: S. MENARD	DRAWN B
	SHEET: