Metric

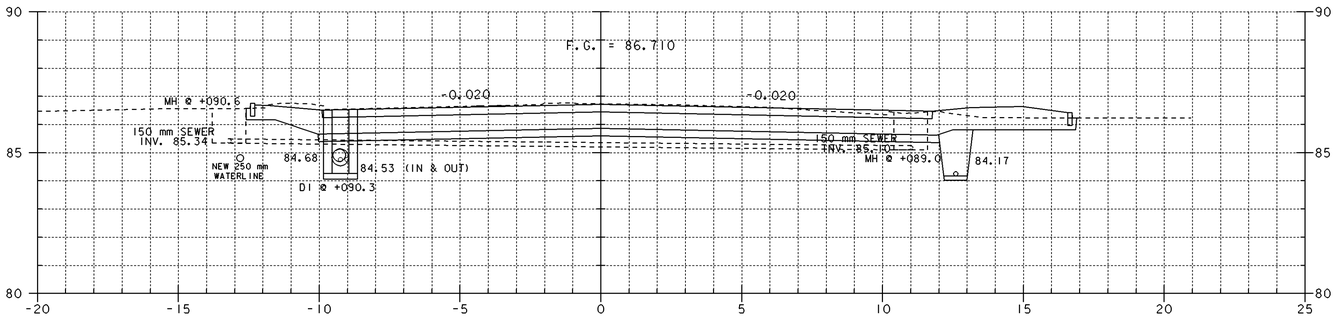

1+090

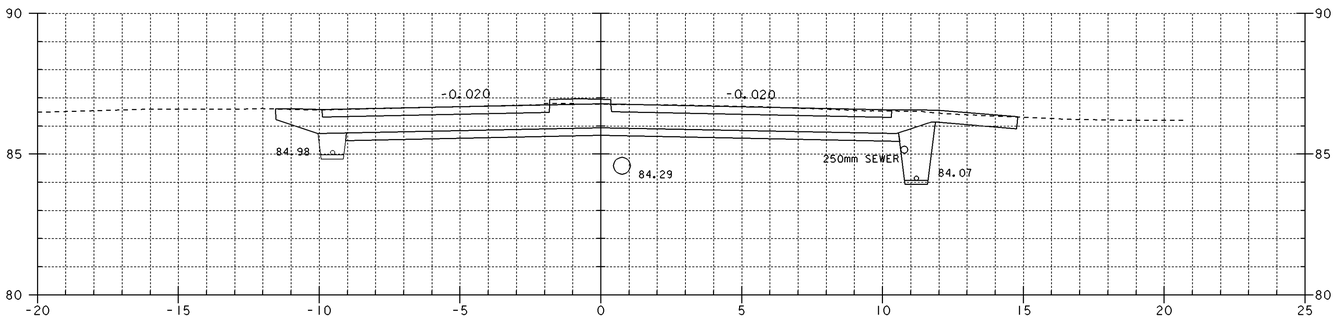

1+080

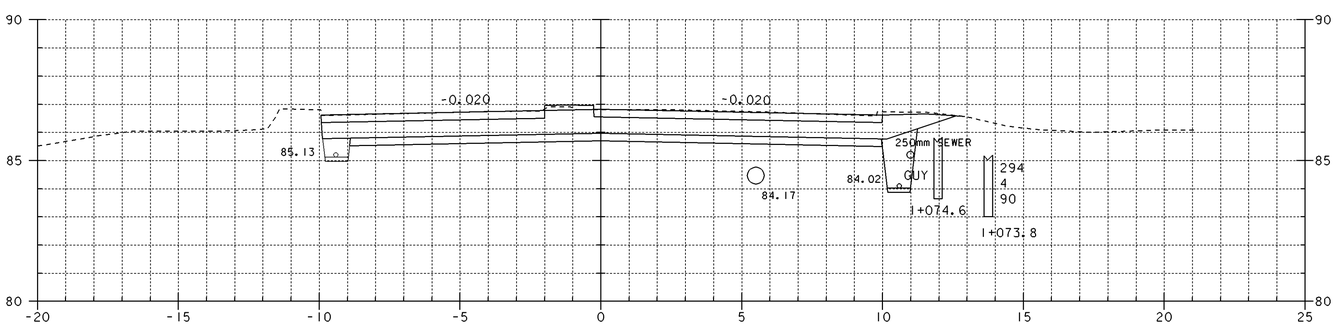

1+075

DATUM

VERTICAL _____

HORIZONTAL _____

0 2 4 6 8 10

SCALE 1:100

U.S. RTE. 5--SOUTH SECTION

PROJECT:	PROJECT NO.:
BRATTLEBORO	NH 2000(18)

DESIGN FILE NAME: /sadc/93d191/dd191xs3.dgn

IPARM FILE NAME: dd191x04.i

PLOT DATE: 8-APR-1999

SURVEYED BY: _____

SURVEY DATE: _____

SQUAD LEADER: MENARD

DRAWN BY: SQUAD C

SHEET: 55 OF 67