STATE OF VERMONT
AGENCY OF TRANSPORTATION

TRAFFIC SIGN SUMMARY SHEET

MILE MARKER, STATION, OR SIGN NUMBER	SIGN LEGEND	SIGN DIMENSIONS EA	SIGN DIMENSIONS WIDTH (IN)	SIGN DIMENSIONS HEIGHT (IN)	NEW & SALVAGED SIGNS "A"	NEW & SALVAGED SIGNS "B"	NEW & SALVAGED SIGNS SALV SIGN	NEW & SALVAGED SIGNS SALV TIS	EXIST POST RETAIN	EXIST POST SALVAGE	NEW SIGN POSTS NO. OF POSTS	FLANGED CHANNEL LB/FT 1.12	FLANGED CHANNEL LB/FT 2.0	FLANGED CHANNEL LB/FT 3.0	SQUARE STEEL (IN) 1.75 LB/FT 1.88	SQUARE STEEL (IN) 2.0 LB/FT 2.16	SQUARE STEEL (IN) 2.5 LB/FT 3.35	ANCHOR	SLEEVE	TUBULAR ALUMINUM Ø (IN) 3.0 LB/FT 1.3	TUBULAR ALUMINUM Ø (IN) 4.0 LB/FT 1.7	TUBULAR ALUMINUM Ø (IN) 4.0 MOD 1.7	FOUND-ATION	TUBULAR STEEL Ø (IN) 3.0 LB/FT 7.6	TUBULAR STEEL Ø (IN) 3.5 LB/FT 9.0	TUBULAR STEEL Ø (IN) 4.0 LB/FT 10.8	TUBULAR STEEL Ø (IN) 5.0 LB/FT 14.6	W-SHAPE STEEL FTG. SIZE 24"	W-SHAPE STEEL FTG. SIZE 30"	W-SHAPE STEEL WEIGHT	W-SHAPE STEEL POST SIZE	SIGN FRAME REQUIRED	REMARKS	SIGN DETAIL DETAIL ON SHEET NUMBER	SIGN DETAIL STD. SHEET NUMBER
												OPTION ITEMS																							
US ROUTE 4																																			
5+07 LT	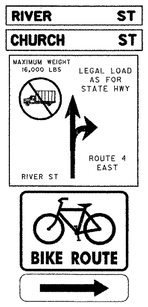	1 1 1 1 1					~~X~~ ~~X~~ X X X				1			X			~~X~~																	
5+09 LT		1 1 1 1					X X X X				1			X			~~X~~																	
9+45 RT		1	30	30	6.3						1			X			~~X~~																	E-143
												FT	FT	FT 45	FT	FT	FT ~~45~~		EA	LB	LB	LB		LB	LB	LB	LB								
												FT 45			FT ~~45~~					LB			EA.	LB				EA.	EA.	LB					
	TOTALS				SF 6.3	SF	EA. ~~9~~ 7	SF																											

FINAL POST LENGTHS ARE TO BE DETERMINED IN THE FIELD. POST SIZES ARE COMPUTED BASED ON INFORMATION FURNISHED ON THE STANDARD SHEETS AND THE TRAFFIC & SAFETY DIVISION'S "SIGN POST DESIGN GUIDELINE."

AVERAGE POST LENGTH = 15 FT

VHB Vanasse Hangen Brustlin, Inc.

STATE OF VERMONT
AGENCY OF TRANSPORTATION

Town Of WOODSTOCK	Bridge No. 50
Highway No. U.S. ROUTE 4	Log Sta. / Surv. Sta.
U.S. ROUTE 4 OVER OTTAUQUECHEE RIVER	
TRAFFIC SIGN SUMMARY SHEET	
Designed By B.J. MASSE	Drawn By B.J. MASSE
Checked By J.T. KLEIN Date 9/06	Bridge Design Supervisor M.A. COLGAN Date 9/06
PROJECT WOODSTOCK	PROJECT NO. BHF 020-2 (32)
I.G.C. Info.	
Bridge Sheet No. ZJ028TS2	Sheet 14 of 71

VHB NO. 51298 plot date: 9/14/2006