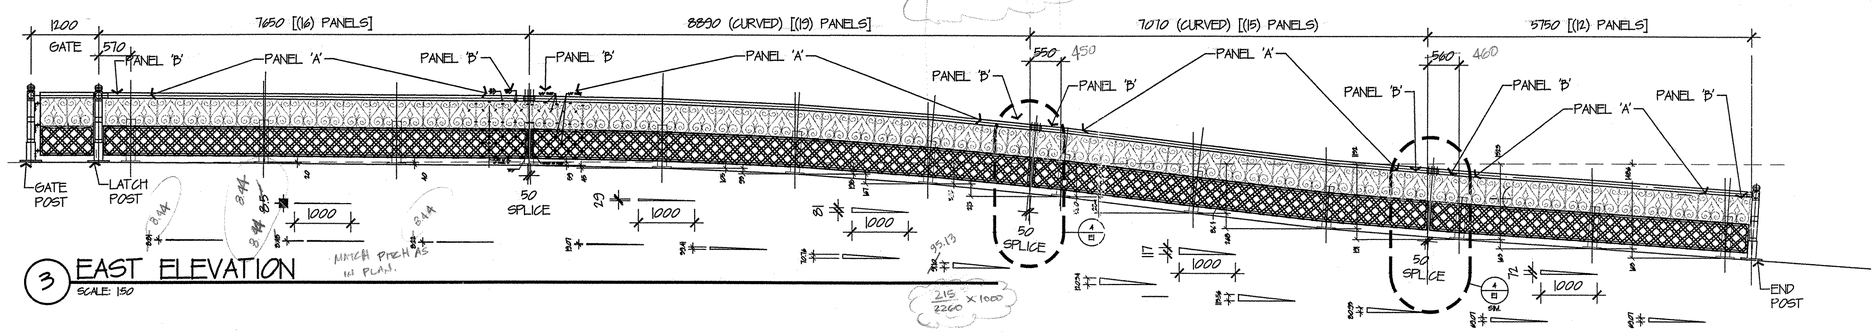

3 EAST ELEVATION
SCALE: 1:50

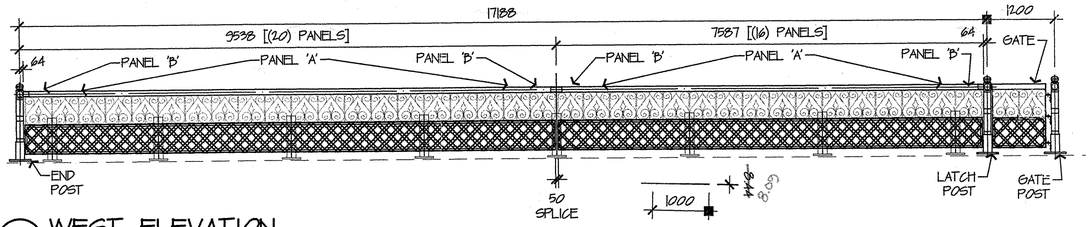

2 WEST ELEVATION
SCALE: 1:50

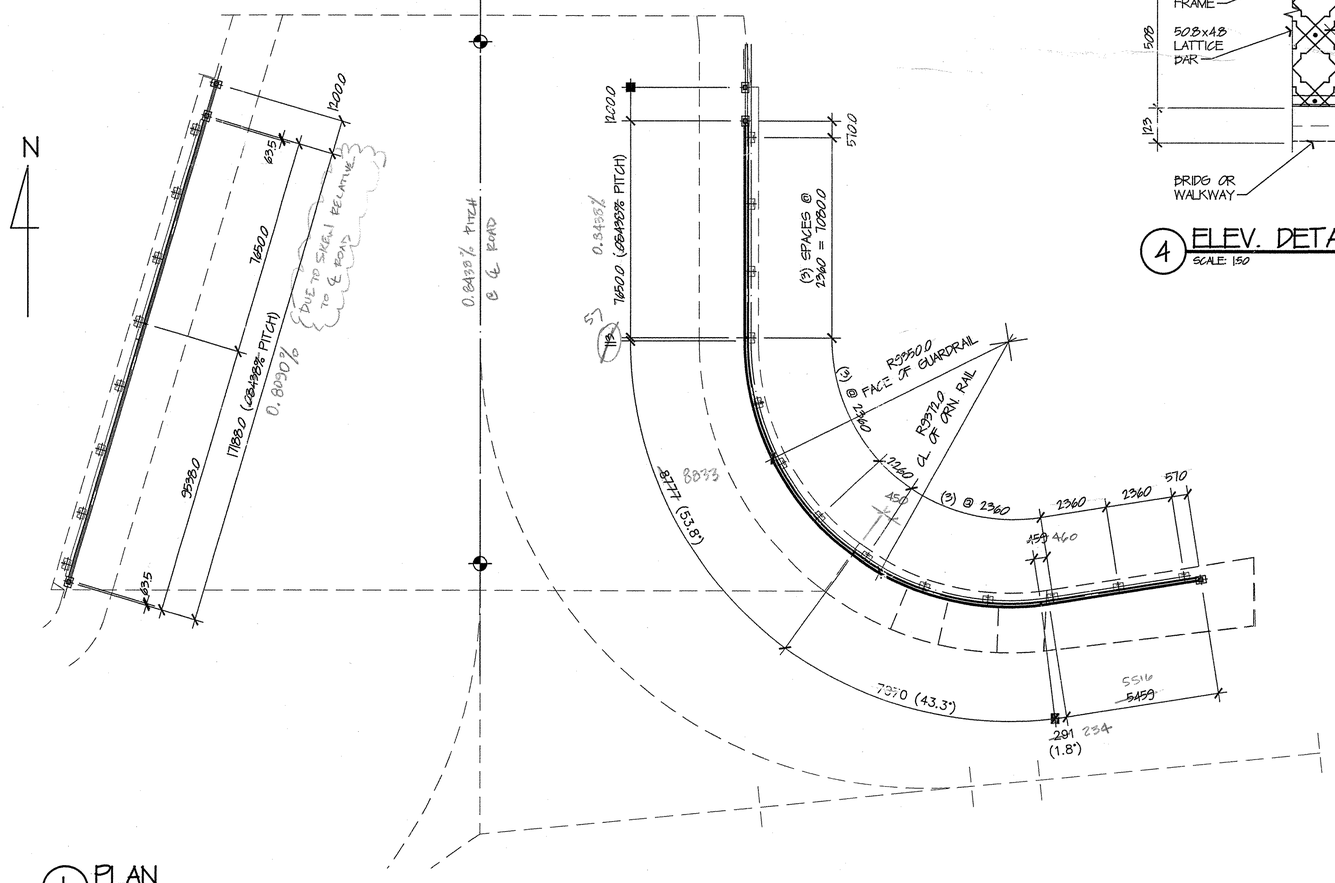

1 PLAN
SCALE: 1:50

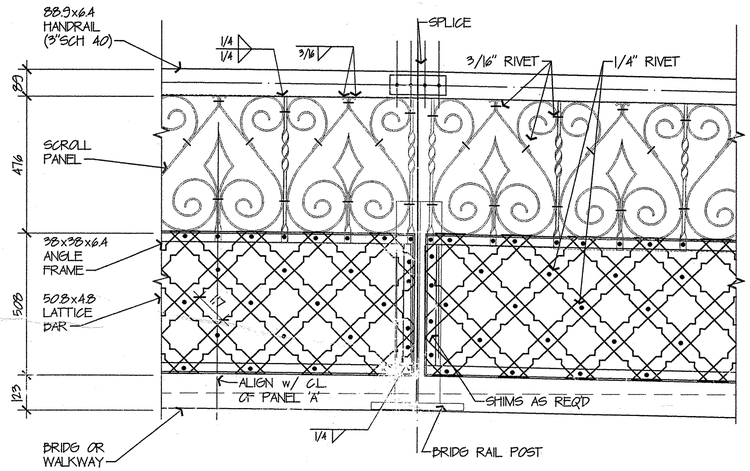

4 ELEV. DETAILS
SCALE: 1:50

NOTE:
1. ALL DETAILS AS PER SHTS 49, 50, & 51 OF DRAWINGS PREPARED BY THE STATE OF VERMONT, AGENCY OF TRANSPORTATION

FILE SET

RECEIVED
CK'D BY E Roy OK'D BY
SEP 08 2003
RESUBMIT APPROVED AS NOTED
BY RAU DATE 9-9-03

REVISIONS	REMARKS

ONE PRUYN'S ISLAND DR.
GLENS FALLS, N.Y. 12801

RIVERSIDE FAB, INC.

PHONE # 1(518) 798-3533
FAX # 1(518) 798-1711

DATE	8/28/03
DRAWN BY	CCE
CHK'D BY	
HOLES	
BOLTS	
PAINT	
SCALE	AS NOTED

PROJECT	PROPOSED IMPROVMENT BRIDGE PROJECT
LOCATION	BRATTLEBORO, VT.
CUSTOMER	RENAUD BROTHERS, INC.
ARCHITECT	STATE OF VERMONT, AGENCY OF TRANSPORTATION
JOB NO.	RFC 589
SHEET NAME	PLANS & ELEVATIONS

PRINT RECORD

DATE	NO.
	078

DRAWING NUMBER **E1**