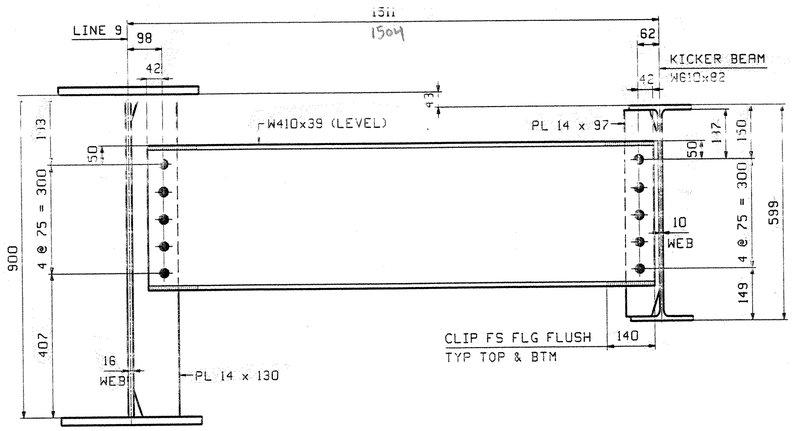

KICKER BEAM INT DIAPHRAGM

LOOKING UPSTATION

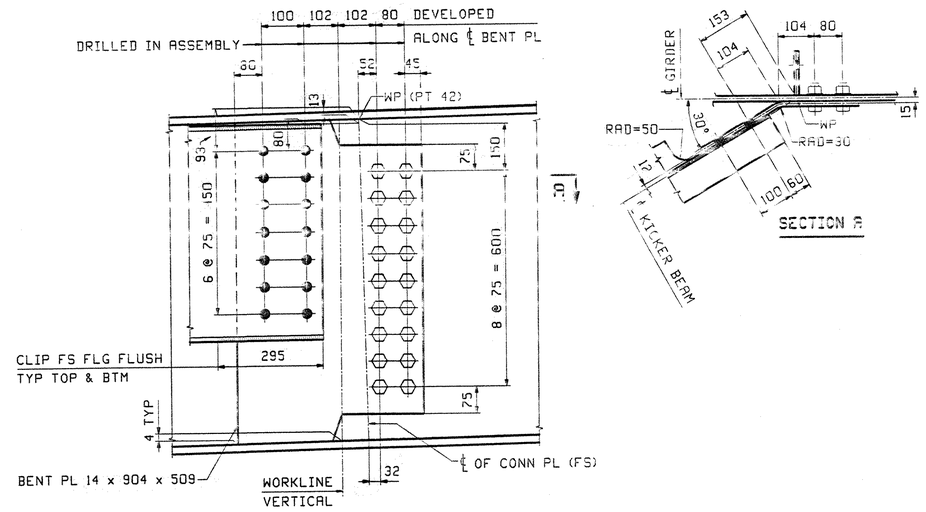

KICKER BEAM TO LINE 9 GIRDER CONNECTION

LOOKING WEST

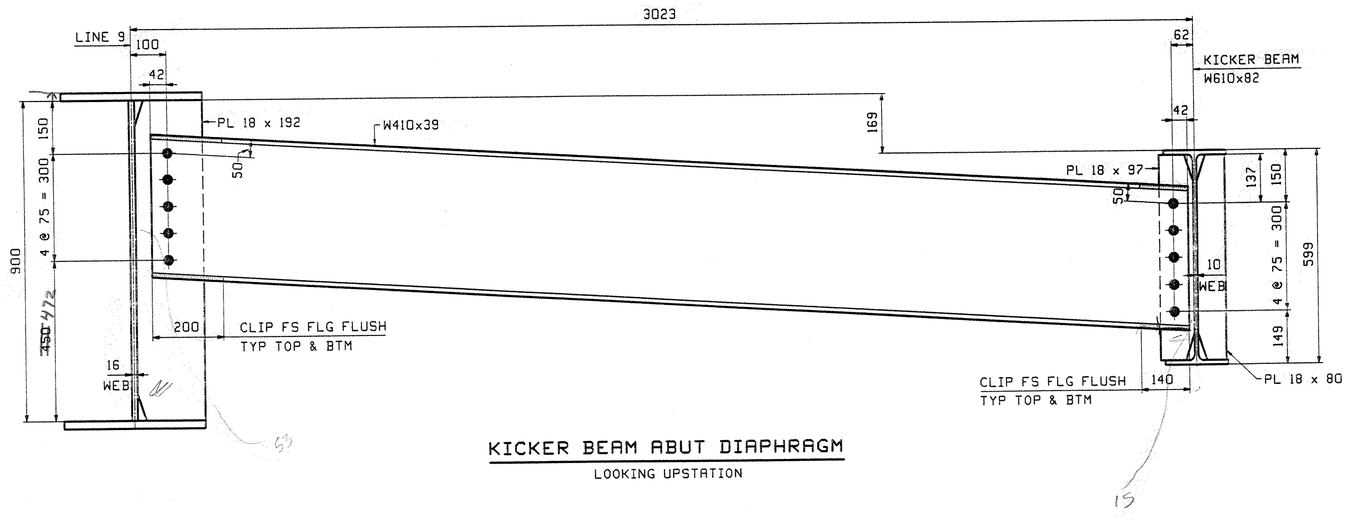

KICKER BEAM ABUT DIAPHRAGM

LOOKING UPSTATION

**** NOTE ****
THE PURPOSE OF THIS DRAWING IS TO COORDINATE GEOMETRIC CONTROL INFORMATION AND CONNECTION SPACING. THIS DWG IS SUBMITTED FOR INFORMATION ONLY & IS NOT INTENDED FOR SHOP FABRICATION. DETAIL DWGS WILL SHOW ALL WELDING AND DIMENSIONS REQ'D FOR FABRICATION.

V.A.O.T.
RECEIVED
CK'D BY SSS 4/16/03 OK'D BY JMR 4/25/03
APR 15 2003
RESUBMIT ____ APPROVED AS NOTED
BY ____ DATE

NOTES:

1. ALL MATERIAL TO BE M270 GR345W.
2. SHOP BOLTS TO BE 7/8"Ø A325 TYPE 3.

REV.	REMARKS	DATE	DWN	CHK	APP	Q.A.	NO.	DIA.	LGT	TYPE	WASHER
	OUT FOR APPROVAL	4/14/03									
	OUT FOR APPROVAL										
	ISSUED TO SHOP										
	FIELD & OFFICE										

MATERIAL: M270M-345W
ELECTRODES:
HOLES: 24mm ($\frac{15}{16}$")Ø
SHOP BOLTS:

SURFACE PREP. & PAINT:

-ALL STEEL SHALL BE BLAST CLEANED AND LEFT UNPAINTED.

DESCRIPTION: LAYOUTS

JOB: US 5 OVER WHETSTONE BROOK
BRIDGE NO. 7
BRATTLEBORO, VERMONT (WINDHAM COUNTY)
CONTRACTOR: RENAUD BROTHERS

TENSOR 2348

PROJ NO. BHF 2000(17)

CUSTOMER: VERMONT AGENCY OF TRANSPORTATION

	DRAWN BY	DATE
	JTB	03/18
	CHKD BY	
	WMJ	03/19
	APPROV BY	
	SUPERVISOR	W. J. GATTI
	Q.A.	
		086
	JOB NO.	DRG. NO.
	194	TD2
	REV.	△

CASCO BAY STEEL STRUCTURES, INC.
75 SPRING HILL ROAD SACO, MAINE 04072
PHONE (207) 282-7360 FAX. (207) 282-1179

WMJ Mon Mar 24 11:37:28 EST 2003 /users/jobs/2348/TD2.Rev0