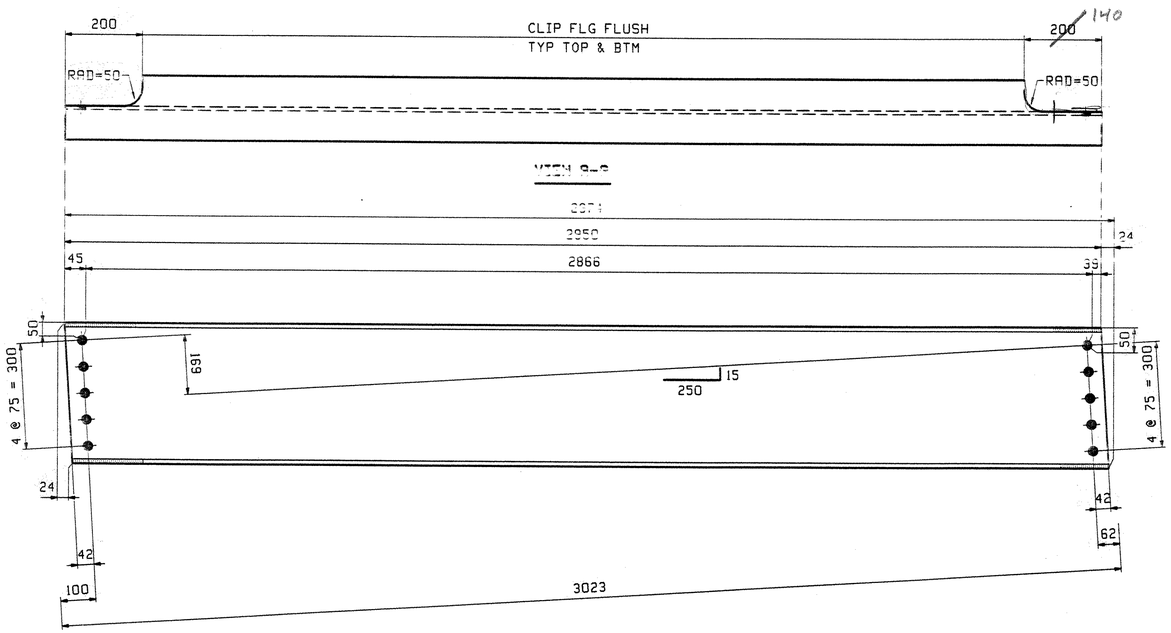

1 - END DIAPHRAGM - 13D1

ABM INFO		SHIP	BILL OF MATERIAL					JOB NO.	DRAWING NO.	REV.
									13	
PAGE	LINE	MARK	QTY	MARK	MATERIAL	LENGTH m	LENGTH mm	REMARKS	WT	PROCUREMENT NOTES
					END DIAPHRAGMS					
4	K	13D1	1		W 410x39	2	974		116 kg 255 lbs	

REV.	REMARKS	DATE	DWN	CHK	APP	Q.A.	NO.	DIA.	LGT	TYPE	WASHER
	OUT FOR APPROVAL	4/14/03									
	OUT FOR APPROVAL										
	ISSUED TO SHOP										
	FIELD & OFFICE										

MATERIAL: M270M-345W

ELECTRODES:

HOLES: 24mm ($\frac{15}{16}$")Ø

SHOP BOLTS:

SURFACE PREP. & PAINT:

-ALL STEEL SHALL BE BLAST CLEANED AND LEFT UNPAINTED.

DESCRIPTION: END DIAPHRAGM

JOB: US 5 OVER WHETSTONE BROOK
BRIDGE NO. 7
BRATTLEBORO, VERMONT (WINDHAM COUNTY)
CONTRACTOR: RENAUD BROTHERS

TENSOR 2348

PROJ NO. BHF 2000(17)

CUSTOMER: VERMONT AGENCY OF TRANSPORTATION

DRAWN BY	DATE
JTB	03/21
CHKD BY	
EPE	04/07
APPROV BY	
SUPERVISOR	W. J. GATTI
Q.A.	
103	

V.A.O.T.
RECEIVED
APR 15 2003

CK'D BY S.S.S. 4/21/03 OK'D BY SMP 4/21/03

RESUBMIT _____ APPROVED AS NOTED

BY DATE

CASCO BAY STEEL STRUCTURES, INC.
75 SPRING HILL ROAD SACO, MAINE 04072
PHONE (207) 282-7360 FAX. (207) 282-1179

JOB NO.	DRG. NO.
194	13
	REV. △

JTB Fri Mar 21 12:45:46 EST 2003 /home/jobs/2360/13.dwg