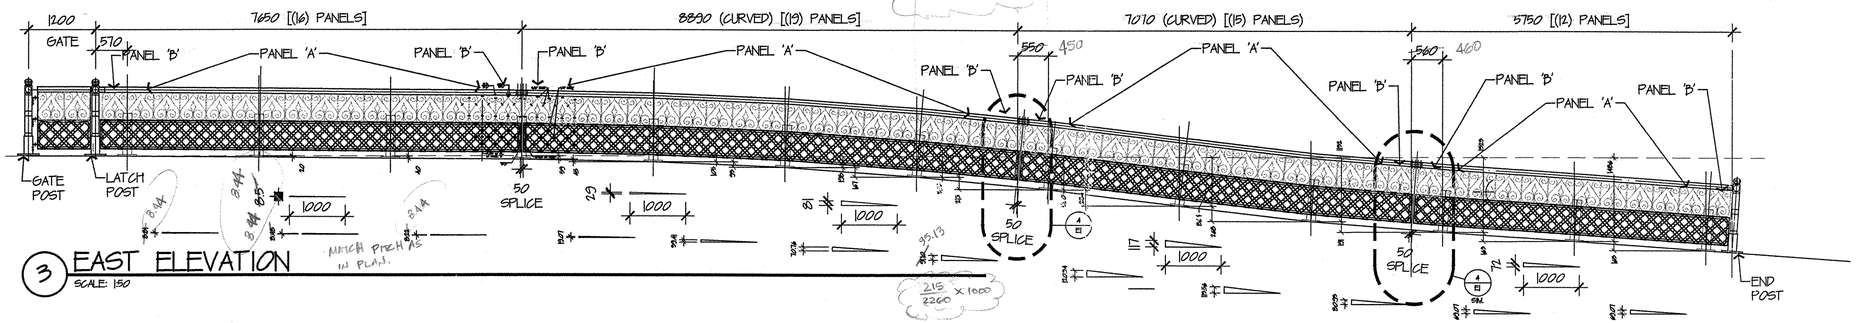

3 EAST ELEVATION
SCALE: 1:50

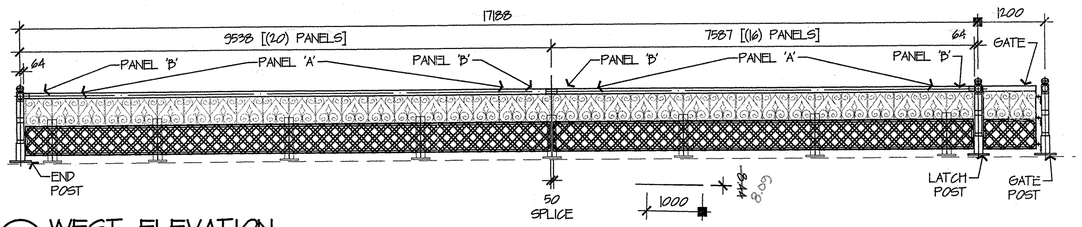

2 WEST ELEVATION
SCALE: 1:50

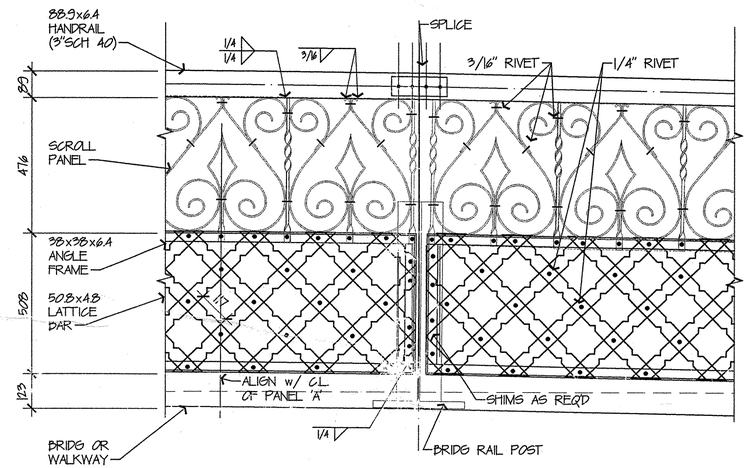

4 ELEV. DETAILS
SCALE: 1:50

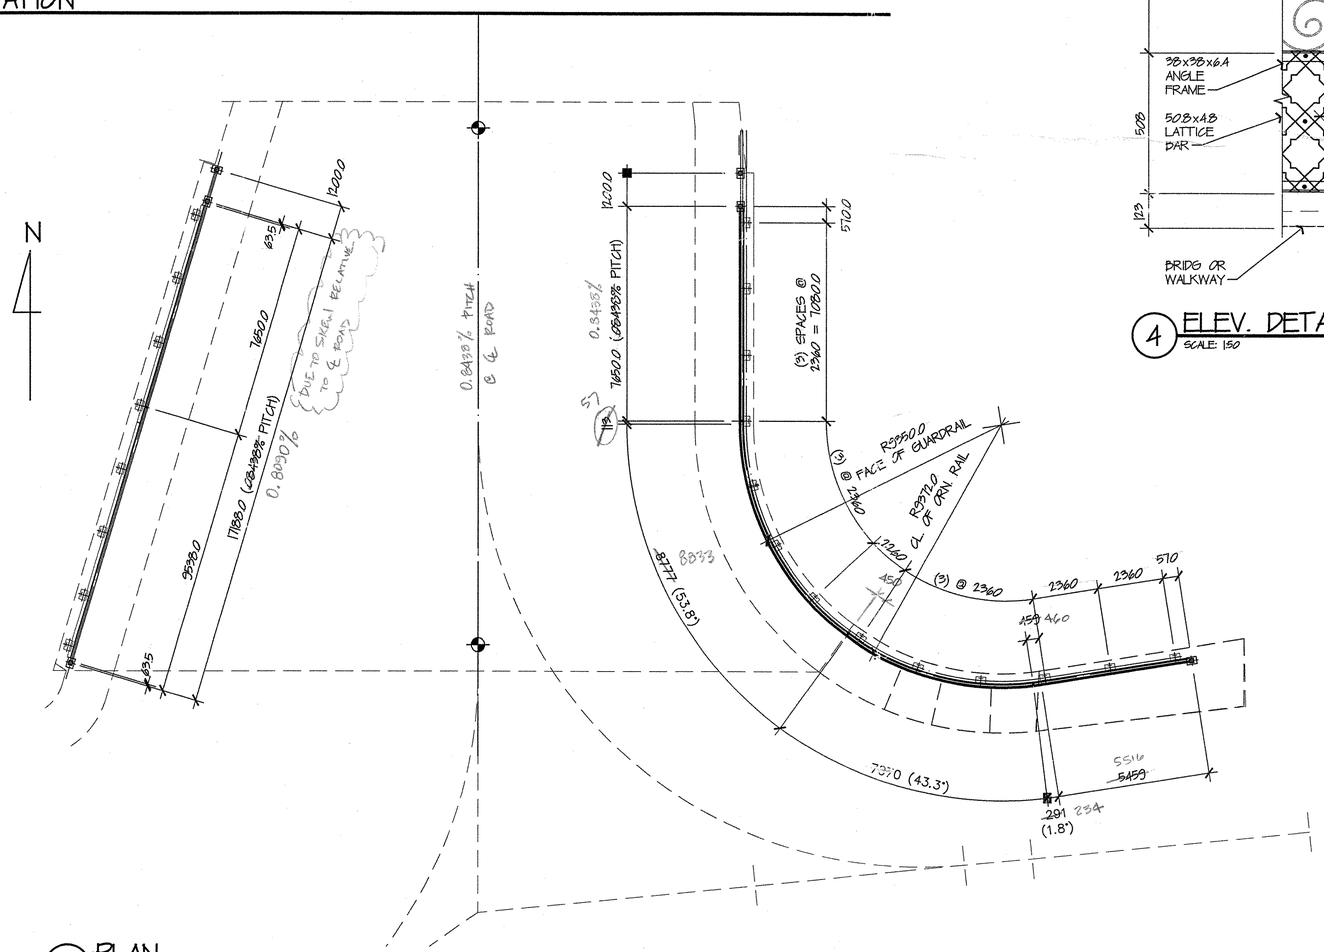

1 PLAN
SCALE: 1:50

NOTE:
1. ALL DETAILS AS PER SHTS 49, 50, & 51 OF DRAWINGS PREPARED BY THE STATE OF VERMONT, AGENCY OF TRANSPORTATION

— FILE SET —

RECEIVED
CK'D BY G.B.D. CK'D BY
2-3-03
SEP 08 2003
RESUBMIT ____ APPROVED AS NOTED
BY RKW DATE 9-9-03

REVISIONS	REMARKS

ONE PRUYN'S ISLAND DR.
GLENS FALLS, N.Y. 12801

RIVERSIDE FAB, INC.

PHONE # 1(518) 798-3533
FAX # 1(518) 798-1711

DATE	8/28/03	PROJECT	PROPOSED IMPROVMENT BRIDGE PROJECT
DRAWN BY	CCE	LOCATION	BRATTLEBORO, VT.
CHK'D BY		CUSTOMER	RENAUD BROTHERS, INC.
HOLES		ARCHITECT	STATE OF VERMONT, AGENCY OF TRANSPORTATION
BOLTS		JOB NO.	RFC 589
PAINT		SHEET NAME	PLANS & ELEVATIONS
SCALE	AS NOTED		

PRINT RECORD

DATE	NO.	
		078

DRAWING NUMBER **E1**