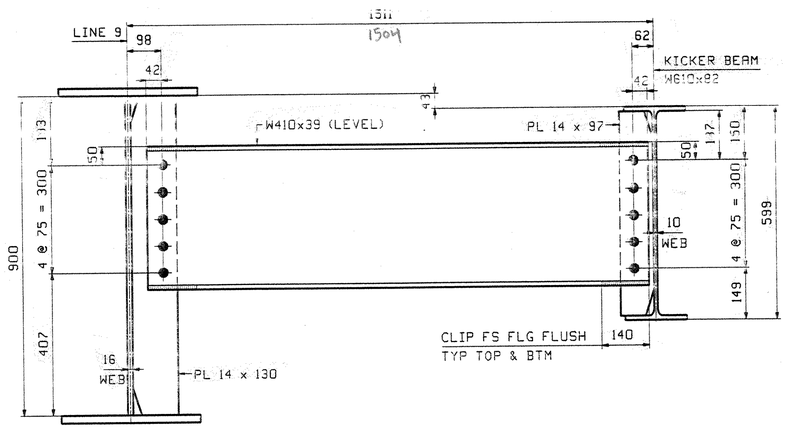

KICKER BEAM INT DIAPHRAGM

LOOKING UPSTATION

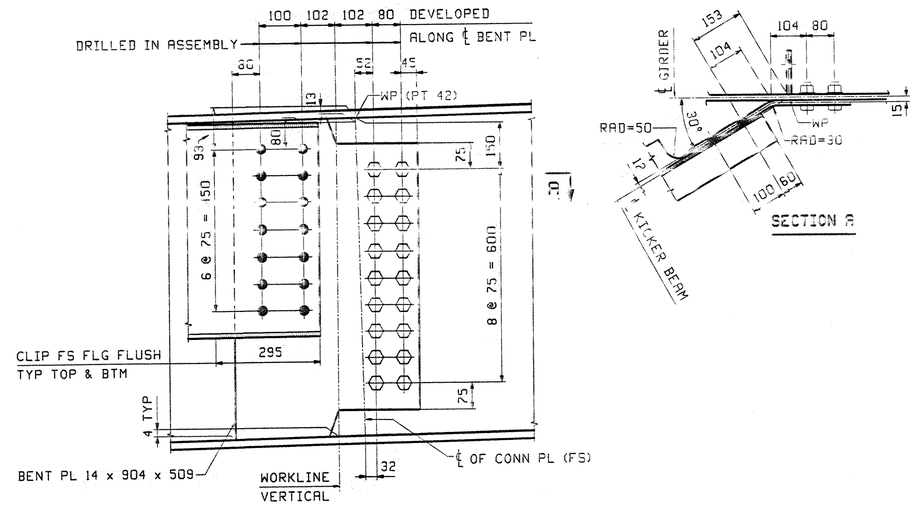

KICKER BEAM TO LINE 9 GIRDER CONNECTION

LOOKING WEST

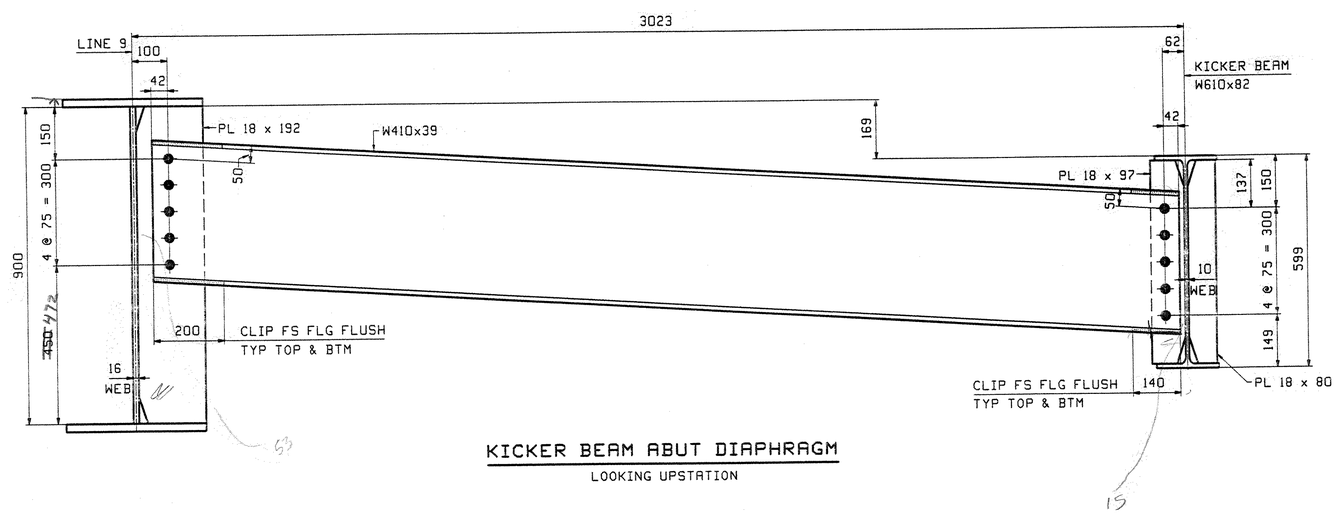

KICKER BEAM ABUT DIAPHRAGM

LOOKING UPSTATION

**** NOTE ****
THE PURPOSE OF THIS DRAWING IS TO COORDINATE GEOMETRIC CONTROL INFORMATION AND CONNECTION SPACING. THIS DWG IS SUBMITTED FOR INFORMATION ONLY & IS NOT INTENDED FOR SHOP FABRICATION. DETAIL DWGS WILL SHOW ALL WELDING AND DIMENSIONS REQ'D FOR FABRICATION.

V.A.O.T.
RECEIVED
CK'D BY S.S.S. 4/16/03 OK'D BY JNF 4/21/03
APR 15 2003
RESUBMIT ____ APPROVED AS NOTED
BY / DATE

NOTES:

1. ALL MATERIAL TO BE M270 GR345W.
2. SHOP BOLTS TO BE 7/8"Ø A325 TYPE 3.

REV.	REMARKS	DATE	DWN	CHK	APP	Q.A.	NO.	DIA.	LGT	TYPE	WASHER
	OUT FOR APPROVAL	4/14/03									
	OUT FOR APPROVAL										
	ISSUED TO SHOP										
	FIELD & OFFICE										

MATERIAL: M270M-345W
ELECTRODES:
HOLES: 24mm ($\frac{15}{16}$")Ø
SHOP BOLTS:

SURFACE PREP. & PAINT:

-ALL STEEL SHALL BE BLAST CLEANED AND LEFT UNPAINTED.

DESCRIPTION: LAYOUTS

JOB: US 5 OVER WHETSTONE BROOK
BRIDGE NO. 7
BRATTLEBORO, VERMONT (WINDHAM COUNTY)
CONTRACTOR: RENAUD BROTHERS

TENSOR 2348

PROJ NO. BHF 2000(17)

CUSTOMER: VERMONT AGENCY OF TRANSPORTATION

DRAWN BY	DATE
JTB	03/18
CHKD BY	
WMJ	03/19
APPROV BY	
SUPERVISOR	W. J. GATTI
Q.A.	
	086
JOB NO.	DRG. NO.
194	TD2
	REV. △

CASCO BAY STEEL STRUCTURES, INC.
75 SPRING HILL ROAD SACO, MAINE 04072
PHONE (207) 282-7360 FAX. (207) 282-1179