NOTE: THIS ROAD WAS LOCATED AT 05.232 IN THE FIELD BUT THE ROUTE LOGS SHOW IT AT 05.209.

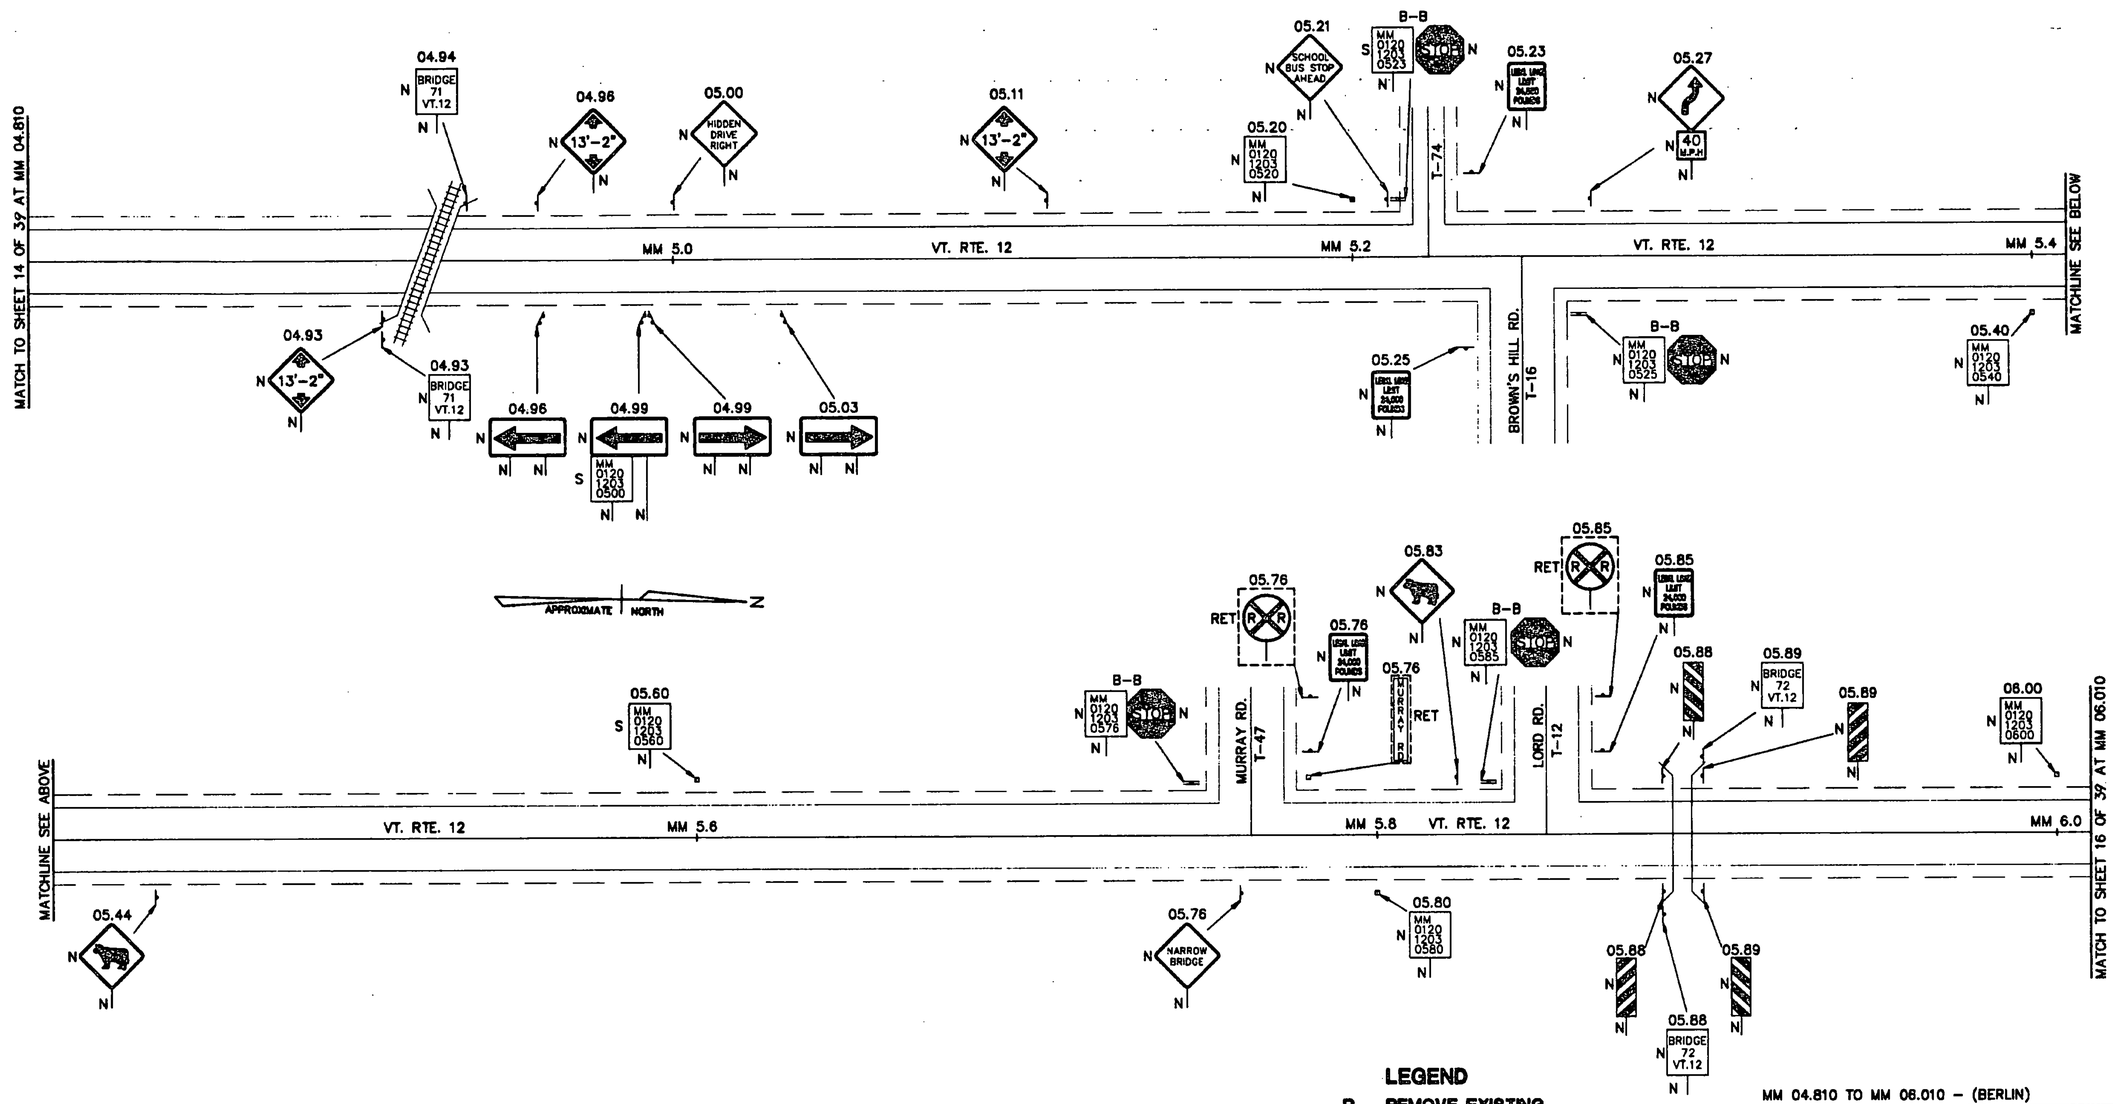

MM 04.810 TO MM 06.010 – (BERLIN)

LEGEND

R	REMOVE EXISTING
N	NEW
RET	RETAIN
R&S	REMOVE AND SALVAGE
S	SALVAGED
B-B	BACK TO BACK

NOT TO SCALE

DATUM
VERTICAL N/A
HORIZONTAL N/A

NEW SIGNS VI

SURVEYED BY SJB/JHF DATE 9/93
DRAWN BY SAM DATE 9/93
SQUAD LEADER SJB
DESIGN FILE NO.
IPARM FILE DATE PLOTTED
PROJ. NAME NORTHFIELD–BERLIN
PROJ. NO. STP SIGN 9487
SHEET 15 OF 38 SHEETS