CONSTRUCTION APPROACH SIGNING

SEE STD. E-100 FOR SIGN PLACEMENT

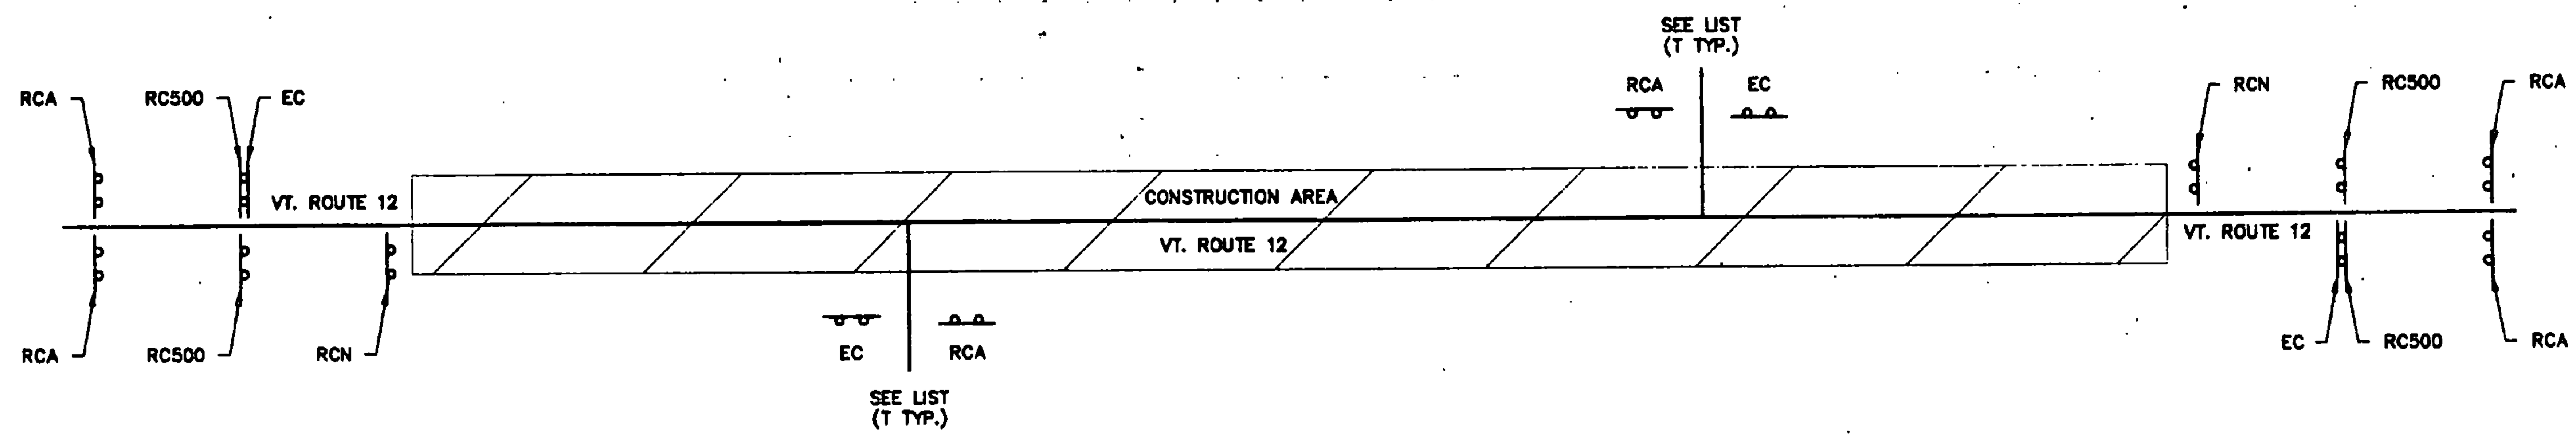

LIST OF TOWN ROADS/HIGHWAYS
FOR CONSTRUCTION SIGNS

TOWN HIGHWAY NUMBER	ROAD CONST. AHEAD	END CONST.	OTHER
NORTHFIELD			
T-14	1	1	
T-16	1	1	
T-17	1	1	
TH-3	1	1	
T-83	1	1	
T-85	1	1	
T-83	1	1	
T-84	1	1	
T-86	1	1	
BERLIN			
T-55	1	1	
T-61	1	1	
T-77	1	1	
T-71	1	1	
T-54	1	1	
SUBTOTAL	14	14	

LIST OF TOWN ROADS/HIGHWAYS
FOR CONSTRUCTION SIGNS

TOWN HIGHWAY NUMBER	ROAD CONST. AHEAD	END CONST.	OTHER
T-48	1	1	
T-40	1	1	
T-54	1	1	
T-53	1	1	
T-35	1	1	
T-49	1	1	
T-38	1	1	
T-39	1	1	
T-74	1	1	
T-16	1	1	
T-47	1	1	
T-12	1	1	
TH-8	1	1	
SUBTOTAL	13	13	
TOTAL	27	27	

RCA = ROAD CONSTRUCTION AHEAD
RC500 = ROAD CONSTRUCTION 500'
EC = END CONSTRUCTION
RCN = ROAD CONSTRUCTION NEXT 7.25 MILES
SRCA = SIDE ROAD CONSTRUCTION AHEAD
SRC500 = SIDE ROAD CONSTUCTION 500'
T = TOWN ROAD
TH = TOWN HIGHWAY

DATUM
VERTICAL N/A
HORIZONTAL N/A

NOT TO SCALE

CONSTRUCTION APPROACH SIGNING

SURVEYED BY SJB/JHF DATE N/A
DRAWN BY TLB DATE 12/93
SQUAD LEADER SJB
DESIGN FILE NO.
IPARM FILE DATE PLOTTED
PROJ. NAME NORTHFIELD-BERLIN
PROJ. NO. STP SIGN 9487
SHEET 39 OF 39 SHEETS