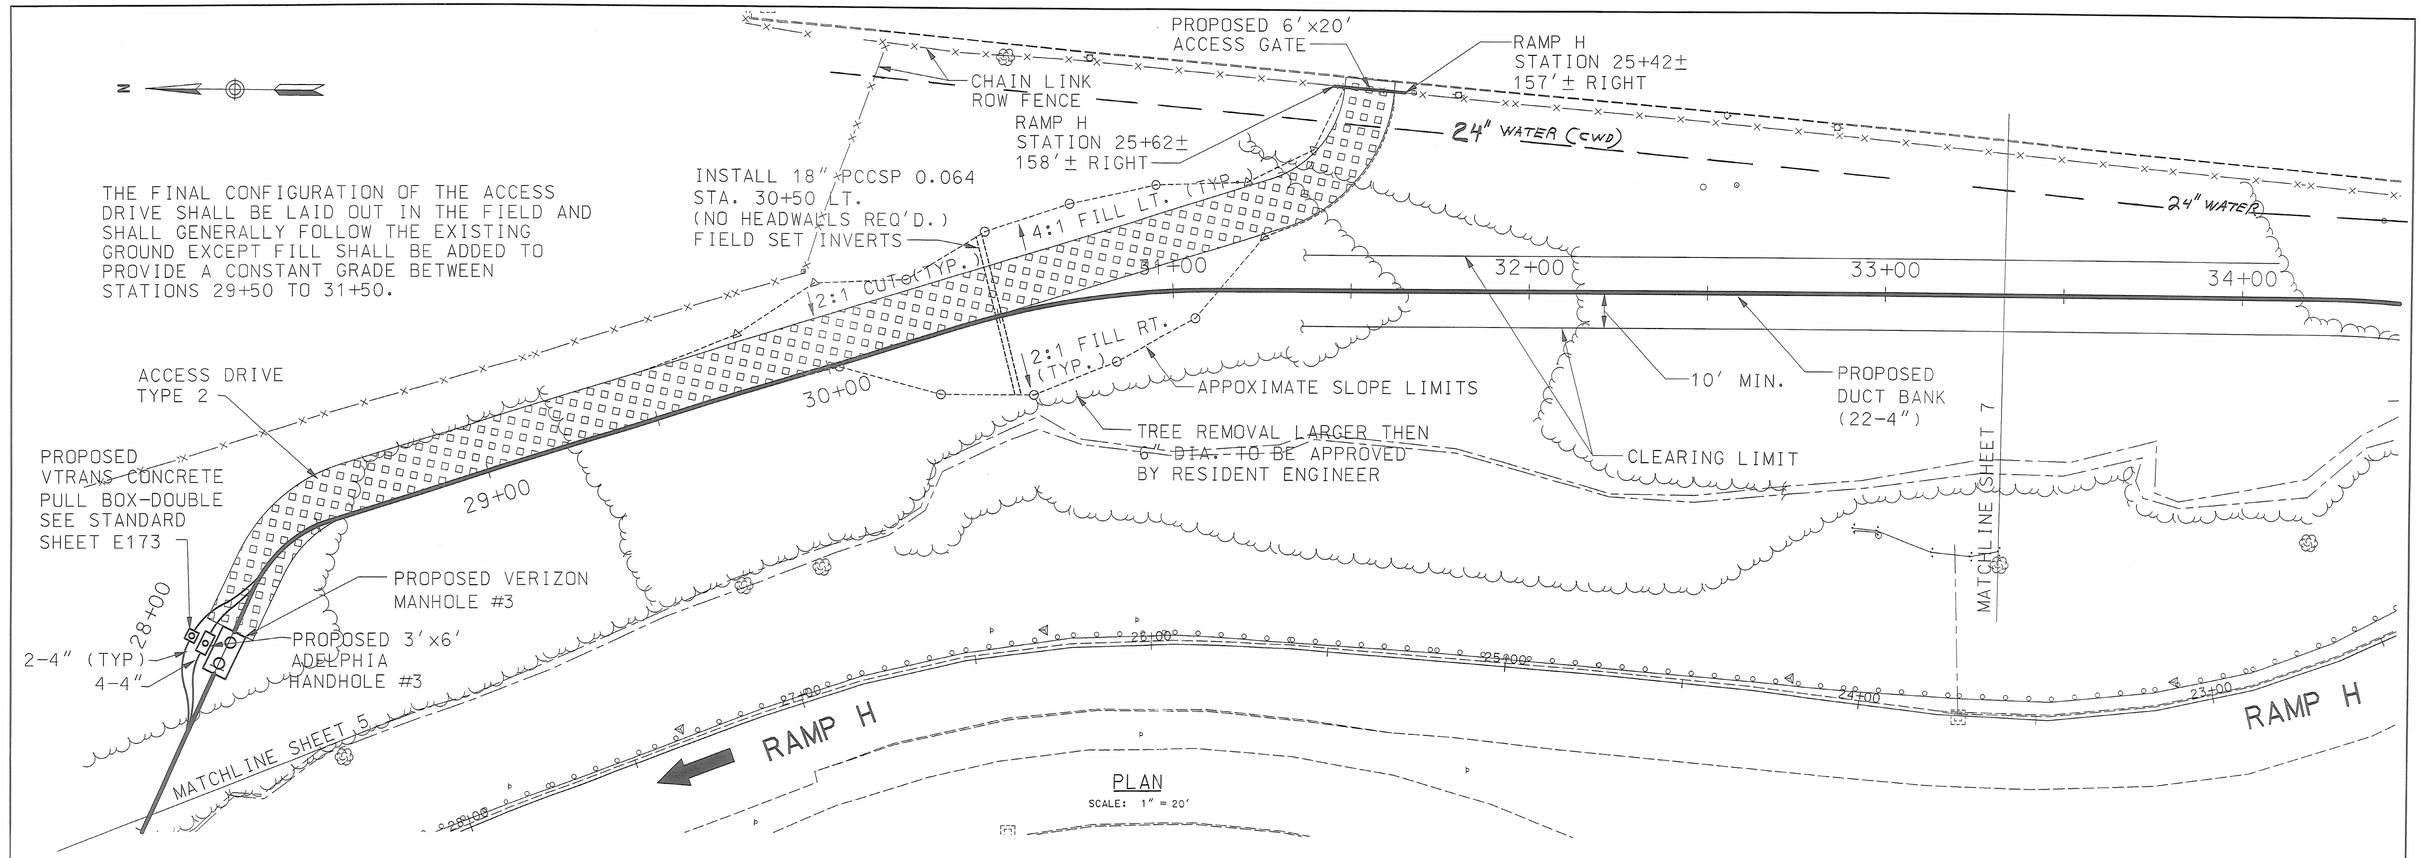

STATE OF VERMONT
AGENCY OF TRANSPORTATION

Town Of SOUTH BURLINGTON	Bridge No. 68
Highway No. U.S. 2	Log Sta. / Surv. Sta.
U.S. 2 OVER I-89	
TELECOMMUNICATIONS RELOCATION	
Designed By M. HAYES	Drawn By M. HAYES
Checked By Date	Bridge Design Supervisor S. JOHNSON Date
PROJECT SOUTH BURLINGTON	PROJECT NO. IM DECK (36)
I.G.C. Info. VTRANS-GEN	Date 10/31/01
Bridge Sheet No. TD 7 OF 8	Sheet 59G of 75

VANASSE HANGEN BRUSTLIN, INC.