ABM INFO		SHOP BILL							JOB NO. 112	DRG. NO. S1
PAGE	LINE	NO.	DESCRIPTION	FT	IN	ASSEM. MARK	SHIPPING MARK	REMARKS		WEIGHT
		1	MC18x42.7	6	2		D2			
		10	7/8"φ A325 BOLTS GALV.		2¼		FIELD	W/NEW		

PAY ITEM 506.60

OUT FOR APPROVAL	7-6-00									
OUT FOR APPROVAL final	1-23-01									
ISSUED TO SHOP										
FIELD & OFFICE										
1 APPROV. COMMENTS										
REV.	REMARKS	DATE	DWN	CHK	APP	Q.A.	NO.	DIA.	LGT	TYPE	WASHER

PROJECT NO. IM DECK (36) STATE BRIDGE NO. 68

MATERIAL AASHTO M270-Gr36 ELECTRODES: — HOLES: 15/16"φ SHOP BOLTS: —

SURFACE PREP. & PAINT:

1 SHOP COAT - PRIMER PER SUPL SPEC. 513

DESCRIPTION: NEW DIAPHRAGMS

JOB: U.S. 2 OVER I-89 SOUTH BURLINGTON, VT.

CUSTOMER: J.A. McDONALD

DRAWN BY	JPF
DATE	9-00
CHKD BY	
APPROV BY	
Q.A.	
JOB NO.	112
DRG. NO.	S1
REV.	1

CASCO BAY STEEL STRUCTURES, INC.
75 SPRING HILL ROAD SACO, MAINE 04072
PHONE (207) 282-7360 FAX. (207) 282-1179

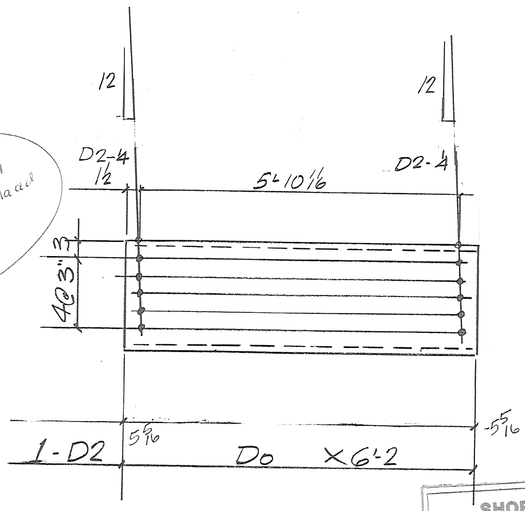

Consultant Engineer on 3/9/01 only one diaphragm is to be replaced

SHOP DRAWING REVIEW

☐ REVIEWED AS REQUIRED BY THE CONSTRUCTION CONTRACT DOCUMENTS AND APPROVED, BUT ONLY FOR CONFORMANCE TO THE DESIGN CONCEPT OF THE WORK, AND SUBJECT TO FURTHER LIMITATIONS AND REQUIREMENTS CONTAINED IN THE CONSTRUCTION CONTRACT DOCUMENTS.

☐ REVISE AND RESUBMIT ☑ FURNISH AS CORRECTED

☐ REJECTED

CORRECTIONS OR COMMENTS MADE ON THE SHOP DRAWINGS DURING THIS REVIEW DO NOT RELIEVE CONTRACTOR FROM COMPLIANCE WITH REQUIREMENTS OF THE DRAWINGS AND SPECIFICATIONS. THIS CHECK IS ONLY FOR REVIEW OF GENERAL CONFORMANCE WITH THE INFORMATION GIVEN DESIGN CONCEPT OF THE PROJECT AND GENERAL COMPLIANCE WITH THE INFORMATION GIVEN IN THE CONTRACT DOCUMENTS. THE CONTRACTOR IS RESPONSIBLE FOR CONFIRMING AND CORRELATING ALL QUANTITIES AND DIMENSIONS; SELECTING FABRICATION PROCESSES AND TECHNIQUES OF CONSTRUCTION; COORDINATING HIS WORK WITH THAT OF ALL OTHER TRADES; AND PERFORMING HIS WORK IN A SAFE AND SATISFACTORY MANNER.

VHB Vanasse Hangen Brustlin, Inc. Engineers, Planners, and Scientists Six Bedford Farms Drive, Inc. Bedford, NH 03102 603 644 0888

Job Number: 50934
Reviewed By: ASK
Date: 3/27/01