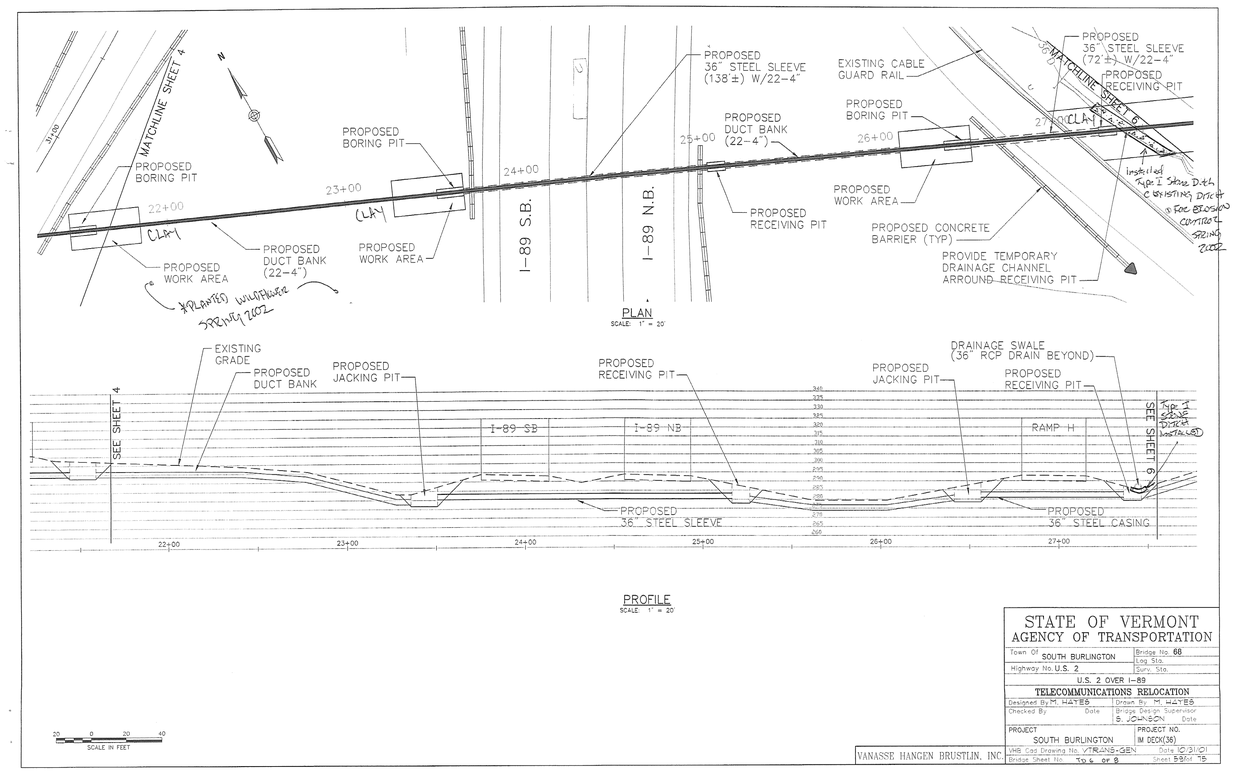

STATE OF VERMONT
AGENCY OF TRANSPORTATION

Town Of SOUTH BURLINGTON	Bridge No. 68
Highway No. U.S. 2	Log. Sta. / Sym. Sta.
U.S. 2 OVER I-89	
TELECOMMUNICATIONS RELOCATION	
Designed By M. HAYES	Drawn By M. HAYES
Checked By / Date	Bridge Design Supervisor S. JOHNSON / Date
PROJECT SOUTH BURLINGTON	PROJECT NO. M D20(36)
VHB Cad Drawing No. VTRANS-GEN	Date 10/31/01
Bridge Sheet No. To 4 of 8	Sheet 5 of 7B

VANASSE HANGEN BRUSTLIN, INC.