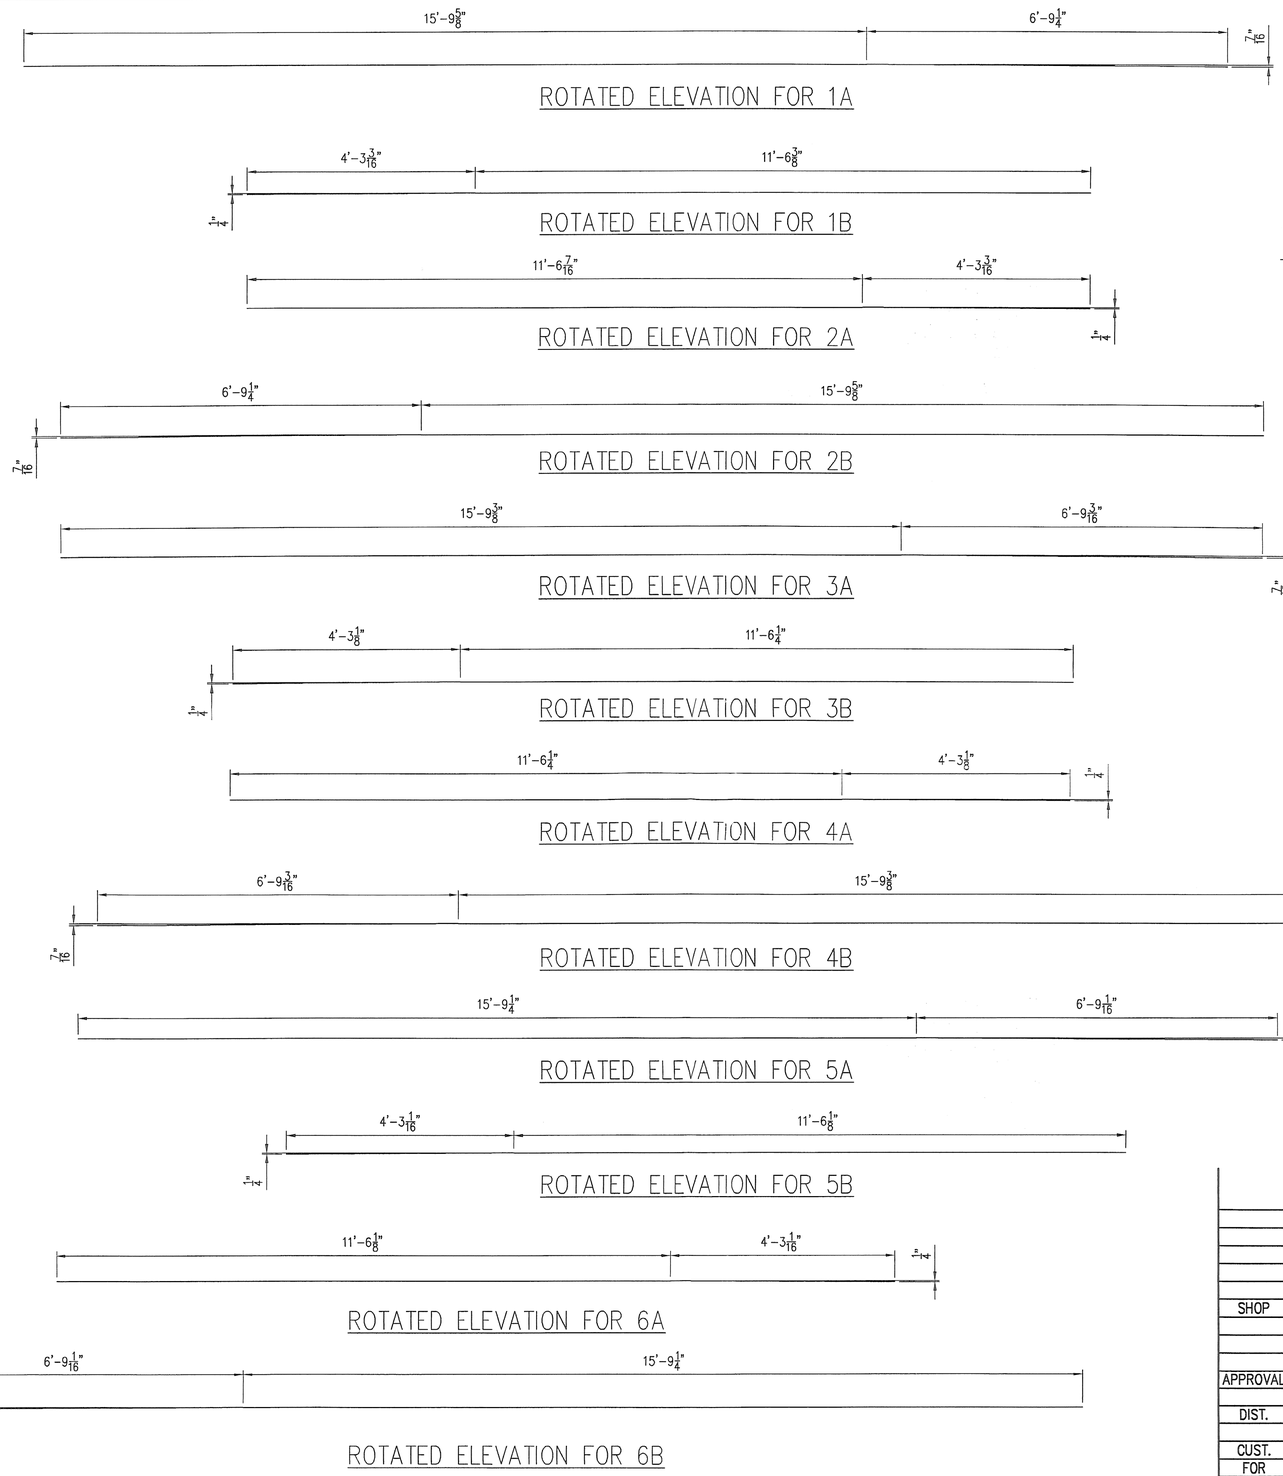

THIS SHEET IS FOR SHOP USE ONLY

SHOP NOTE:
ALL DIMENSIONS ARE GIVEN ALONG ℄ OF JOINT.

SHOP DRAWING REVIEW

☑ REVIEWED AS REQUIRED BY THE CONSTRUCTION CONTRACT DOCUMENTS AND APPROVED, BUT ONLY FOR CONFORMANCE TO THE DESIGN CONCEPT OF THE WORK, AND SUBJECT TO FURTHER LIMITATIONS AND REQUIREMENTS CONTAINED IN THE CONSTRUCTION CONTRACT DOCUMENTS.

☐ REJECTED ☐ REVISE AND RESUBMIT ☐ SUBMIT AS SPECIFIED

CORRECTIONS OR COMMENTS MADE ON SHOP DRAWINGS DURING REVIEW DO NOT RELIEVE CONTRACTOR FROM COMPLIANCE WITH CONTRACT DRAWINGS AND SPECIFICATIONS. THIS REVIEW IS ONLY FOR CONFORMANCE WITH THE DESIGN CONCEPT OF THE PROJECT AND COMPLIANCE WITH THE INFORMATION GIVEN IN THE CONTRACT DOCUMENTS. CONTRACTOR IS RESPONSIBLE FOR CONFIRMING AND CORRELATING ALL QUANTITIES AND DIMENSIONS, FABRICATION PROCESSES AND TECHNIQUES OF CONSTRUCTION, INSTALLATION AND COORDINATION OF THE WORK WITH ALL OTHER TRADES, AND PERFORMING WORK IN A SAFE MANNER.

VHB Vollmuth Hangen Brickman, Inc.
Engineers Planners Scientists
Buildings Parks Roads
Bedford, NH 03102 603-644-2888

Job Number: 50929
Reviewed By: ASR
Date: 2/24/01

REV.	DESCRIPTION	DATE	BY

ANY AND ALL BACKCHARGES WILL BE REJECTED UNLESS WRITTEN CONSENT IS GIVEN BY LEWIS ENGINEERING COMPANY PRIOR TO ANY WORK PERFORMED FOR OUR ACCOUNT. SUCH REJECTION MEANS THAT INVOICES WILL NOT BE HONORED OR DEDUCTIONS FROM PAYMENT WILL BE CHARGED BACK.

LEWIS ENGINEERING COMPANY
4201 NOREX DRIVE – CHASKA, MINNESOTA 55318 – (612) 368-3000

PROJECT	—	BRIDGE NO. 68 SOUTH BURLINGTON U.S. 2 OVER I-89
STATE PROJECT	—	IM DECK (36)
FEDERAL PROJECT	—	
CUSTOMER	—	J A McDONALD
LOCATION	—	CHITTENDEN COUNTY, VERMONT
DESCRIPTION	—	EXPANSION JOINT DETAILS

W.P. chk'd NR
Drawn By SL
Chk'd. By AS
Date: 11/21/00

SHEET NO. 8 OF 8 | Job. No. : 978.104.1

SHOP	
APPROVAL	
DIST.	
CUST.	
FOR PRINTS ISSUED	DATE