CURVE #7
DELTA = 53°27'54"
D = 8°40'52" (1) D = 12°11'26" (2)
R = 660.00' (1) R = 470.00' (2)
T = 281.10' (1) T = 244.78' (2)
L = 172.79' (1) L = 315.53' (2)
BANKING 0.08 FT/FT , 0.08 FT/FT
RUNOFF 180', 180' (45 MPH)
SEE SUPERELEVATION DIAGRAMS
FOR BANKING INFORMATION

RELOCATE MAILBOX, SINGLE SUPPORT
STA. 513+36 RT

DURABLE 4 INCH WHITE LINE (SEE OPTION ITEMS)
STA. 511+50 - STA. 517+25 (SOLID LT & RT)

TEMPORARY 4 INCH WHITE LINE, PAINT
STA. 511+50 - STA. 517+25 (SOLID LT & RT)

DURABLE 4 INCH YELLOW LINE (SEE OPTION ITEMS)
STA. 511+50 - STA. 511+75 (DASHED LT, SOLID RT)
STA. 511+75 - STA. 517+25 (SOLID LT & RT)

TEMPORARY 4 INCH YELLOW LINE, PAINT
STA. 511+50 - STA. 511+75 (DASHED LT, SOLID RT)
STA. 511+75 - STA. 517+25 (SOLID LT & RT)

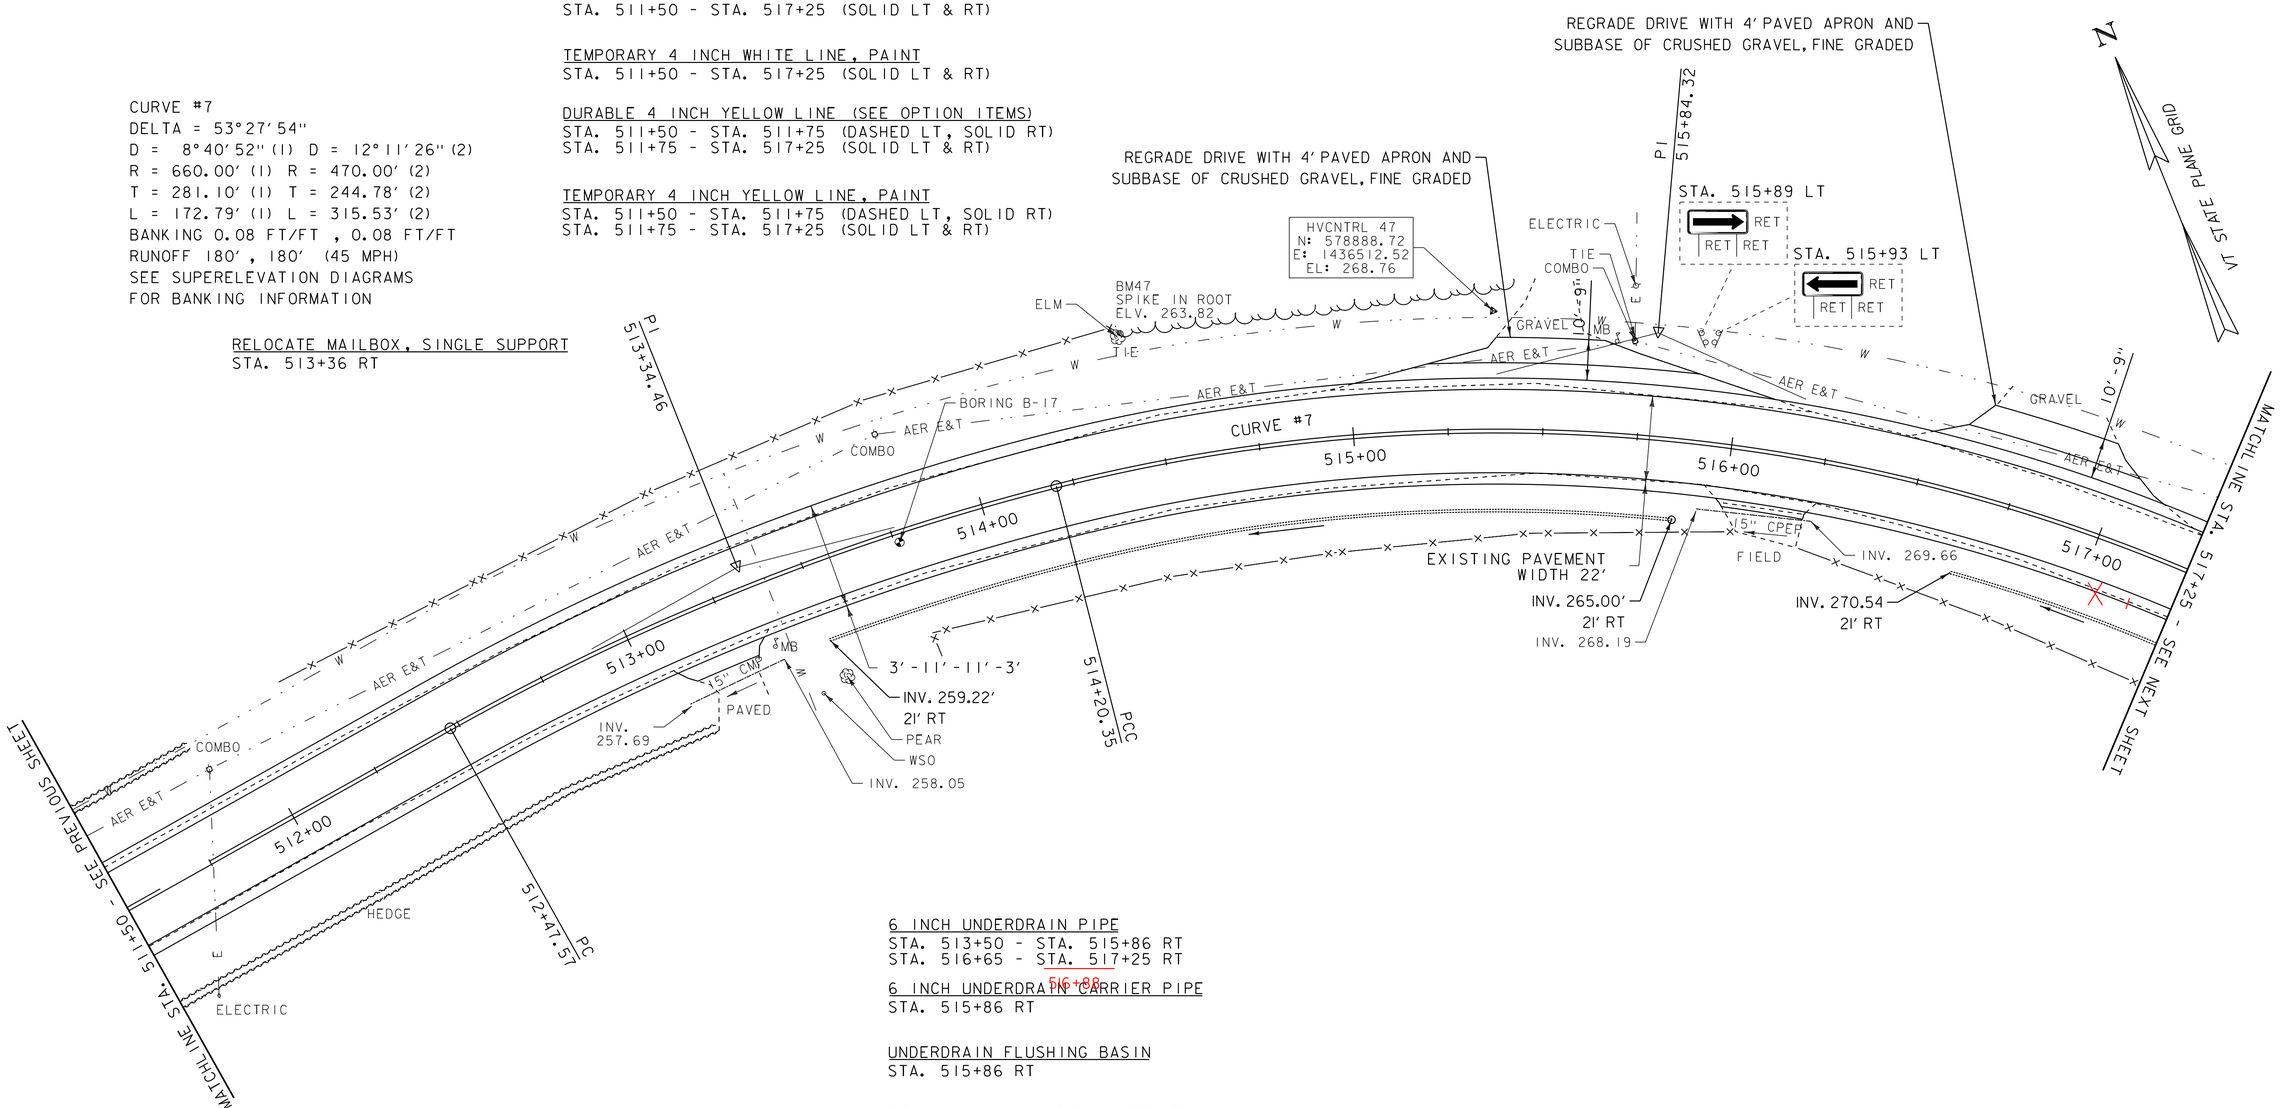

6 INCH UNDERDRAIN PIPE
STA. 513+50 - STA. 515+86 RT
STA. 516+65 - STA. 517+25 RT

6 INCH UNDERDRAIN CARRIER PIPE
STA. 515+86 RT

UNDERDRAIN FLUSHING BASIN
STA. 515+86 RT

REMOVING AND RESETTING FENCE
STA. 515+82 - STA. 516+04 RT

LEGEND
- SIGN
- HYDRANT
- MANHOLE
- GATE VALVE
- GAS PIPELINE MARKER
- CATCH BASIN / DROP INLET
- CURB INLET
- BORING LOCATION
- MAILBOX
- UTILITY POLE
- FLUSHING BASIN

SIGN LEGEND
R = REMOVE
R&S = REMOVE AND SALVAGE
RET = RETAIN
S = SALVAGE
N = NEW
B-B = BACK TO BACK

SCALE 1" = 20'-0
20 0 20

DATUM
NAVD 88
NAD 83

PROJECT LAYOUT SHEET 13

PROJECT NAME: ADDISON - NEW HAVEN
PROJECT NUMBER: STP 9632(1)

FILE NAME: p95B076.dgn
PROJECT LEADER: CDL
DESIGNED BY: SJL
PLOT FILE: p95B076_36.i
PLOT DATE: 3/13/2012
DRAWN BY: SJL
CHECKED BY: EPD
SHEET 36 OF 186