~~STEEL BEAM GUARDRAIL, GALVANIZED W/8 FEET POSTS~~
~~STA. b 43+60.5 - STA. b 44+16.75 LT~~
~~STA. b 44+41.75 - STA. b 45+73 LT~~

~~STEEL BEAM GUARDRAIL, GALVANIZED/NESTED W/8 FEET POSTS~~
~~STA. b 44+16.75 - STA. b 44+41.75 LT~~

~~ANCHOR FOR STEEL BEAM RAIL~~
~~STA. b 43+60.5 LT~~
~~STA. b 45+73 LT~~

DURABLE 4 INCH WHITE LINE (SEE OPTION ITEMS)
STA. b 42+75 - STA. b 48+50 (SOLID LT & RT)
(WITH EDGELINE BREAKS AT TH #24)
STA. b 46+75 RT (EDGELINES TH #24)

TEMPORARY 4 INCH WHITE LINE, PAINT
STA. b 42+75 - STA. b 48+50 (SOLID LT & RT)
(WITH EDGELINE BREAKS AT TH #24)
STA. b 46+75 RT (EDGELINES TH #24)

DURABLE 24 INCH STOP BAR (SEE OPTION ITEMS)
STA. b 46+78 - STA. b 47+03 RT (TH #24)

DURABLE LETTER OR SYMBOL (SEE OPTION ITEMS)
STA. b 46+89 RT "STOP" (TH #24)

TEMPORARY 24 INCH STOP BAR, PAINT
STA. b 46+78 - STA. b 47+03 RT (TH #24)

TEMPORARY LETTER OR SYMBOL, PAINT
STA. b 46+89 RT "STOP" (TH #24)

6 INCH UNDERDRAIN PIPE
STA. b 42+75 - STA. b ~~44+00~~ LT
~~STA. b 44+50 - STA. b 45+75 LT~~

6 INCH UNDERDRAIN CARRIER PIPE
STA. b 45+75 LT

UNDERDRAIN FLUSHING BASIN
STA. b ~~45+75~~ LT

STONE FILL, TYPE I
STA. b 43+75 - STA. b 44+25 LT

GRUBBING MATERIAL
STA. b 43+75 - STA. b 44+25 LT

GEOTEXTILE FOR SILT FENCE
STA. b 43+75 - STA. b 44+25 LT

GEOTEXTILE UNDER STONE FILL
STA. b 43+75 - STA. b 44+25 LT

VT STATE PLANE GRID

STA. b 42+87 LT




DURABLE 4 INCH YELLOW LINE (SEE OPTION ITEMS)
STA. b 42+75 - STA. b 46+50 (SOLID LT & RT)
(WITH CENTERLINE BREAKS AT TH #24)
STA. b 46+75 RT (CENTERLINE TH #24)
STA. b 47+00 - STA. b 48+50 (SOLID LT, DASHED RT)

TEMPORARY 4 INCH YELLOW LINE, PAINT
STA. b 42+75 - STA. b 46+50 (SOLID LT & RT)
(WITH CENTERLINE BREAKS AT TH #24)
STA. b 46+75 RT (CENTERLINE TH #24)
STA. b 47+00 - STA. b 48+50 (SOLID LT, DASHED RT)

CONC. PAD
BM
TOP OF SIDEWALK BOLT
ELV. 227.17

CURVE #11
DELTA = 0°28'14"
D = 0°28'39"
R = 12000.00'
T = 49.26'
L = 98.53'
NORMAL CROWN

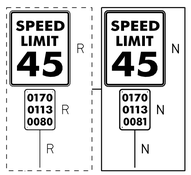





STA. b 46+55 RT




STA. b 47+04 RT

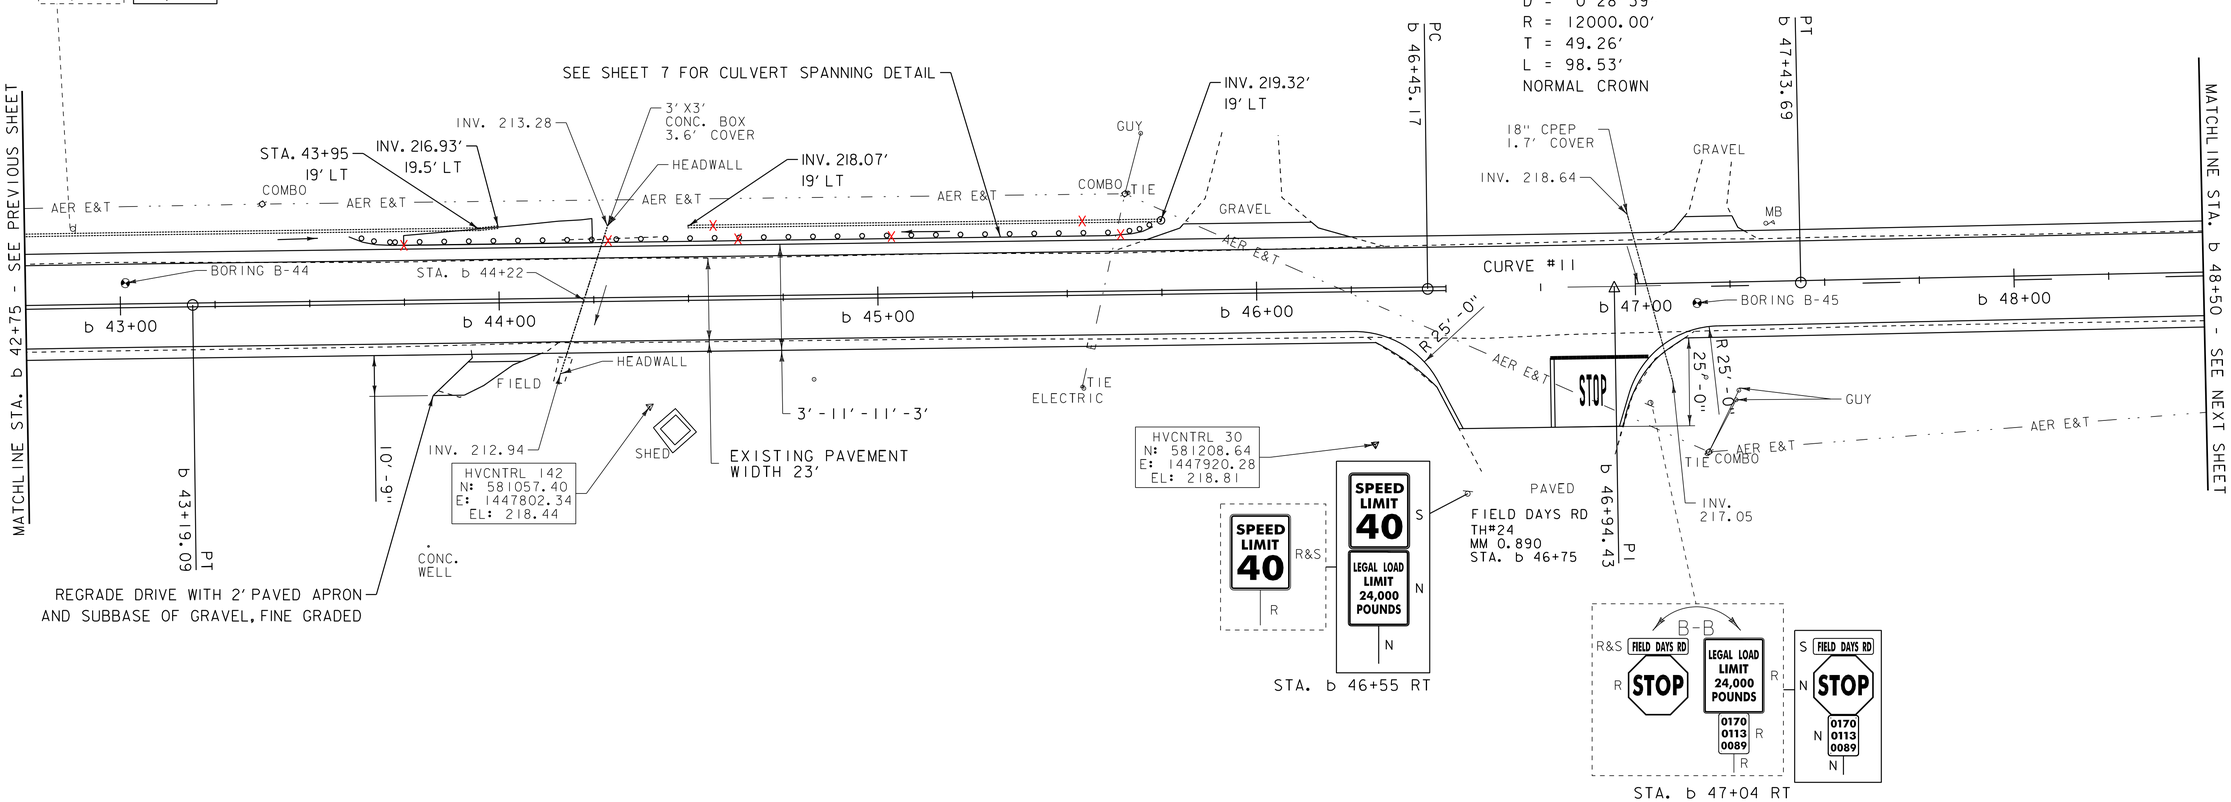REMOVING SIGNS
AS SHOWN - 7

ERECTING SALVAGED SIGNS
AS SHOWN - 2

LEGEND
- SIGN
- HYDRANT
- MANHOLE
- GATE VALVE
- GAS PIPELINE MARKER
- CATCH BASIN / DROP INLET
- CURB INLET
- BORING LOCATION
- MAILBOX
- UTILITY POLE
- FLUSHING BASIN

SIGN LEGEND
R = REMOVE
R&S = REMOVE AND SALVAGE
RET = RETAIN
S = SALVAGE
N = NEW
B-B = BACK TO BACK

SCALE 1" = 20'-0
20 0 20

DATUM
NAVD 88
NAD 83

**PROJECT LAYOUT SHEET 36**

PROJECT NAME: ADDISON - NEW HAVEN
PROJECT NUMBER: STP 9632(I)

FILE NAME: p95B076.dgn
PROJECT LEADER: CDL
DESIGNED BY: SJL
PLOT FILE: p95B076_59.i
PLOT DATE: 3/13/2012
DRAWN BY: SJL
CHECKED BY: EPD
SHEET 59 OF 186