Metric

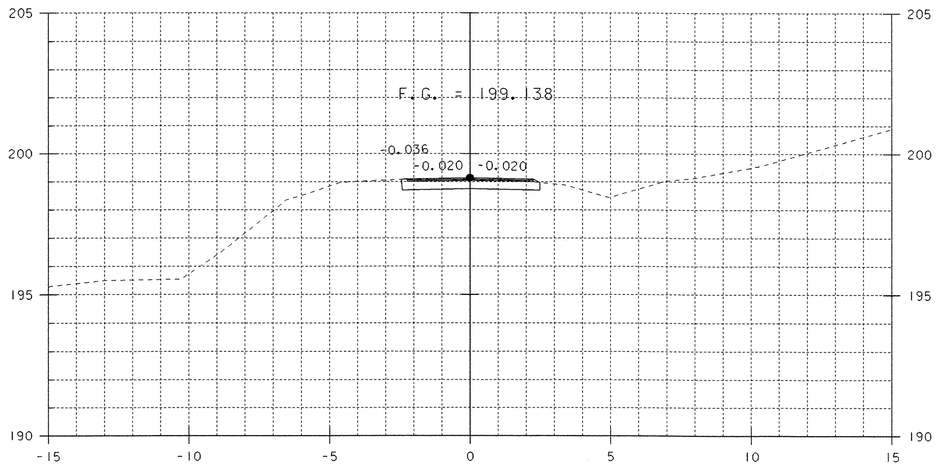


4+035.00

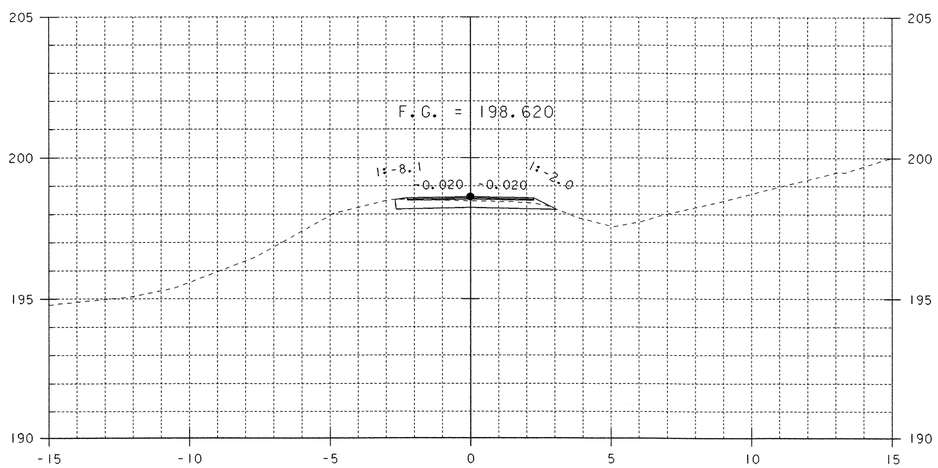


4+030.00

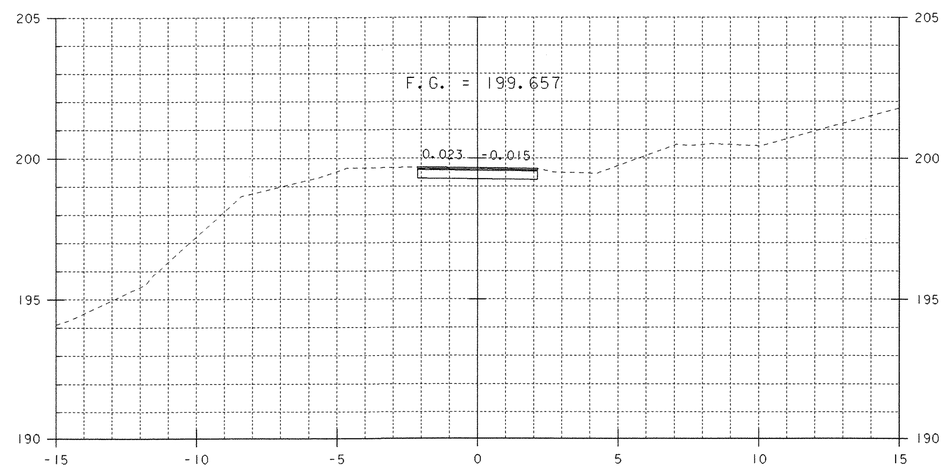


4+040.00

4+040.000 END DRIVE
MATCH EXISTING

STA. 4+030 TO STA. 4+040

# DRIVE SECTIONS 2

| | |
|---|---|
| PROJECT NAME: RUTLAND TOWN | |
| PROJECT NUMBER: BRF 019-3(48) | |
| FILE NAME: 95bl72/str/sbl72xs2.dgn | PLOT DATE: 11-MAR-2008 |
| PROJECT LEADER: R. WHITCOMB | DRAWN BY: L. BULLOCK |
| DESIGNED BY: L. BULLOCK | CHECKED BY: T. LACKEY |
| sbl72d02.i | SHEET 72 OF 75 |