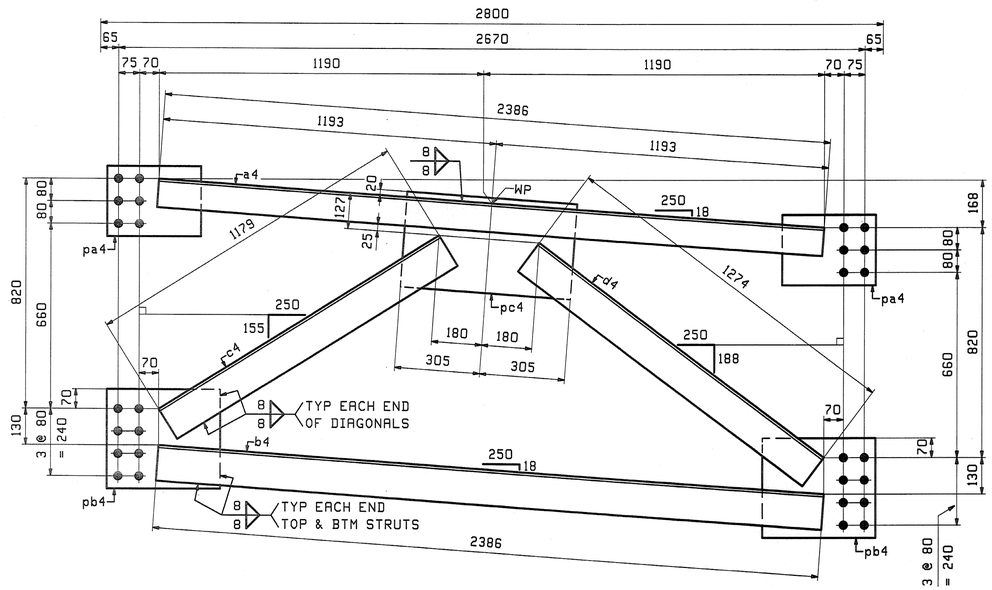

16 - INT. CROSSFRAMES ~ 4CF1

LOOKING AHEAD-STATION

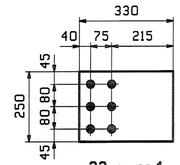

32 ~ pa4

TOP GUSSET

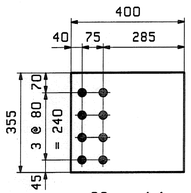

32 ~ pb4

BTM GUSSET

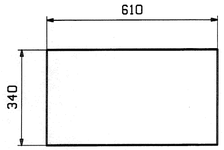

16 ~ pc4

CTR GUSSET

ABM INFO		SHIP	BILL OF MATERIAL			LENGTH		JOB NO. 368	DRAWING NO. 4	REV.
PAGE	LINE	MARK	QTY	MARK	MATERIAL	m	mm	REMARKS	WT	PROCUREMENT NOTES
		4CF1	16		INT. CROSSFRAMES				180 kg 418 lbs	
2	G		16	a4	L 102x102x9.5	2	386			
2	H		16	b4	L 127x127x9.5	2	386			
2	J		16	c4	L 127x127x9.5	1	179			
2	J		16	d4	L 127x127x9.5	1	274			
2	K		32	pa4	PL 13x250	0	330			
2	L		32	pb4	PL 13x355	0	400			
2	M		16	pc4	PL 13x340	0	610			

RECEIVED
CK'D BY RRW CK'D BY
JUL 0 1 2008
RESUBMIT APPROVED V
BY RRW DATE 7/3/08

NOTE:
FOR GENERAL NOTES SEE DRAWING GN1.

REV.	DATE	REMARKS	DWN	CHK	APVL	SHOP
0					5/20/08	

MATERIAL:	SURFACE PREP. & PAINT:	HOLES:	SHOP BOLTS:
M270M-345W	AS NOTED ON GN1	15/16Ø	NONE

DESCRIPTION: CROSSFRAMES

CASCO BAY STEEL STRUCTURES, INC.
75 SPRING HILL ROAD SACO, MAINE 04072
PHONE (207) 282-7360 FAX. (207) 282-1179
TENSOR 2788

STRUCTURE: US 7 over EAST CREEK BRIDGE NO 103 RUTLAND COUNTY, VERMONT		DRAWN: JTB	DATE: 04/19
		CHK'D: JF	DATE: 05/16
LOCATION: TOWN OF RUTLAND		JOB NO.	DWG NO.
PROJ NO. BRF 019-3(48)		368	4
CUSTOMER: VERMONT AOT			REV. △

JTB Mon May 19 09:23:02 EDT 2008 /users/jobs/2788/4.1 Rev0