Metric

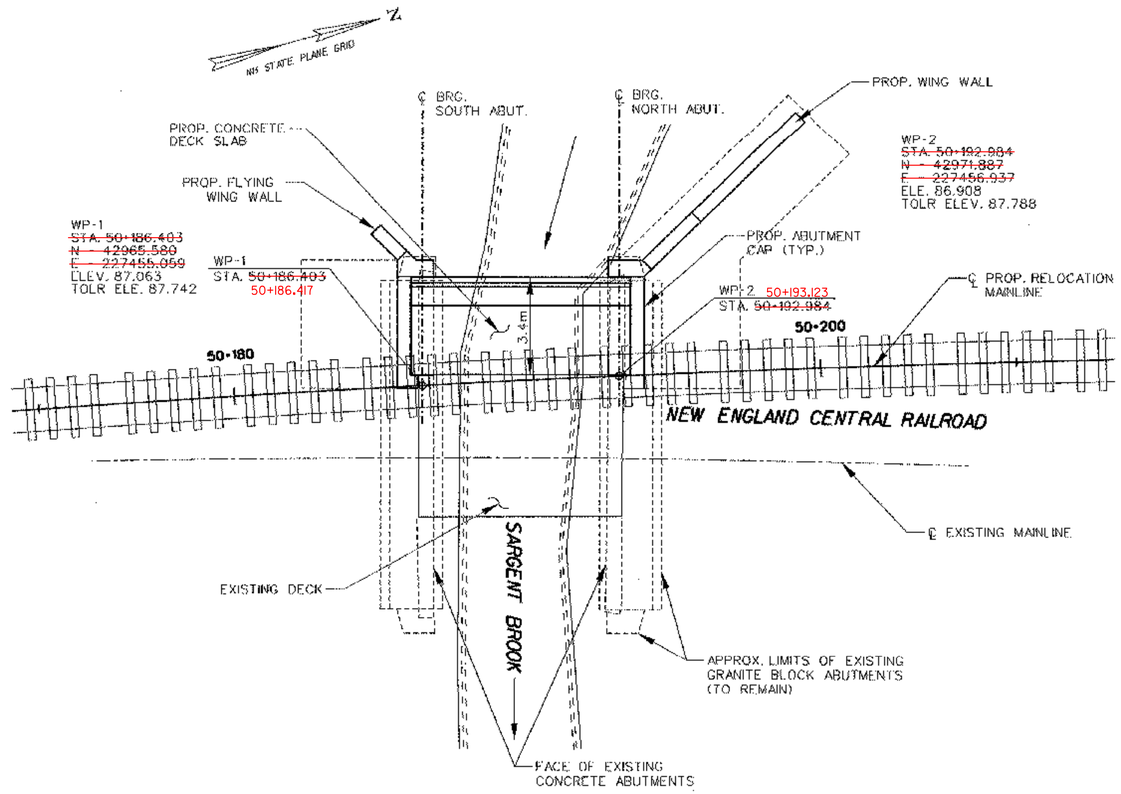

PLAN

SCALE 1:100

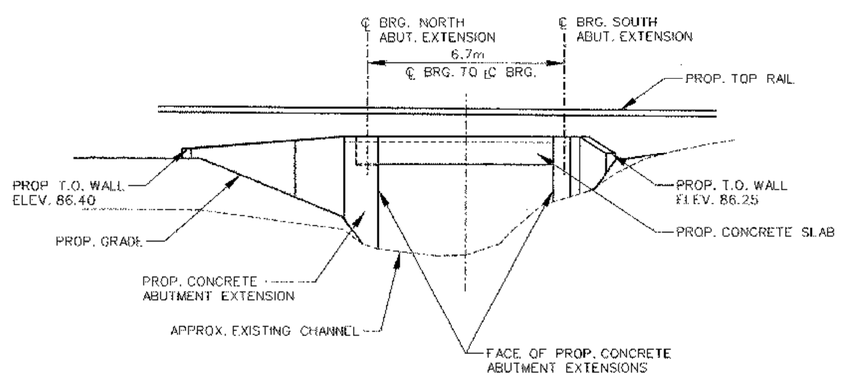

ELEVATION (LOOKING EAST)

SCALE 1:100

Plot Date: 10-02-2002
File: sgtbr100

STATE OF VERMONT
AGENCY OF TRANSPORTATION

Town Of BRATTLEBORO	Bridge No. 62.51
Highway No. VT. ROUTE 9	Log Sta. / Surv. Sta.
SARGENT BROOK	
PLAN & ELEVATION	
Designed By GJB	Drawn By DHL
Checked By GJB Date	Bridge Design Supervisor JHR Date
PROJECT BRATTLEBORO	PROJECT NO. NH BRF 012-1(33)
I.C.C. Info.	
Bridge Sheet No. 1	Sheet 90 of 145