Metric

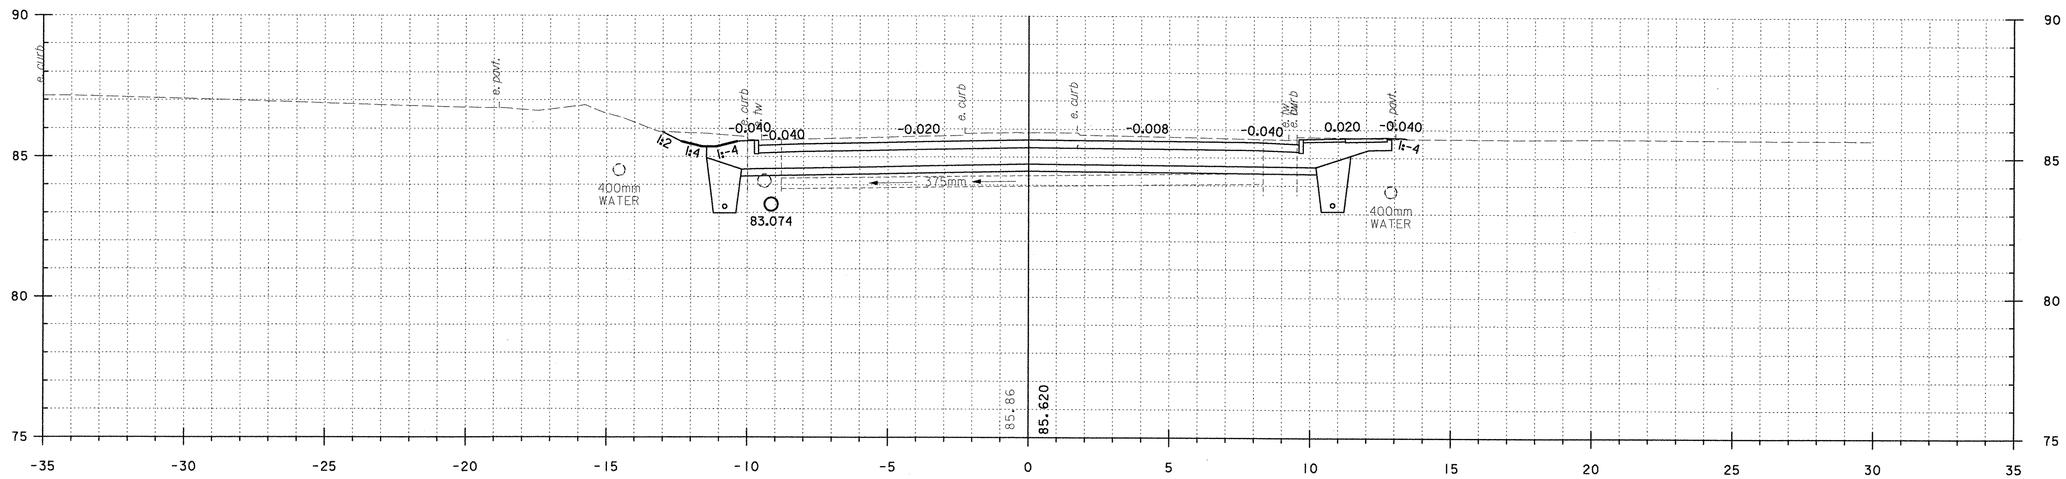

30+110.000

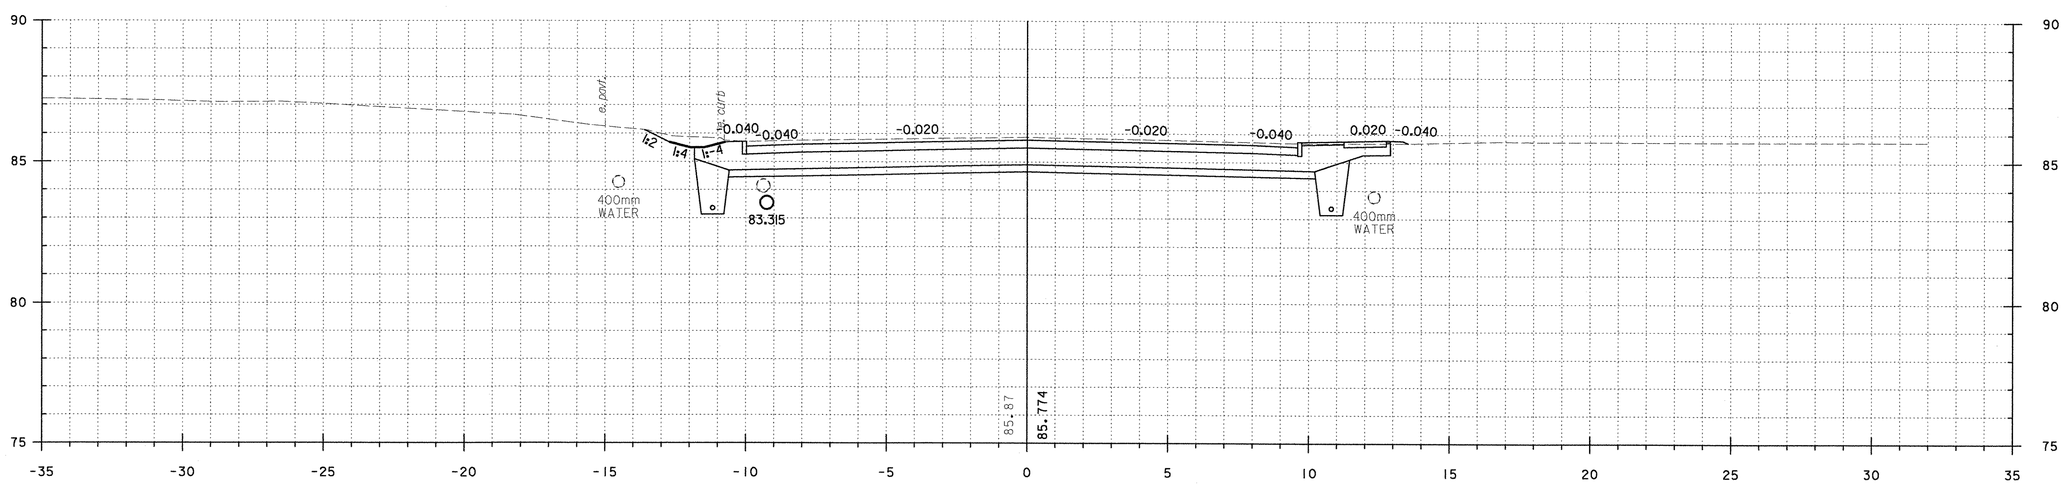

30+100.000

PROJECT: BRATTLEBORO	PROJECT NO.: NH 010-2(2)
DESIGN FILE NAME: ...\zb270xs2.dgn IPARM FILE NAME:	PLOT DATE: 09/23/2002
VT ROUTE 9	
FROM STA: 30+100.000 TO STA: 30+110.000 SHEET: 100 OF 145	