Metric

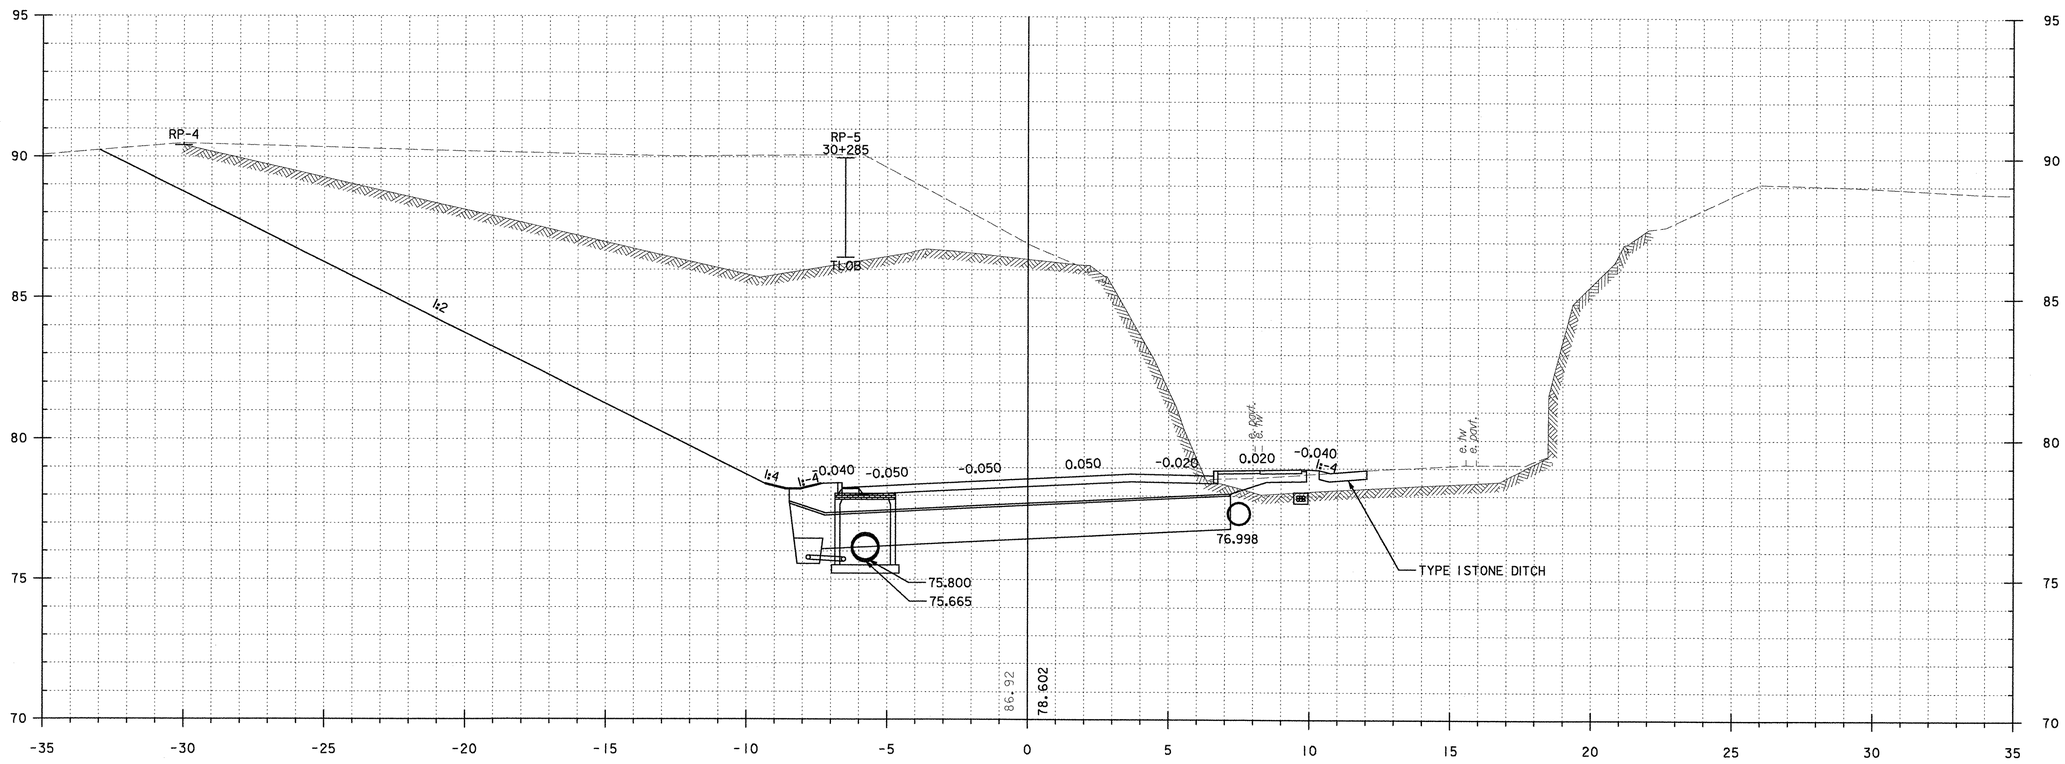


30+280.000

| | |
|---|---|
| PROJECT: BRATTLEBORO | PROJECT NO.: NH 010-2(2) |
| DESIGN FILE NAME: ...\zb270xs2.dgn<br>IPARM FILE NAME: | PLOT DATE: 09/23/2002 |
| VT ROUTE 9 | |
| FROM STA: 30+280.000 TO STA: 30+280.000 SHEET: 109 OF 145 | |