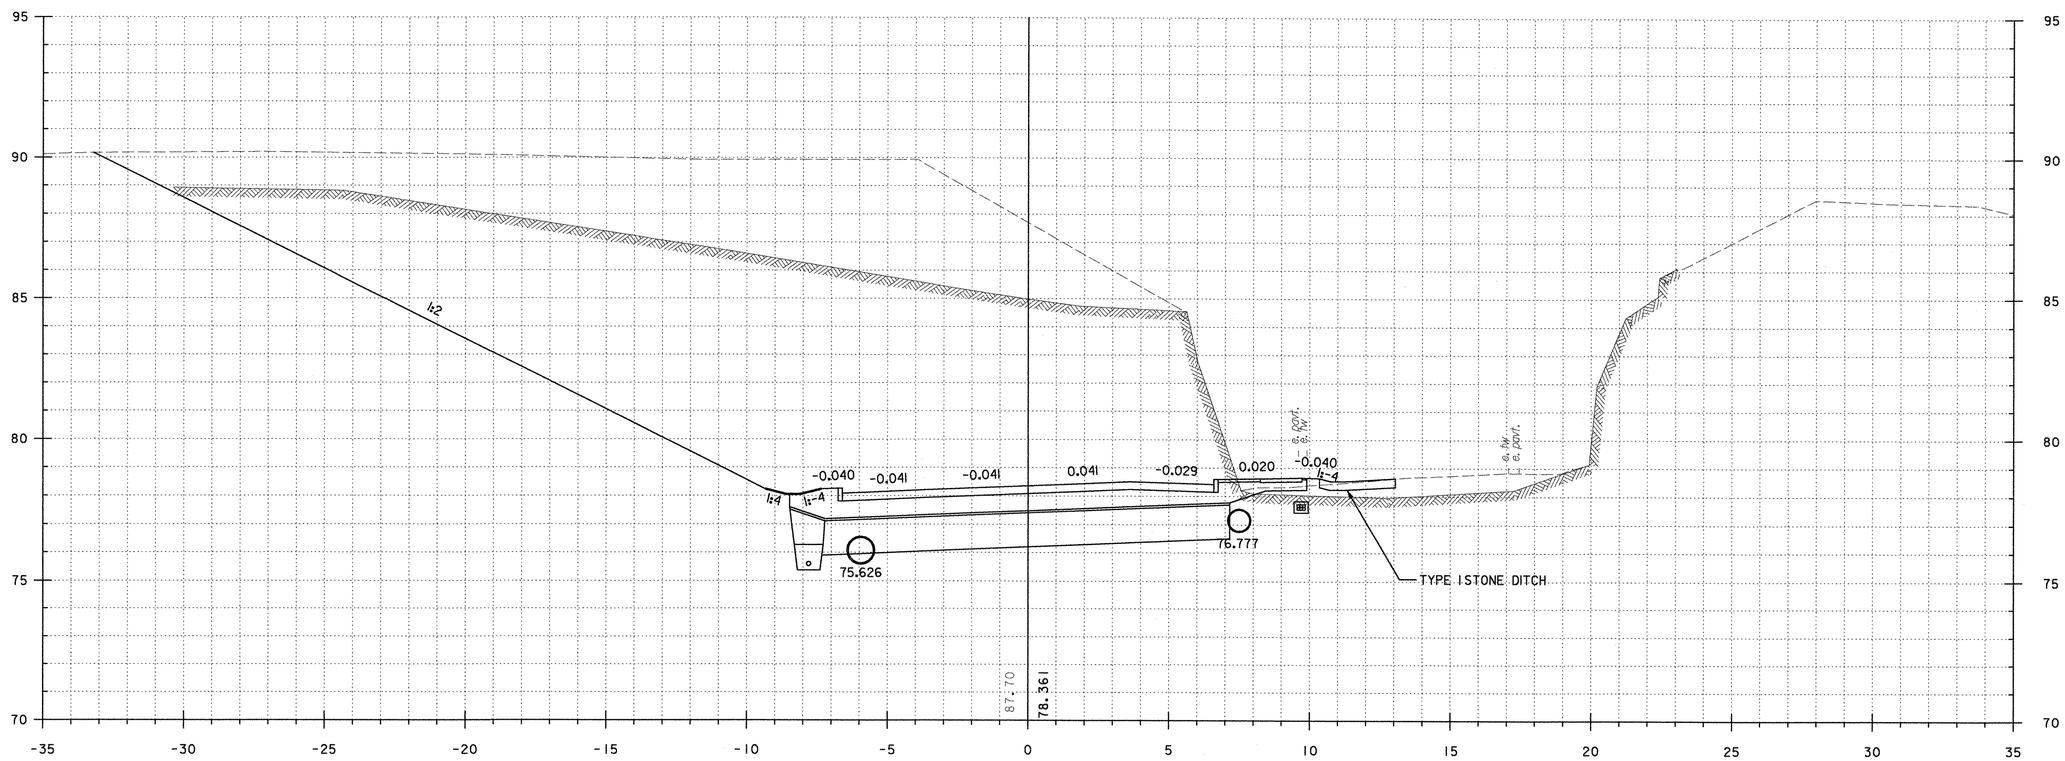

30+290.000

PROJECT: BRATTLEBORO	PROJECT NO.: NH 010-2(2)
DESIGN FILE NAME: ...\zb270xs2.dgn IPARM FILE NAME:	PLOT DATE: 09/23/2002
VT ROUTE 9	
FROM STA: 30+290.000 TO STA: 30+290.000 SHEET: 110 OF 145	