Metric

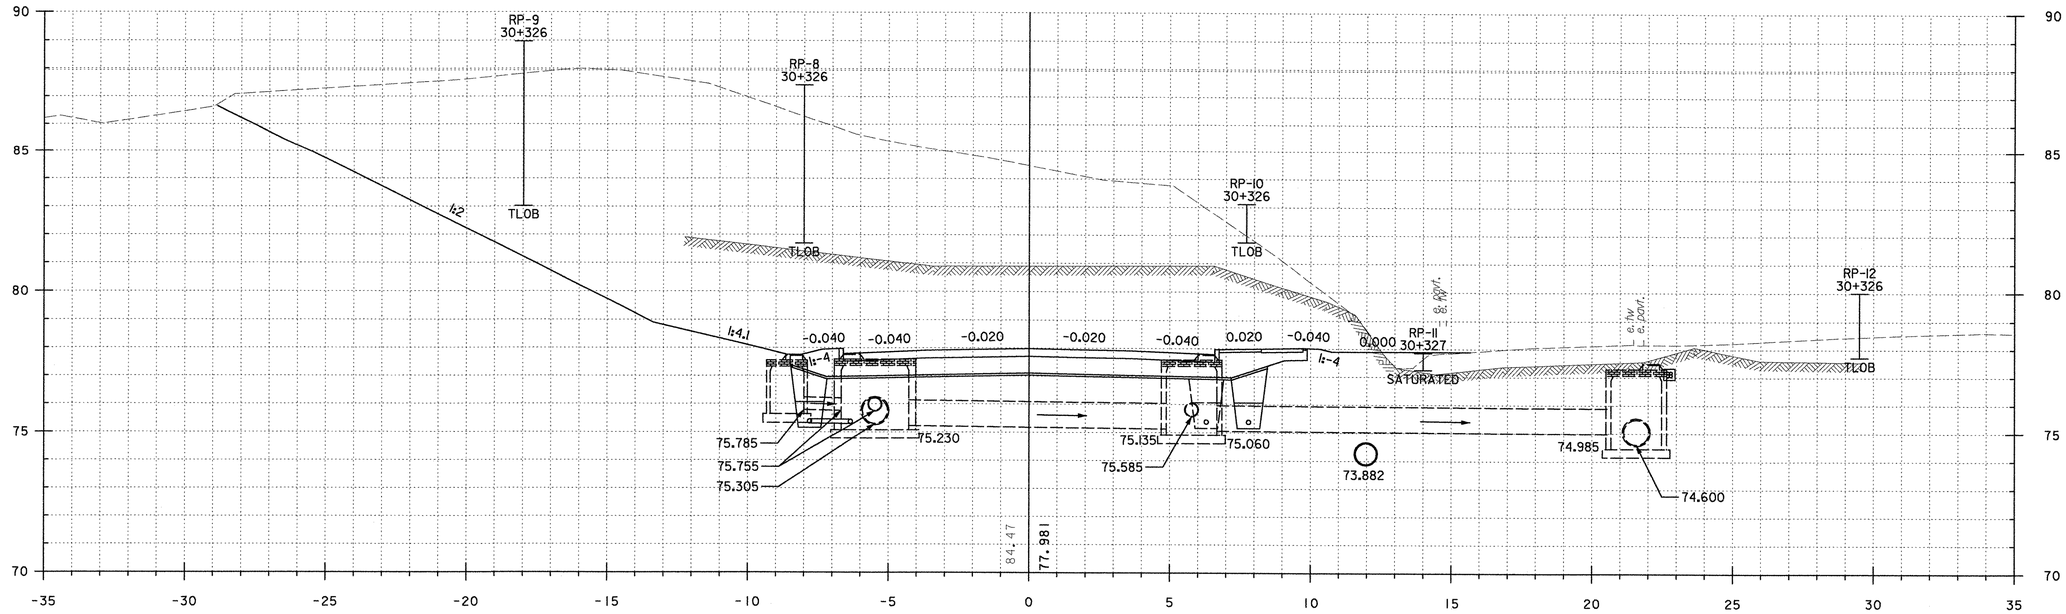

30+330.000

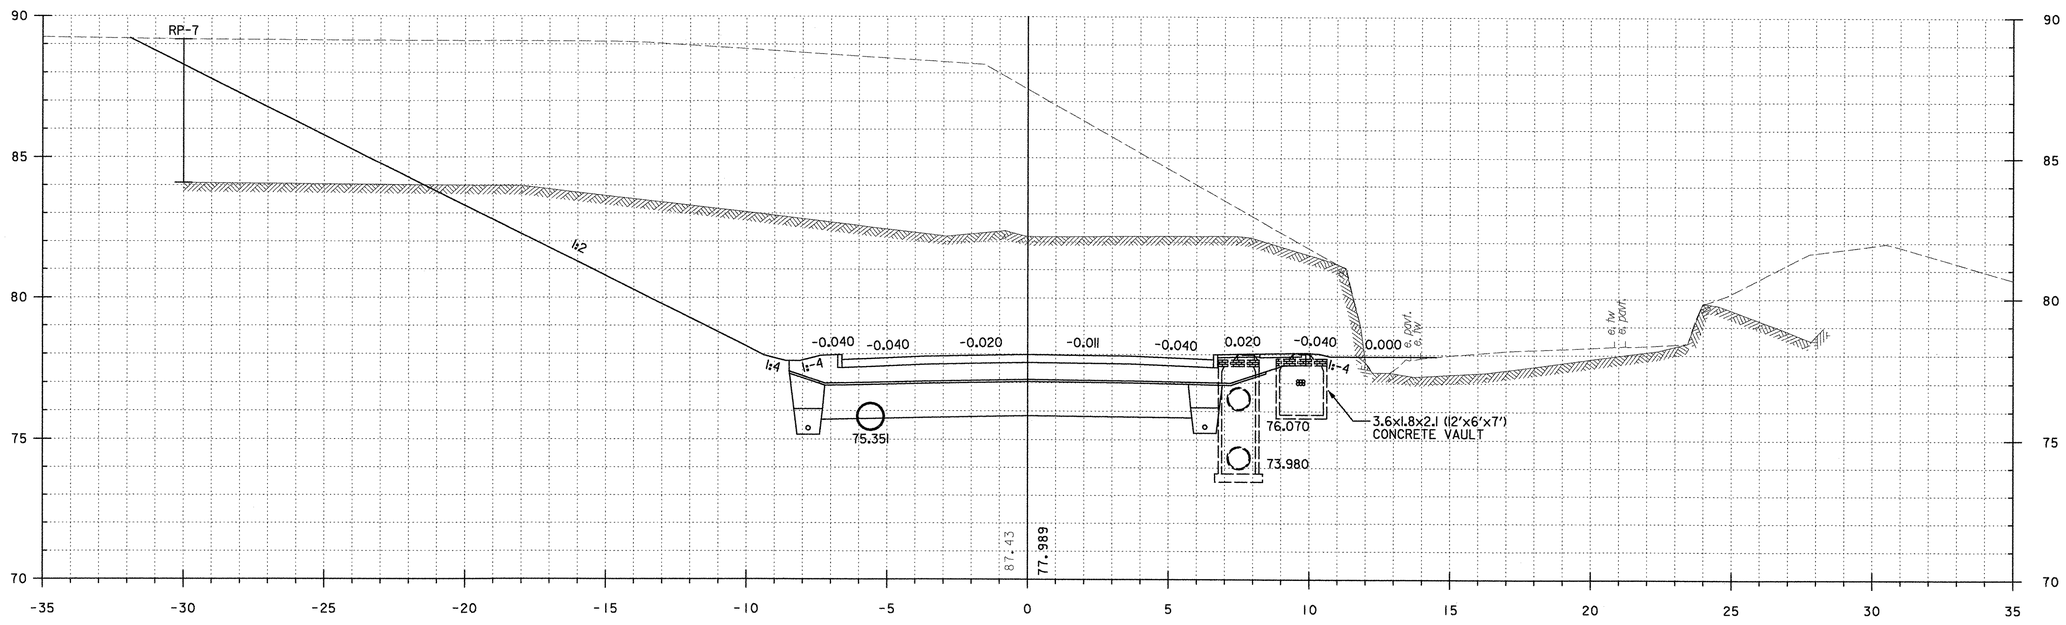

30+320.000

PROJECT: BRATTLEBORO	PROJECT NO.: NH 010-2(2)
DESIGN FILE NAME: ...\zb270xs2.dgn IPARM FILE NAME:	PLOT DATE: 09/23/2002
VT ROUTE 9	
FROM STA: 30+320.000 TO STA: 30+330.000 SHEET: 112 OF 145	