WORK ORDER

Notice: Not for Use/disclosure outside of VERIZON without written agreement

VERIZON

SAFETY NOTES: **TRAFFIC, ROAD CONSTRUCTION**		MOD/REV NO.	DATE	EWO NO.
				PRINT 5 OF
				PREPARED BY:
				C.O. /EXCHANGE NAME:
SIGNATURE DATE 3/1/2001		TYPE	RECORD REF:	BRATTLEBORO
		AERIAL	1-4E	C.O. /EXCHANGE CODE:
	PRE CT YES ☐ NO ☒	UNDERGROUND	—	4731
	PRIMARY VOLTAGE TO GROUND	BLOCK (NYT)	—	MUNICIPALITY:
	7.2 KV MGN SYSTEM	CONDUIT	—	BRATTLEBORO
CABLE PRESS.	UNDER PRESS. YES ☐ NO ☒	BUFFER YES ☐ NO ☒		MANHOLE LOCATION MH# NA
TRANSMISSION	26GA LIMIT YES ☐ NO ☒	AMT. BRIDGE TAP	INPUT	KF

N

EXISTING CONDUIT

CAUTION

PROJ # 131104

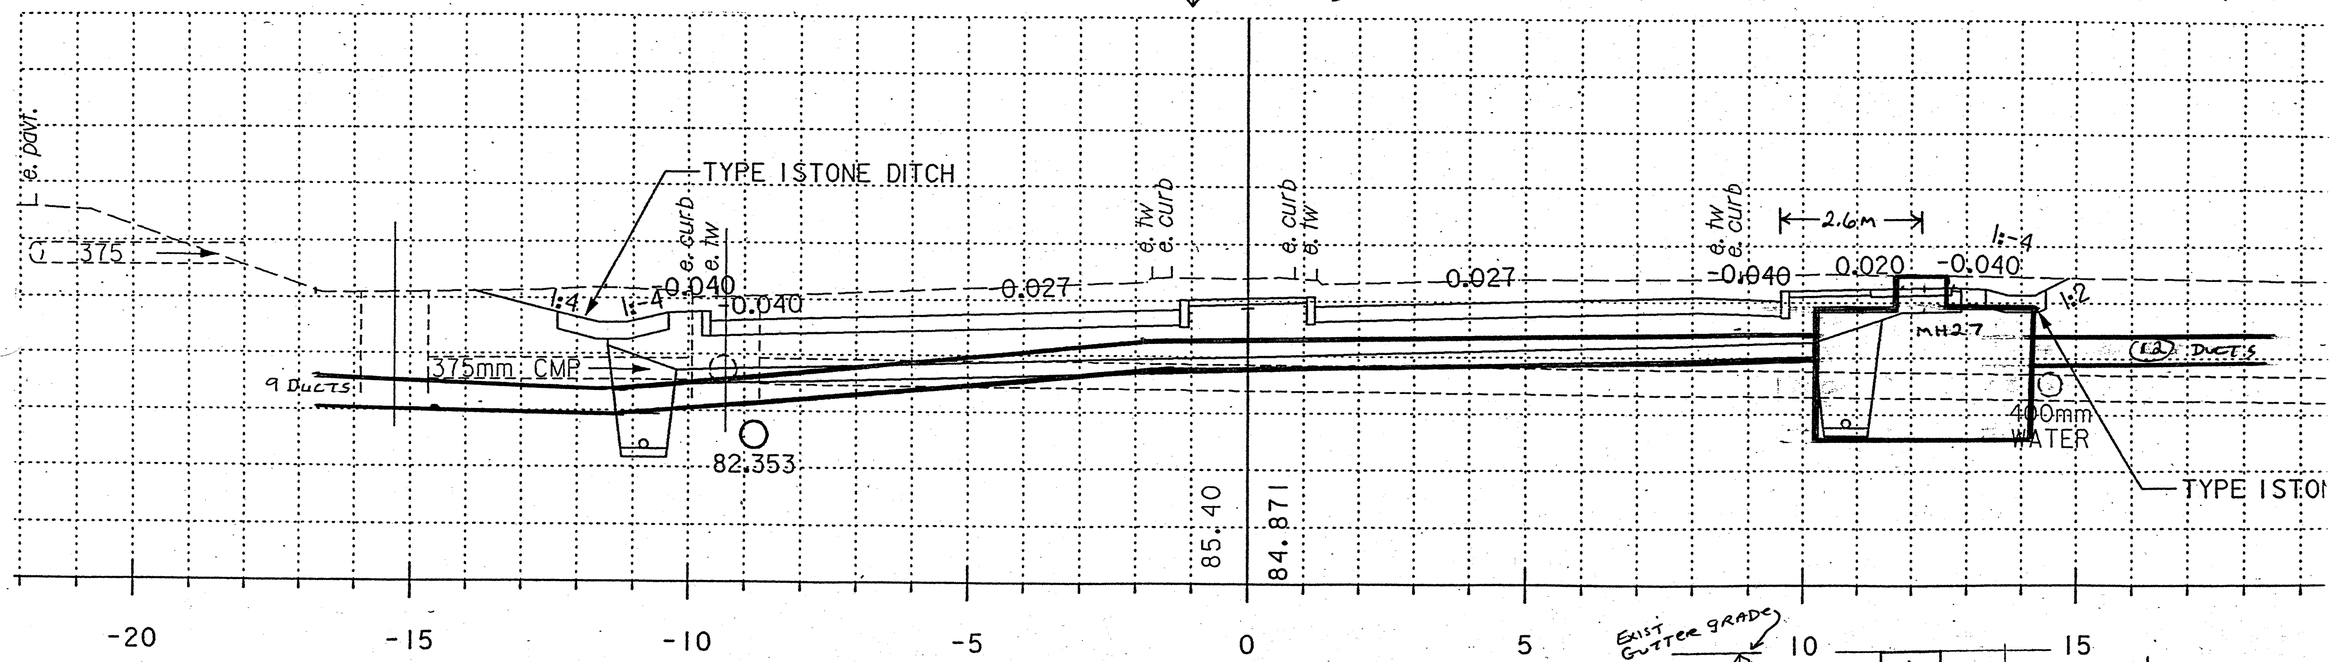

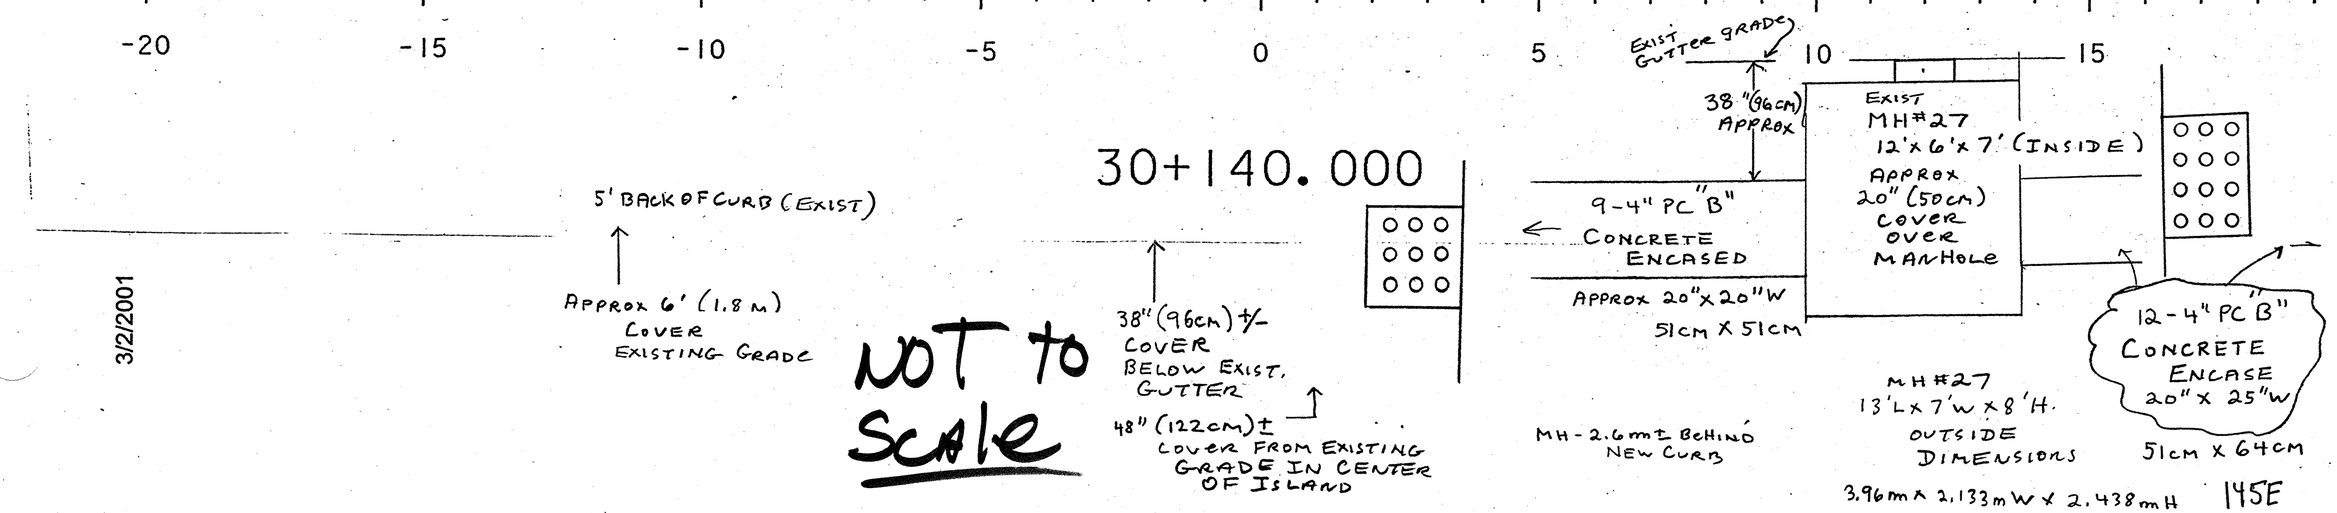

3/2/2001

145E