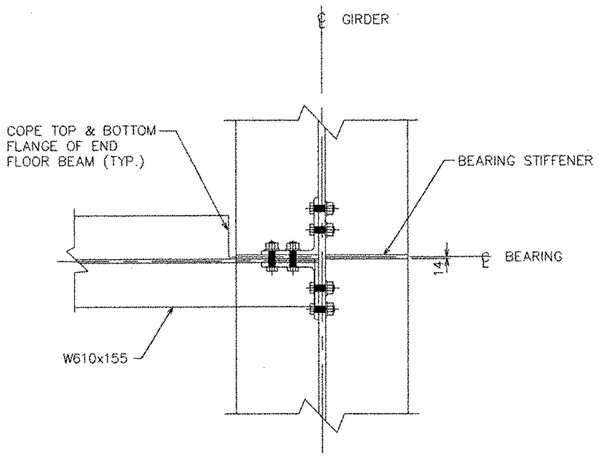

SECTION 2-2

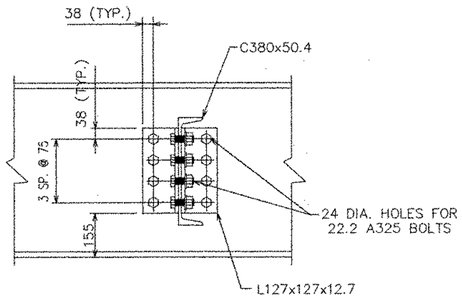

DIAPHRAGM CONNECTION DETAIL

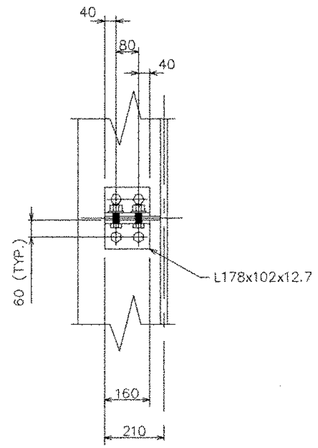

PLAN

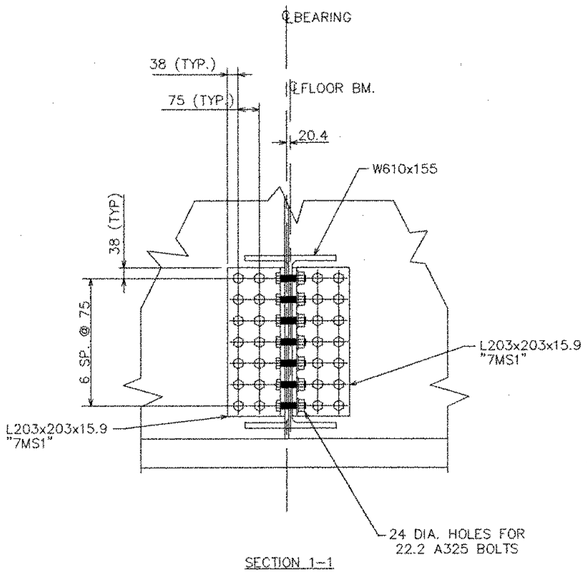

SECTION 1-1

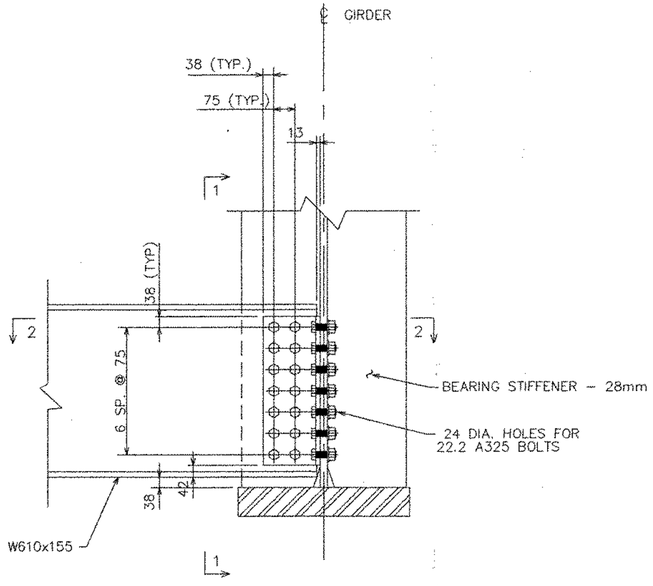

END FLOOR BEAM CONNECTION DETAIL

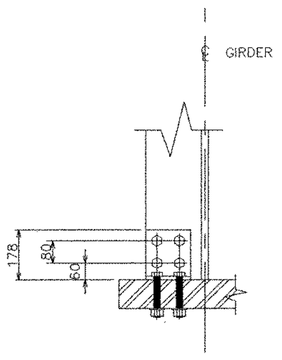

ELEVATION

DETAIL A
BOLTING OF INTERMEDIATE STIFFENER NEAR BEARING

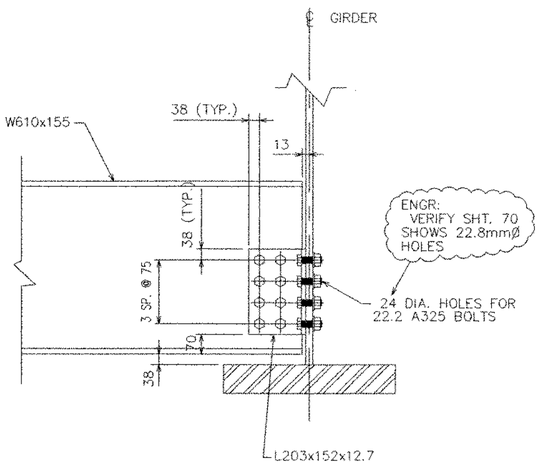

FLOOR BEAM CONNECTION DETAIL

STEEL-ART, INCORPORATED
40 WEST MAIN STREET
GALETON, PA 16922
(814) 435-6997

EASTERN BRIDGE LLC
RURAL RTE 2, BOX 302
CLAREMONT, NH 03743
603-542-5202

REVISIONS		
NO.	DATE	DESCRIPTION
	8/14/03	APPROVAL

STATE OF VERMONT
AGENCY OF TRANSPORTATION

CONTRACT : PIN :

PROPOSED IMPROVEMENT TO RR BRIDGE #62.56 OVER VT ROUTE 9 (PRINCIPAL ARTERIAL) WINDHAM COUNTY, TOWN OF BRATTLEBORO

TITLE :

SECTIONS & DETAILS

DRAWN BY	SHOP ORDER	DWG. NO.
DAN 3/19/03	4015	E2
CKD BY	BLOCK NO.	SHEET NO.
RJS 4/14/03		3 / 20

1887 SS