4" WHITE LINE

FROM STA.	TO STA.
108+00.00 LT	- 109+50.00 LT
108+00.00 RT	- 109+50.00 RT

4" YELLOW LINE (DOUBLE)

FROM STA.	TO STA.
108+00.00	- 109+50.00

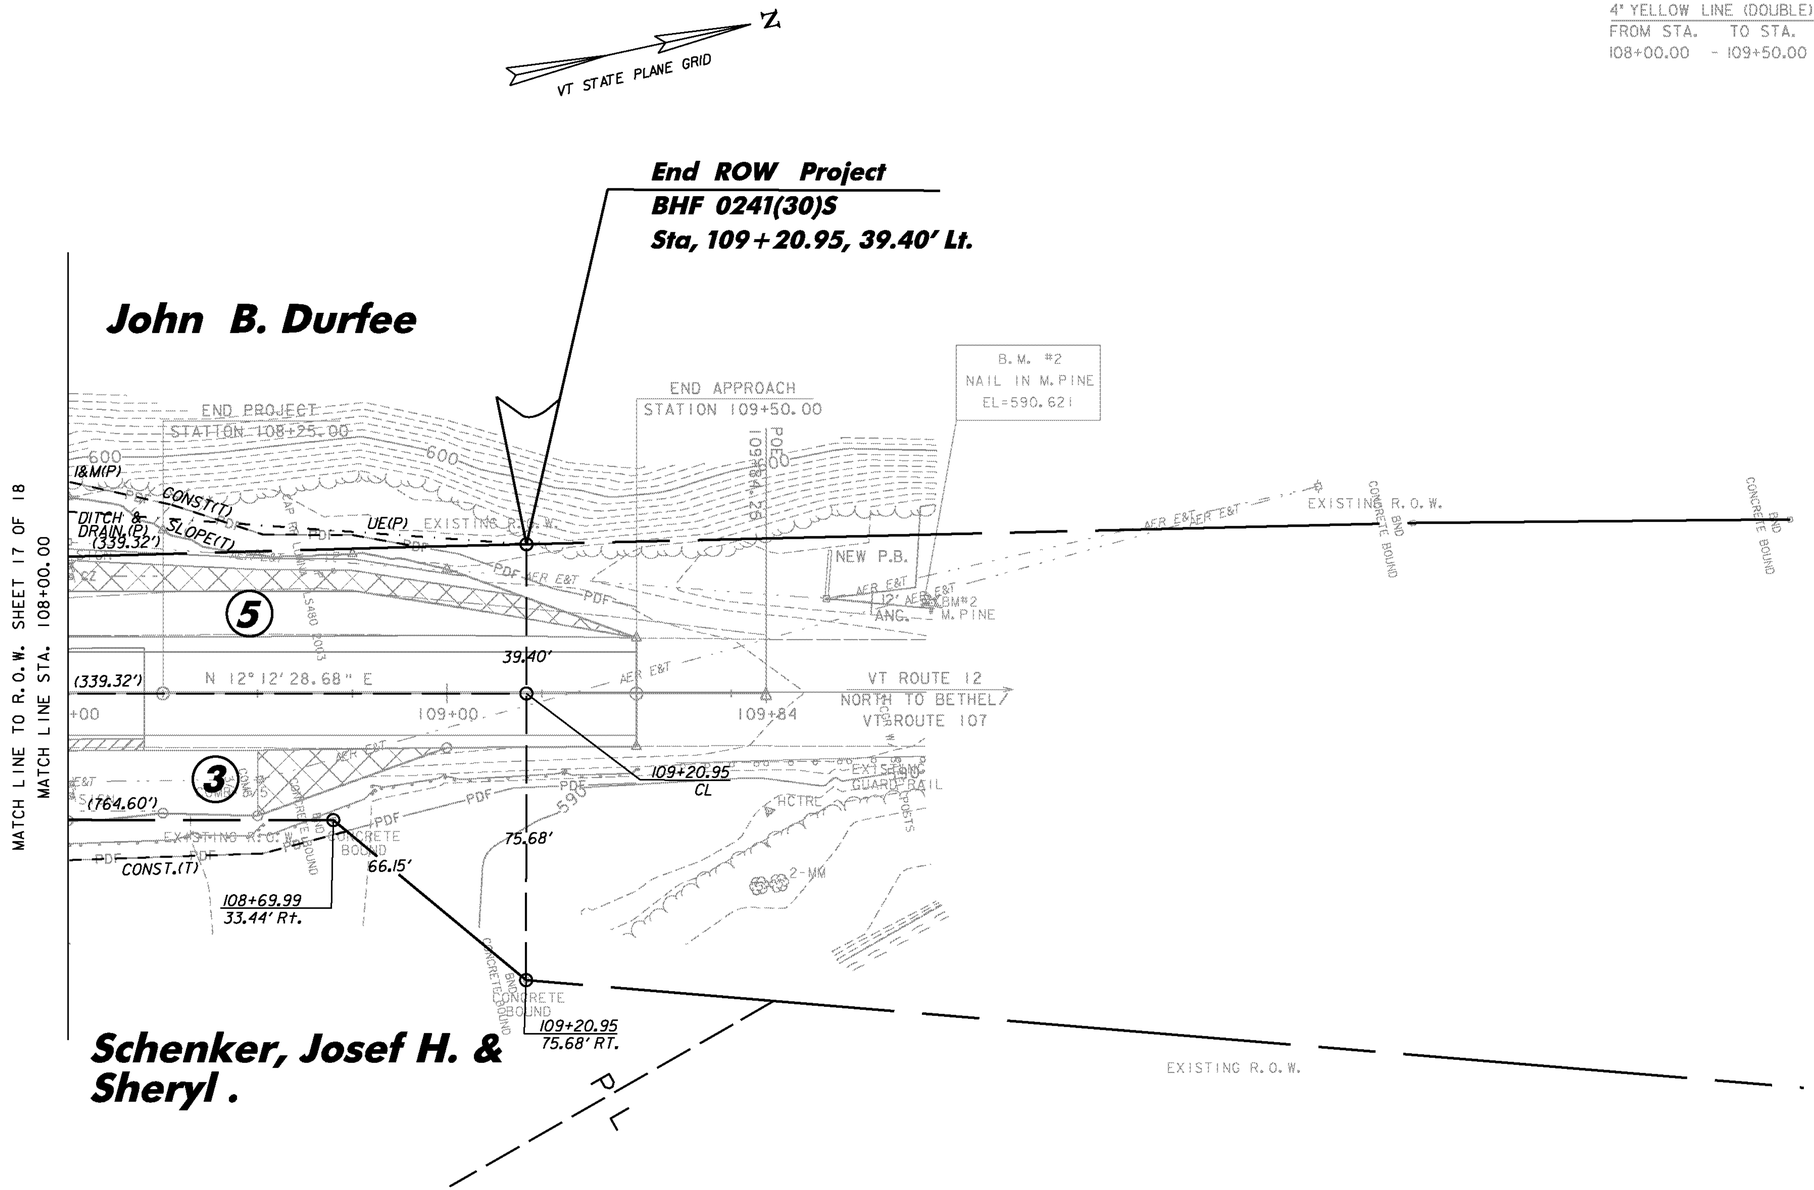

FOR R.O.W. USE ONLY

SCALE 1" = 20'-0"
20 0 20

PROJECT NAME: BETHEL	
PROJECT NUMBER: BHF 0241(30)	
FILE NAME: sc002bdr.dgn	PLOT DATE: 31-AUG-2011
PROJECT LEADER: M. EVANS-MONGEON	DRAWN BY: G. ROKES
DESIGNED BY: U. STANLEY	CHECKED BY: U. STANLEY
R.O.W. LAYOUT SHEET 3	SHEET 21 OF 64