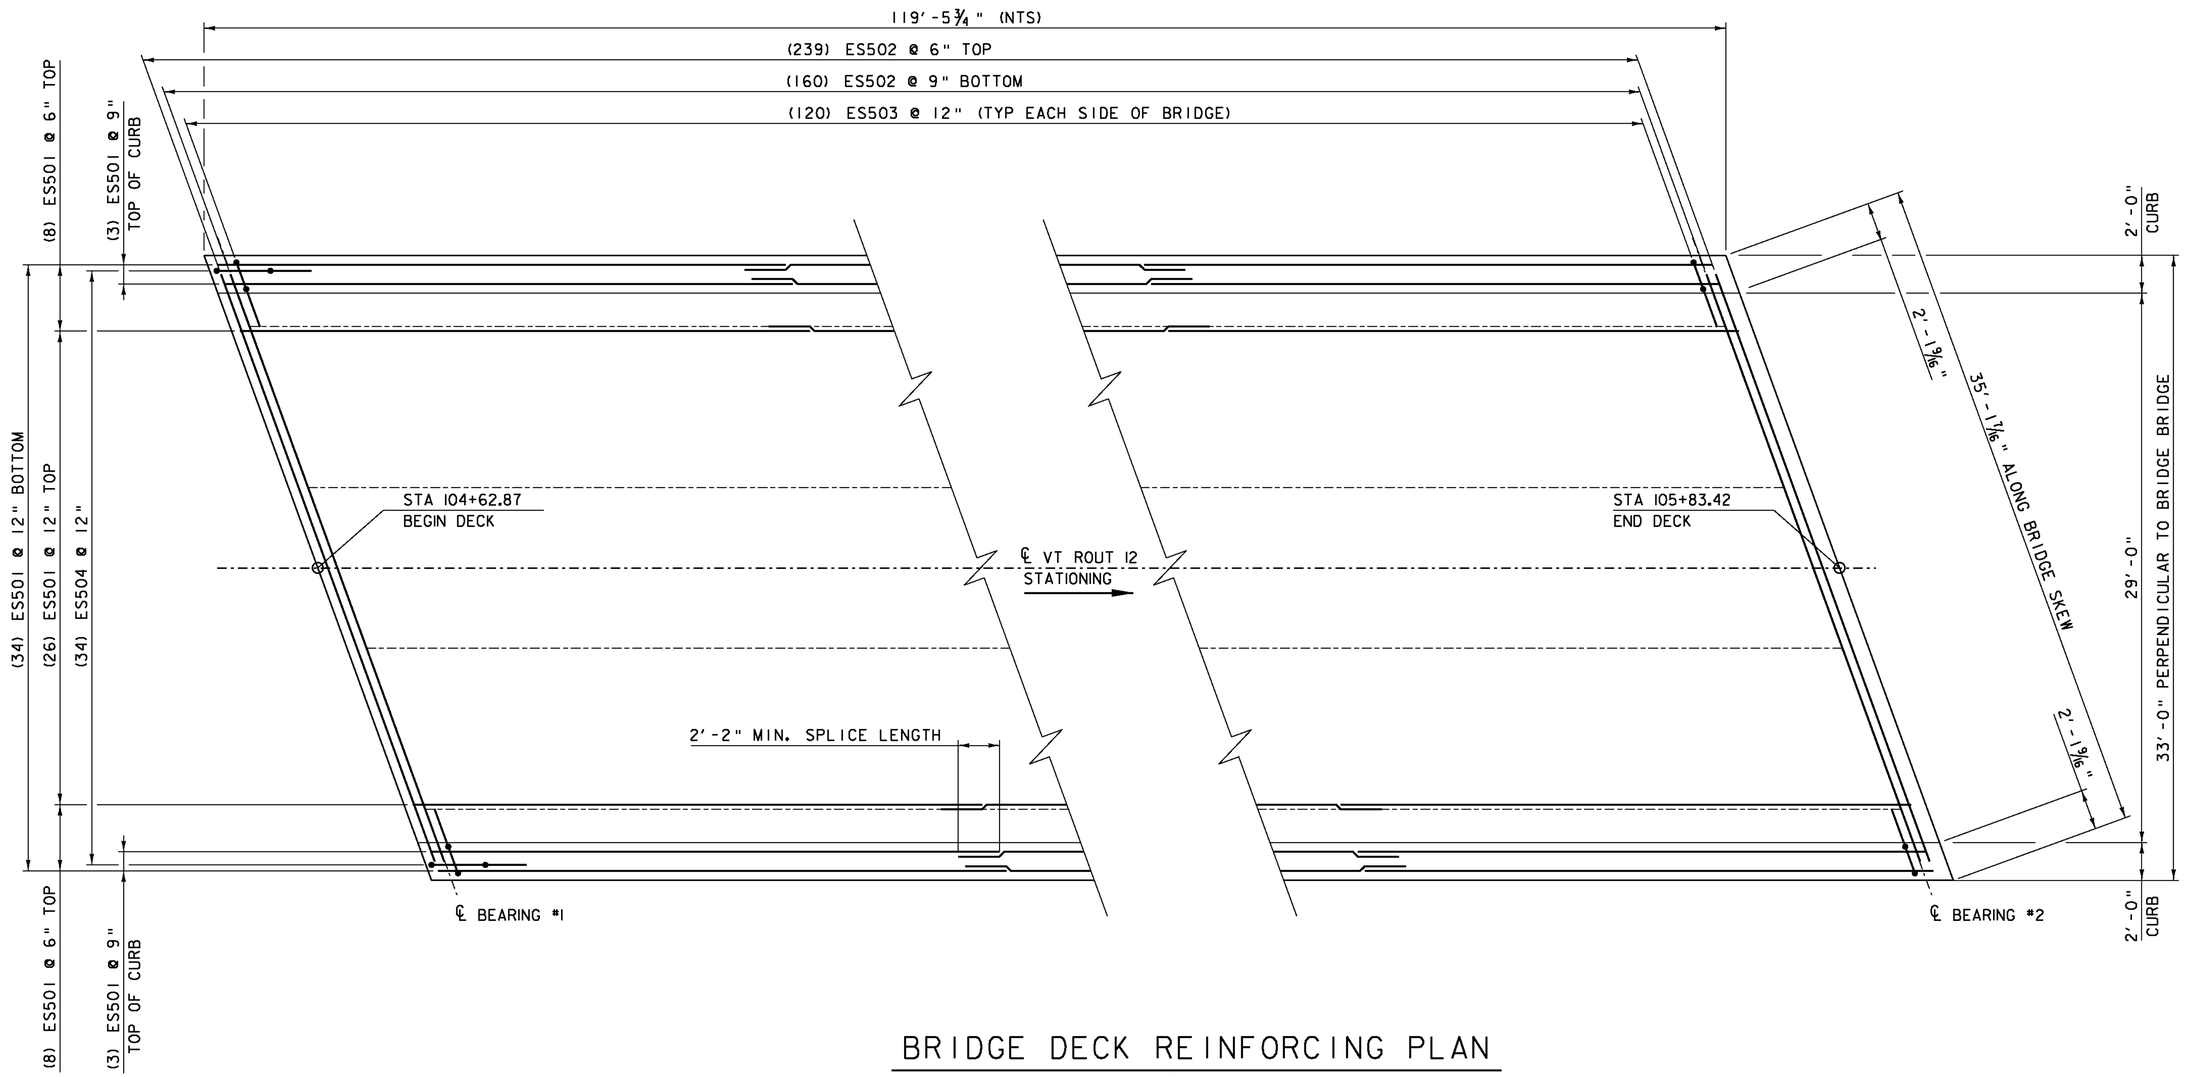

BRIDGE DECK REINFORCING PLAN

SCALE ¼" = 1'-0"

NOTE:

NF = NEAR FACE
FF = FAR FACE
EF = EACH FACE
▲ = CUT TO FIT IN FIELD
3" CLEAR, UNLESS OTHERWISE SPECIFIED ON THE PLANS.
2'-2" BAR LAP UNLESS OTHERWISE SPECIFIED ON THE PLANS.

PROJECT NAME: BETHEL	
PROJECT NUMBER: BHF 0241(30)	
FILE NAME: s95c002sup.dgn	PLOT DATE: 31-AUG-2011
PROJECT LEADER: M. EVANS-MONGEON	DRAWN BY: M. LONGSTREET
DESIGNED BY: U. STANLEY	CHECKED BY: U. STANLEY
DECK REINFORCING PLAN & DETAILS	SHEET 43 OF 64