VAOT Metric

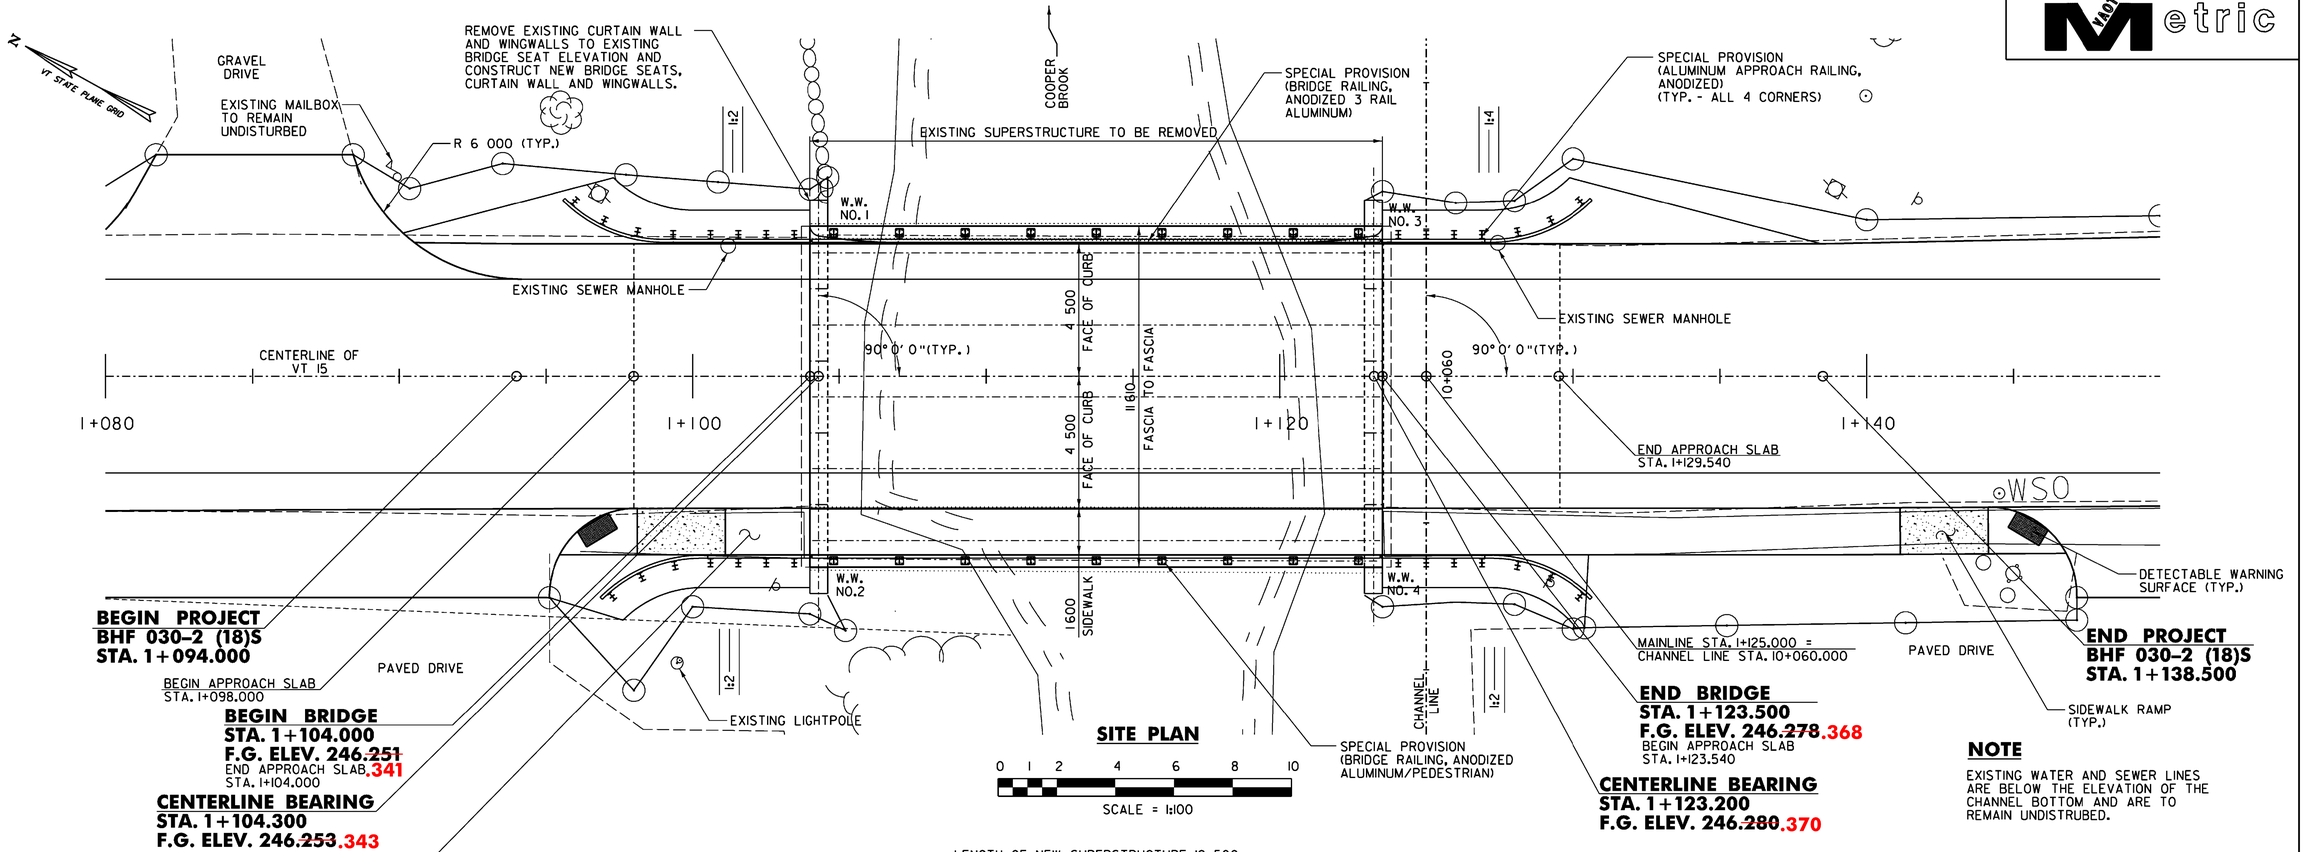

LEGEND

EXISTING EDGE OF RIVER	
EXISTING TRAVELED WAY	
EXISTING GUARD RAIL	
STORM DRAIN	
UTILITY POLE	
TELEPHONE POLE	
TREES	
TREE LINE	
OVERHEAD LINES	— AERIAL E&T —
WATER LINE	— W —
EXISTING SIGN	
SEWER LINE	— S —
CLEAR ZONE	— - - CZ —

DATUM

VERTICAL	NAVD 88
HORIZONTAL	NAD 83/92

PLOTTED $$$$DATE$$$

DuBois & King inc.
engineering planning management development

STATE OF VERMONT
AGENCY OF TRANSPORTATION

Town Of HARDWICK	Bridge No. 67
	Log Sta.
Highway No. VT 15	Surv. Sta.

VT 15 OVER COOPER BROOK

PLAN AND ELEVATION

Designed By A.P. GUYETTE	Drawn By S.J. BIJOLLE
Checked By Date E. P. DETRICK 11/08	Bridge Design Supervisor J.W.TUCKER Date 11/08
PROJECT HARDWICK	PROJECT NO. BHF 030-2 (18) S
I.G.C. Info. DGN$SPEC$	
Bridge Sheet No.	Sheet 12 of 38

I:\R16411\dgn\z95j306p&e.dgn 12/1/2008 9:38:28 AM