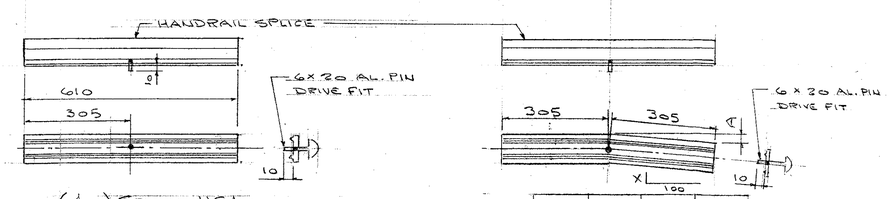

(4) SPLICE HS1

QUAN	MK	X	A
2	HS2	8.8	27
2	HS3	5.8	18

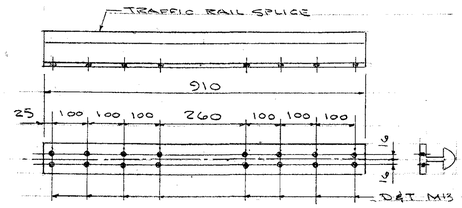

(8) SPLICE TS1

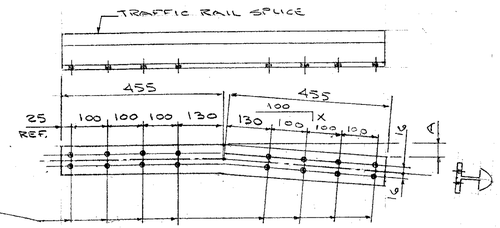

QUAN	MK	X	A
2	TS2	4.4	20
2	TS3	2.5	11
2	TS5	1.0	5
2	TS6	0.5	2

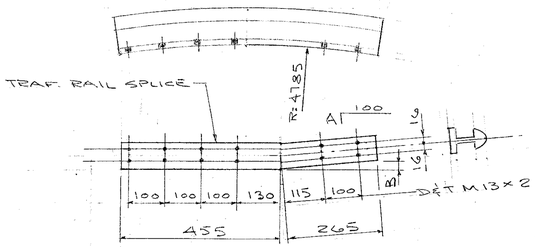

QUAN	MK	A	B
1	TS4	4.4	12
1	TS7	2.5	7

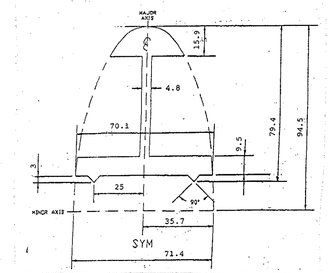

HANDRAIL SPLICE
EXTRUSION
ALLOY 6061-T6

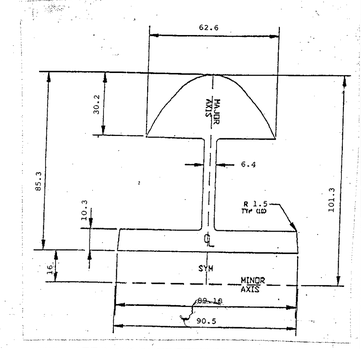

TRAFFIC RAIL SPLICE
EXTRUSION
ALLOY 6061-T6

DIM'S ARE GIVEN IN MILLIMETERS

AUCIELLO IRON WORKS INC
560 MAIN ST. HUDSON, MA (978) 568-8382

V.T. AGENCY OF TRANSPORTATION
HARDWICK #BHF 030-2(18)S
BRIDGE # 67
VT 15 OVER COOPER BROOK

AL. BRIDGE & APPROACH RAILING

SURFACE PREP: NONE	FINISH: BLACK ANODIZE
FOR: F.R. LAFAYETTE, INC.	
DR: WM 9-15-09 CHK:	DWG. NO. BR-2965
JOB NO. AB07010-1001	SHEET #6 OF 6

RECEIVED
OK'D BY ____ OK'D BY ____
STAMP

ISSUE	DATE	DESCRIPTION	BY
1	9/24/09	FOR APPROVAL	B

BL MAKEPEACE INC. 10616