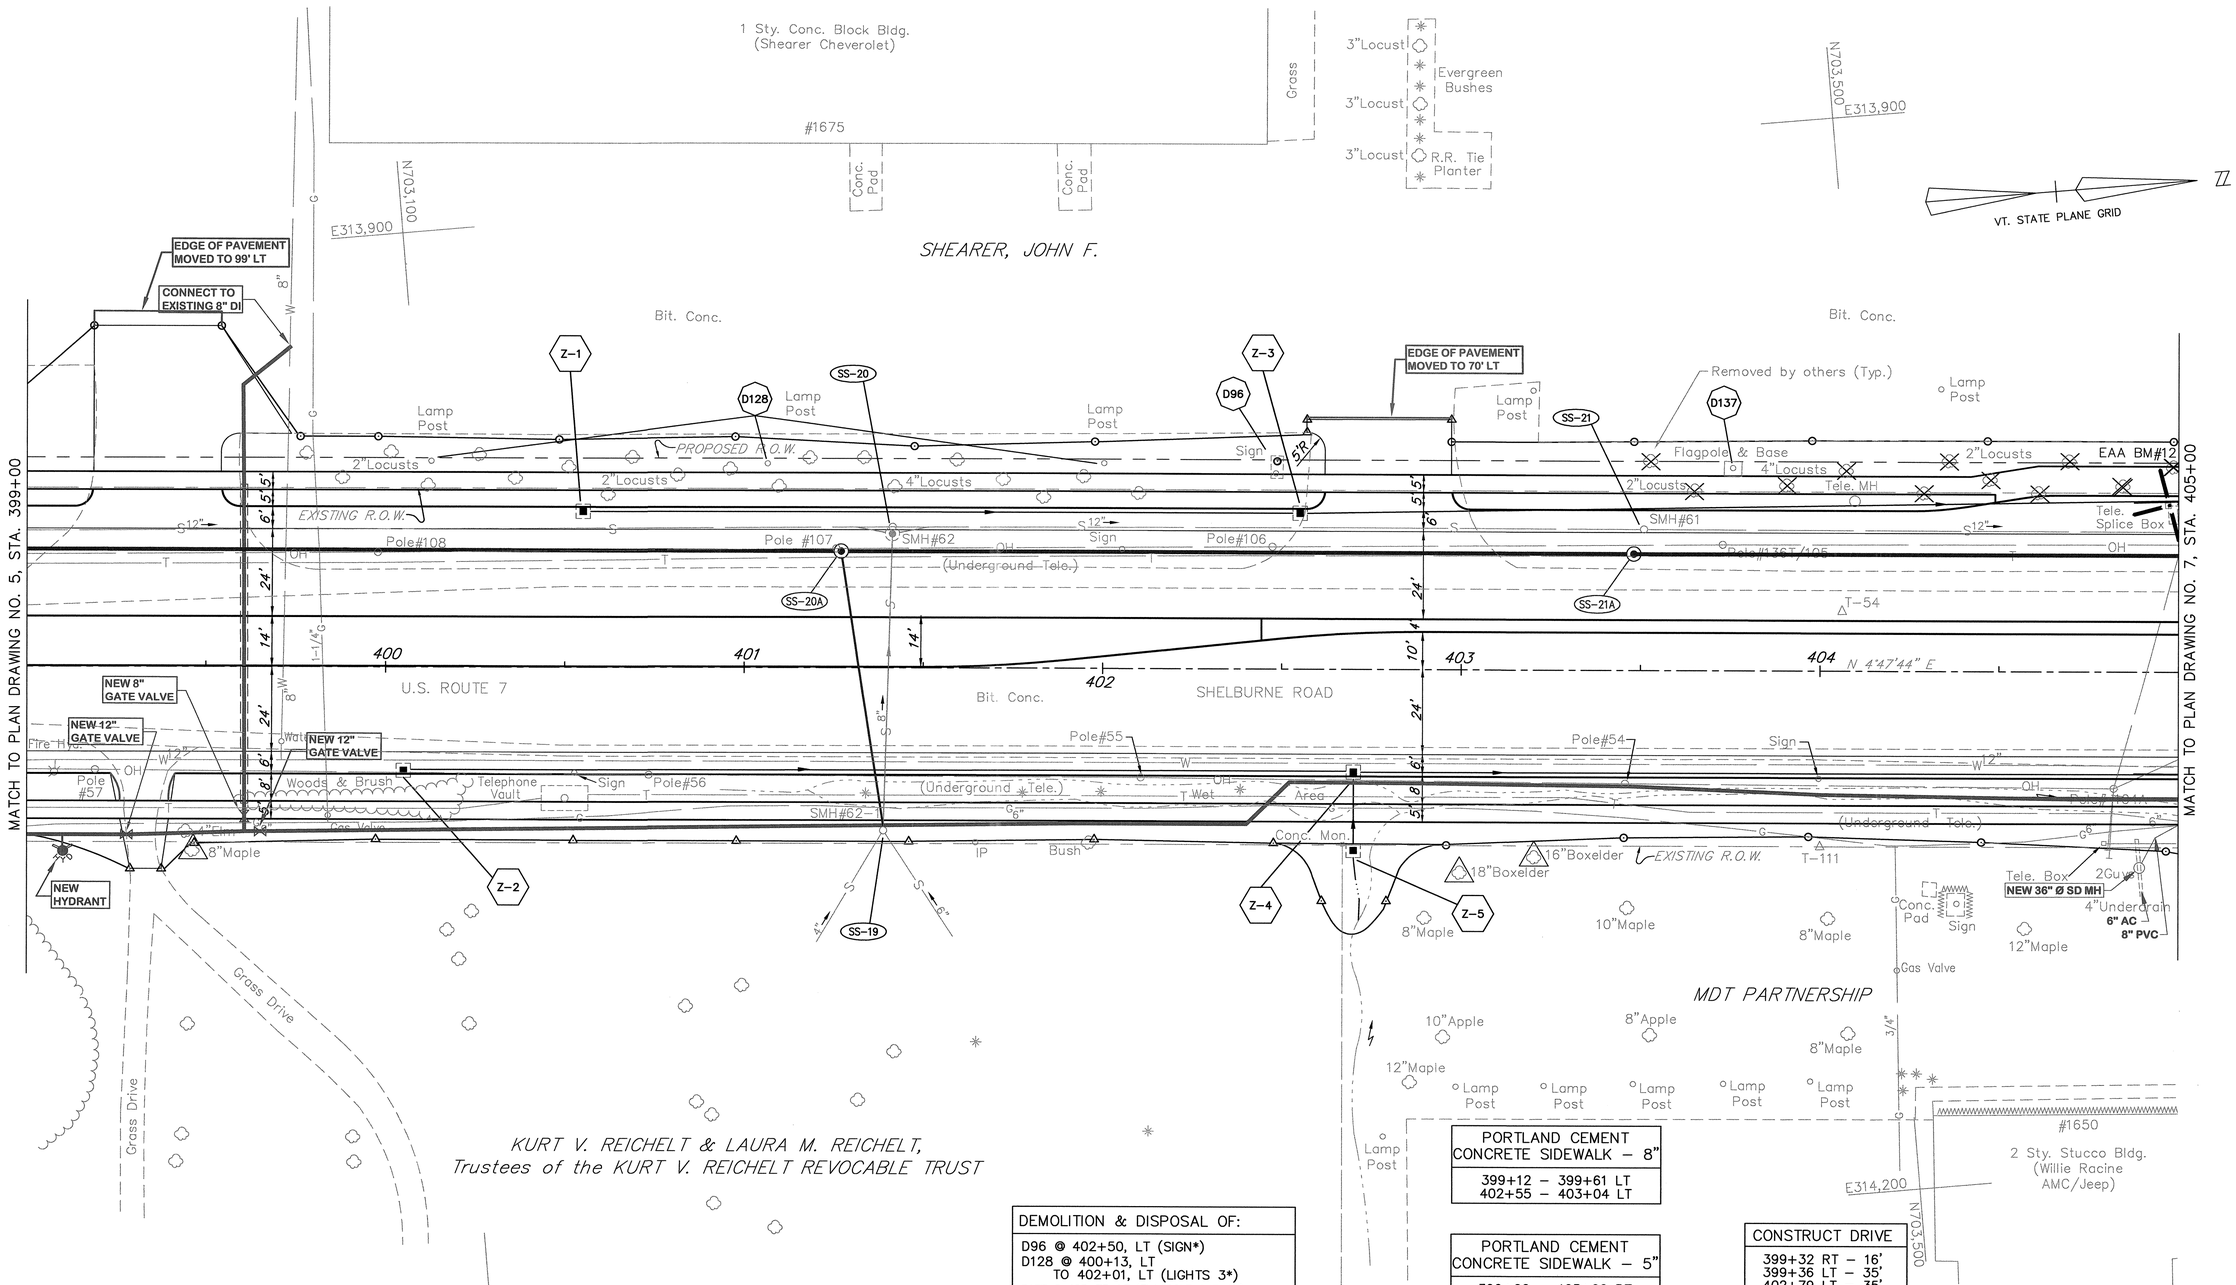

DEMOLITION & DISPOSAL OF:
D96 @ 402+50, LT (SIGN*)
D128 @ 400+13, LT TO 402+01, LT (LIGHTS 3*)
D137 @ 403+75, LT (FLAGPOLE & BASE)
* – REMOVED BY OTHERS AS OF JAN. 2003

PORTLAND CEMENT CONCRETE SIDEWALK – 8"
399+12 – 399+61 LT
402+55 – 403+04 LT

PORTLAND CEMENT CONCRETE SIDEWALK – 5"
399+00 – 405+00 RT
399+00 – 399+12 LT
399+61 – 402+55 LT
403+04 – 405+00 LT

CONSTRUCT DRIVE
399+32 RT – 16'
399+36 LT – 35'
402+79 LT – 35'

PORTLAND CEMENT CONCRETE SIDEWALK – 5" (MEDIAN WIDTH 4–6 FT.)
402+44 TO 405+00

NOTES:

1. *UNDERGROUND UTILITY LOCATIONS ARE PLOTTED BASED ON THE BEST AVAILABLE INFORMATION. LOCATIONS SHOULD BE VERIFIED BY THE CONTRACTOR BEFORE WORK.*
2. *SEE PLAN NOTES DRAWING NO. 1 FOR PLAN NOTES AND GENERAL NOTES.*
3. *VERIZON UNDERGROUND TELEPHONE (STA. 396+50 – STA. 405+50 RT) TO REMAIN.*

AS-BUILT LEGEND

- WATER AS-BUILTS
- SEWER AS-BUILTS
- DRAINAGE AS-BUILTS
- ELECTRICAL AS-BUILTS
- PAVEMENT \OTHER AS-BUILTS

AS-BUILT REVISIONS

NO.	DATE	DESCRIPTION
1.	3/3/06	UTILITIES & PAVEMENT ADDED
2.	8/9/06	STORM DRAIN NOTES UPDATED

FOR PROFILE SEE PROFILE DRAWING NO. 6

SCALE IN FEET
0 20 40

DATUM
VERTICAL NGVD 1929
HORIZONTAL NAD 1927

SHELBURNE – SOUTH BURLINGTON

SURVEYED BY V.S.C. INC. DATE
DRAWN BY E.A.A. INC. DATE
TRACED BY E.A.A. INC. DATE

PROJECT NH-EGC-019-4(28)
PLAN DRAWING NO. 6
SHEET NO. 74 OF 283

K:\633008 (US Rte 7 Shelburne Rd)\AS-BUILTS\WATER-SEWER\AS BUILT PL-28_4_06.DWG, Layout1, 8/1/2006 11:31:04 AM, parmata, \\vt-brl-fs01\VT-BRL-HP1055cm East