PLAN

NOTE BOOK NO.

SURVEYED
PLOTTED
ALIGNMENT CHECKED
RT. OF WAY CHECKED

BY DATE

PROFILE

NOTE BOOK NO.

SURVEYED
PLOTTED
GRADES CHECKED
B.M. NOTED
STRUCTURE NOTATNS CHKD

BY DATE

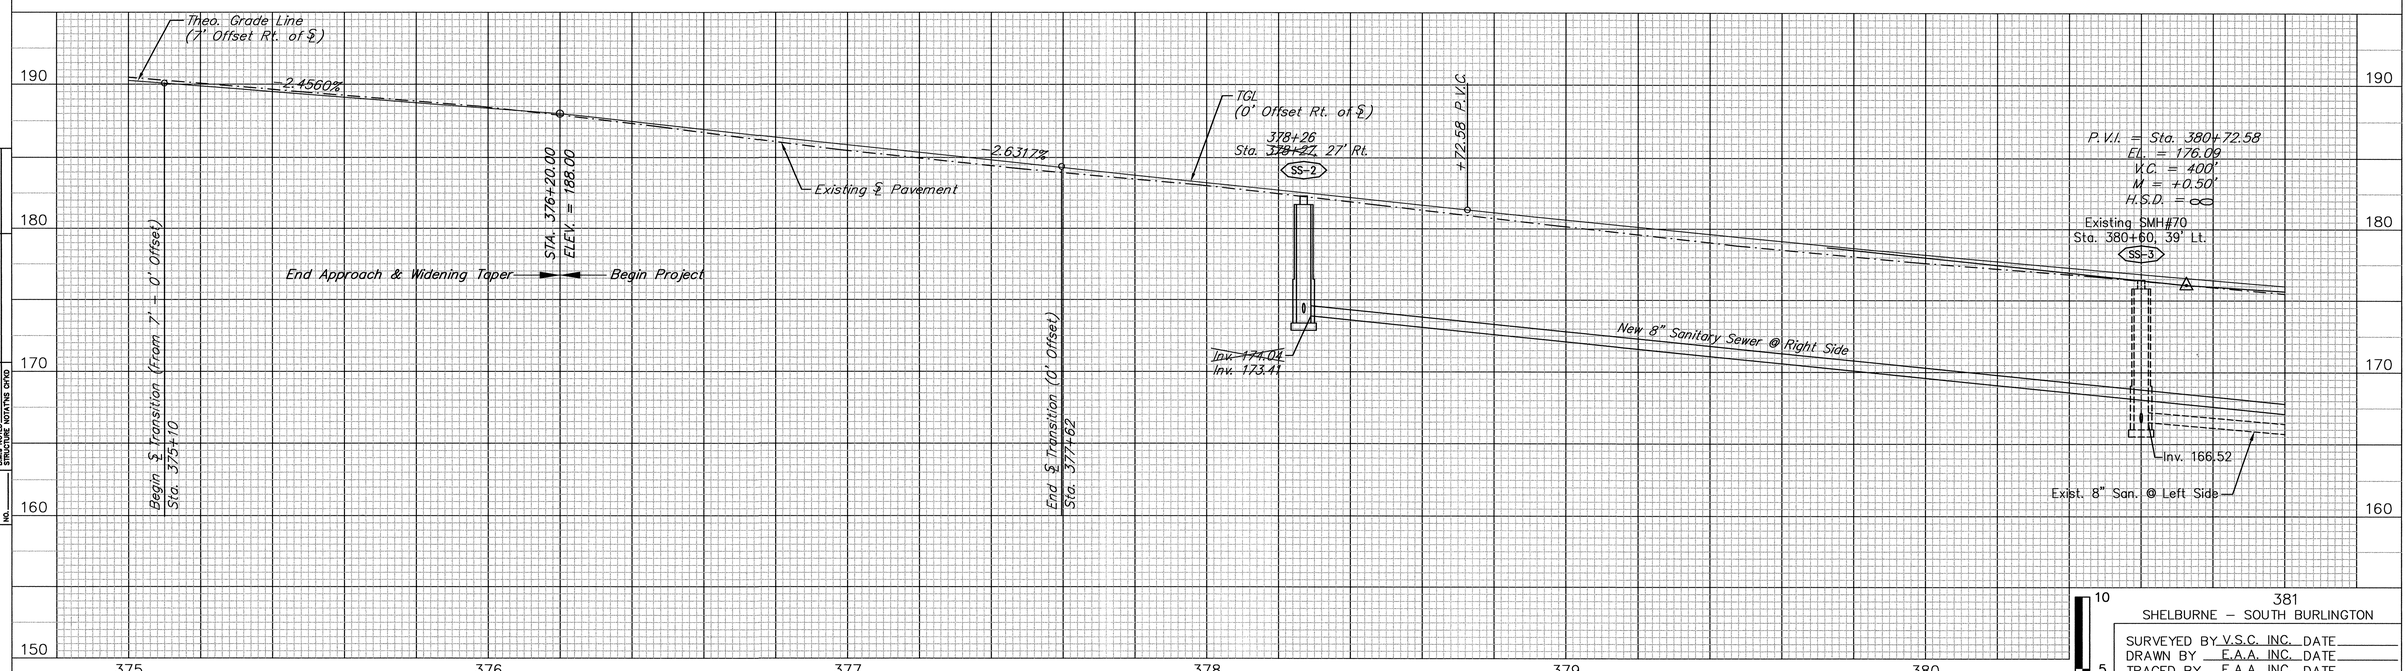

DATUM
VERTICAL NGVD 1929
HORIZONTAL NAD 1927

AS-BUILT REVISIONS

DATE	DESCRIPTION
2/06	SEWER UPDATES

FOR PLAN SEE PLAN DRAWING NO. 2

SCALE IN FEET
0 20 40

10 5 0

SHELBURNE – SOUTH BURLINGTON

SURVEYED BY V.S.C. INC. DATE
DRAWN BY E.A.A. INC. DATE
TRACED BY E.A.A. INC. DATE

PROJECT NH-EGC-019-4(28)
PROFILE DRAWING NO. 2
SHEET NO. 81 OF 283

C:\6330008 (US Rte 7 Shelburne Rd)\AS-BUILTS\WATER-SEWER\AS-BUILT SEWER PR-24_4_02.DWG, 3/3/2006 8:49:00 AM