

LEGEND

- STREET LIGHT POLE
- UTILITY POLE
- LUMINAIRE
- ⊙ STRAIN POLE W/ MAST ARM
- PEDESTRIAN POLE
- PULL BOX OR JUNCTION BOX
- SIGNAL CONDUIT
- - - INTERCONNECT CABLE CONDUIT
- - - LIGHTING CONDUIT
- ⊕ SIGN MOUNTING POST(S)
- ⊕ OVERHEAD MOUNTED SIGN


[PB] = SIGNAL PULLBOX NUMBER
 [JB] = INTERCONNECT JUNCTION BOX NUMBER
 [JB] = LIGHTING JUNCTION BOX NUMBER
 [PB] = POWER SOURCE PULLBOX NUMBER

OVERHEAD SIGN ARRANGEMENT

⊙ MAST ARM CANTILEVERS

- (A) ONLY
- (B) ONLY
- (C) SHELburne RD
- (D) HOLMES RD
- (E) IDX DR

* FIBER OPTIC SIGNAL

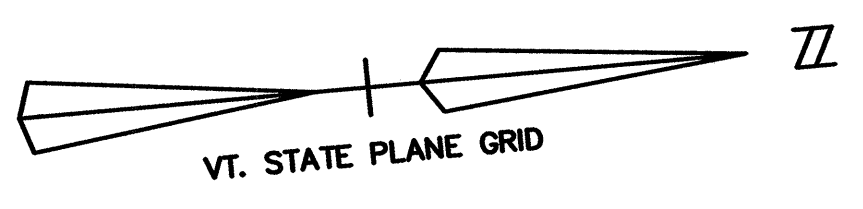

GENERAL NOTES:

- SEE LIGHTING DRAWINGS NO'S. 1 THROUGH 10 FOR LIGHTING CONDUITS, JUNCTION BOXES, WIRING AND SLEEVES.
- SEE LIGHTING DRAWINGS NO'S. 1 THROUGH 10 FOR INTERCONNECT CONDUITS, JUNCTION BOXES, WIRING AND SLEEVES
- SEE SIGNAL DRAWINGS NO'S. 1 THROUGH 6 FOR SIGNAL CONDUITS, PULLBOXES, WIRING, POLES AND SLEEVES.
- INTERCONNECTING CABLE SHALL BE PLACED IN 2" PVC SCHEDULE 40 CONDUIT
- SEE TYPICAL SECTION DRAWING NO. 5 FOR TYPICAL CONDUIT PLACEMENT DETAIL.

SIGN NOTES:

- THE CONTRACTOR SHALL PROVIDE APPROPRIATE HARDWARE TO TOP MOUNT THE STREET NAME SIGNS, INCIDENTAL TO THE TRAFFIC SIGN ITEMS.
- SIGNS ON THE MAST ARMS SHALL BE MOUNTED WITH BLACK HARDWARE ARE TO MATCH THE MAST ARM AND SHALL BE PAID UNDER ITEM 675.20, TRAFFIC SIGNS, TYPE A.
- ALL SIGNS AND POSTS ARE NEW UNLESS OTHERWISE NOTED.
- CCTA BUS STOP SIGNS TO BE OBTAINED FROM CCTA.

AS-BUILT REVISIONS		
NO.	DATE	DESCRIPTION
1.	6/29/06	NOTES ADDED PER ENGINEERS MARK UPS

AS-BUILT LEGEND


- WATER AS-BUILTS
- SEWER AS-BUILTS
- DRAINAGE AS-BUILTS
- ELECTRICAL AS-BUILTS
- PAVEMENT / OTHER AS-BUILTS

SHELburne - SOUTH BURLINGTON

SURVEYED BY V.S.C. INC. DATE _____
 DRAWN BY E.A.A. INC. DATE _____
 TRACED BY E.A.A. INC. DATE _____

PROJECT NH-EGC-019-4(28)
 SIGN AND STRIPING DRAWING NO. 10
 SHEET NO. 102 OF 283

DATUM
 VERTICAL NGVD 1929
 HORIZONTAL NAD 1927

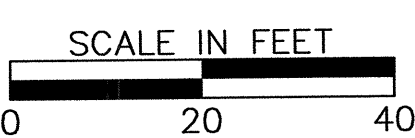

4/4/03