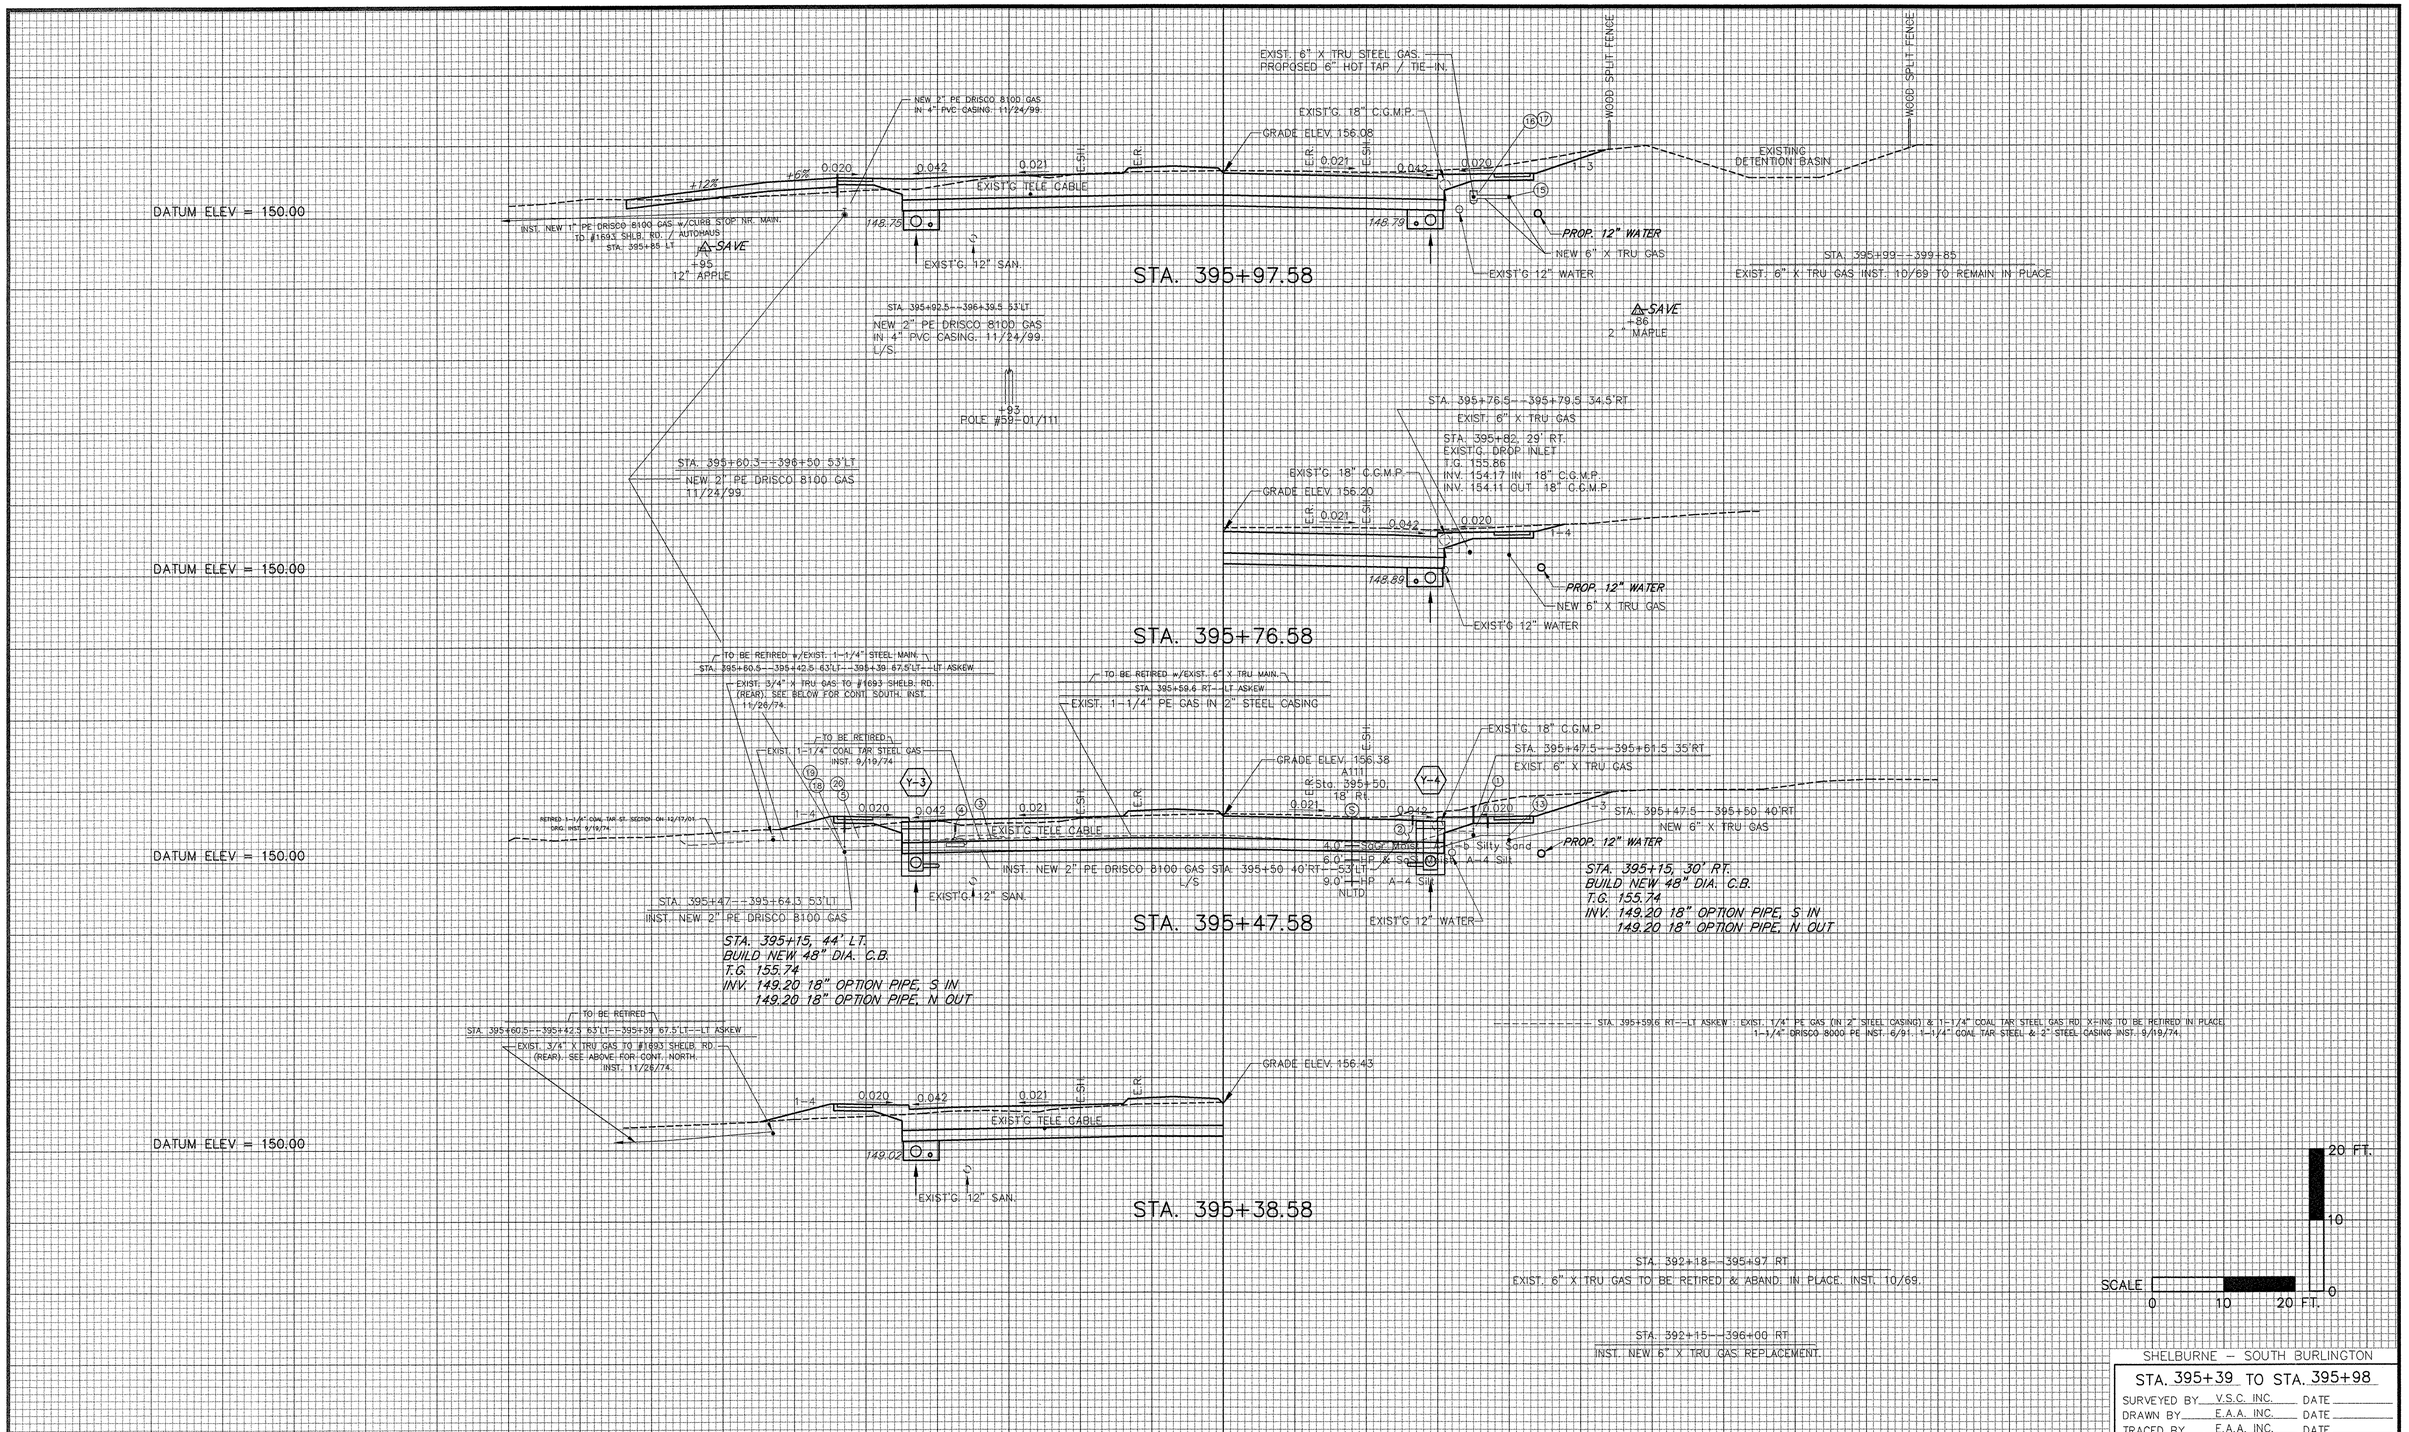

ERDMAN ANTHONY
CONSULTING ENGINEERS
Rochester, New York Camp Hill, Pennsylvania
Boston, Massachusetts

4/4/03

SHELBURNE - SOUTH BURLINGTON

STA. 395+39 TO STA. 395+98

SURVEYED BY V.S.C. INC. DATE
DRAWN BY E.A.A. INC. DATE
TRACED BY E.A.A. INC. DATE

PROJECT NH-EGC-019-4(28)

CROSS-SECTION DWG. NO. 100

SHEET 192 OF 283