
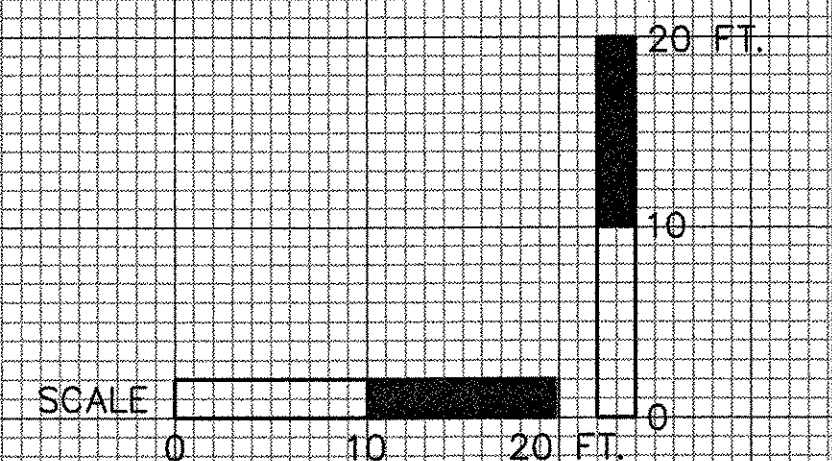


DATUM ELEV = 145.00

DATUM ELEV = 145.00

DATUM ELEV = 145.00

DATUM ELEV = 145.00

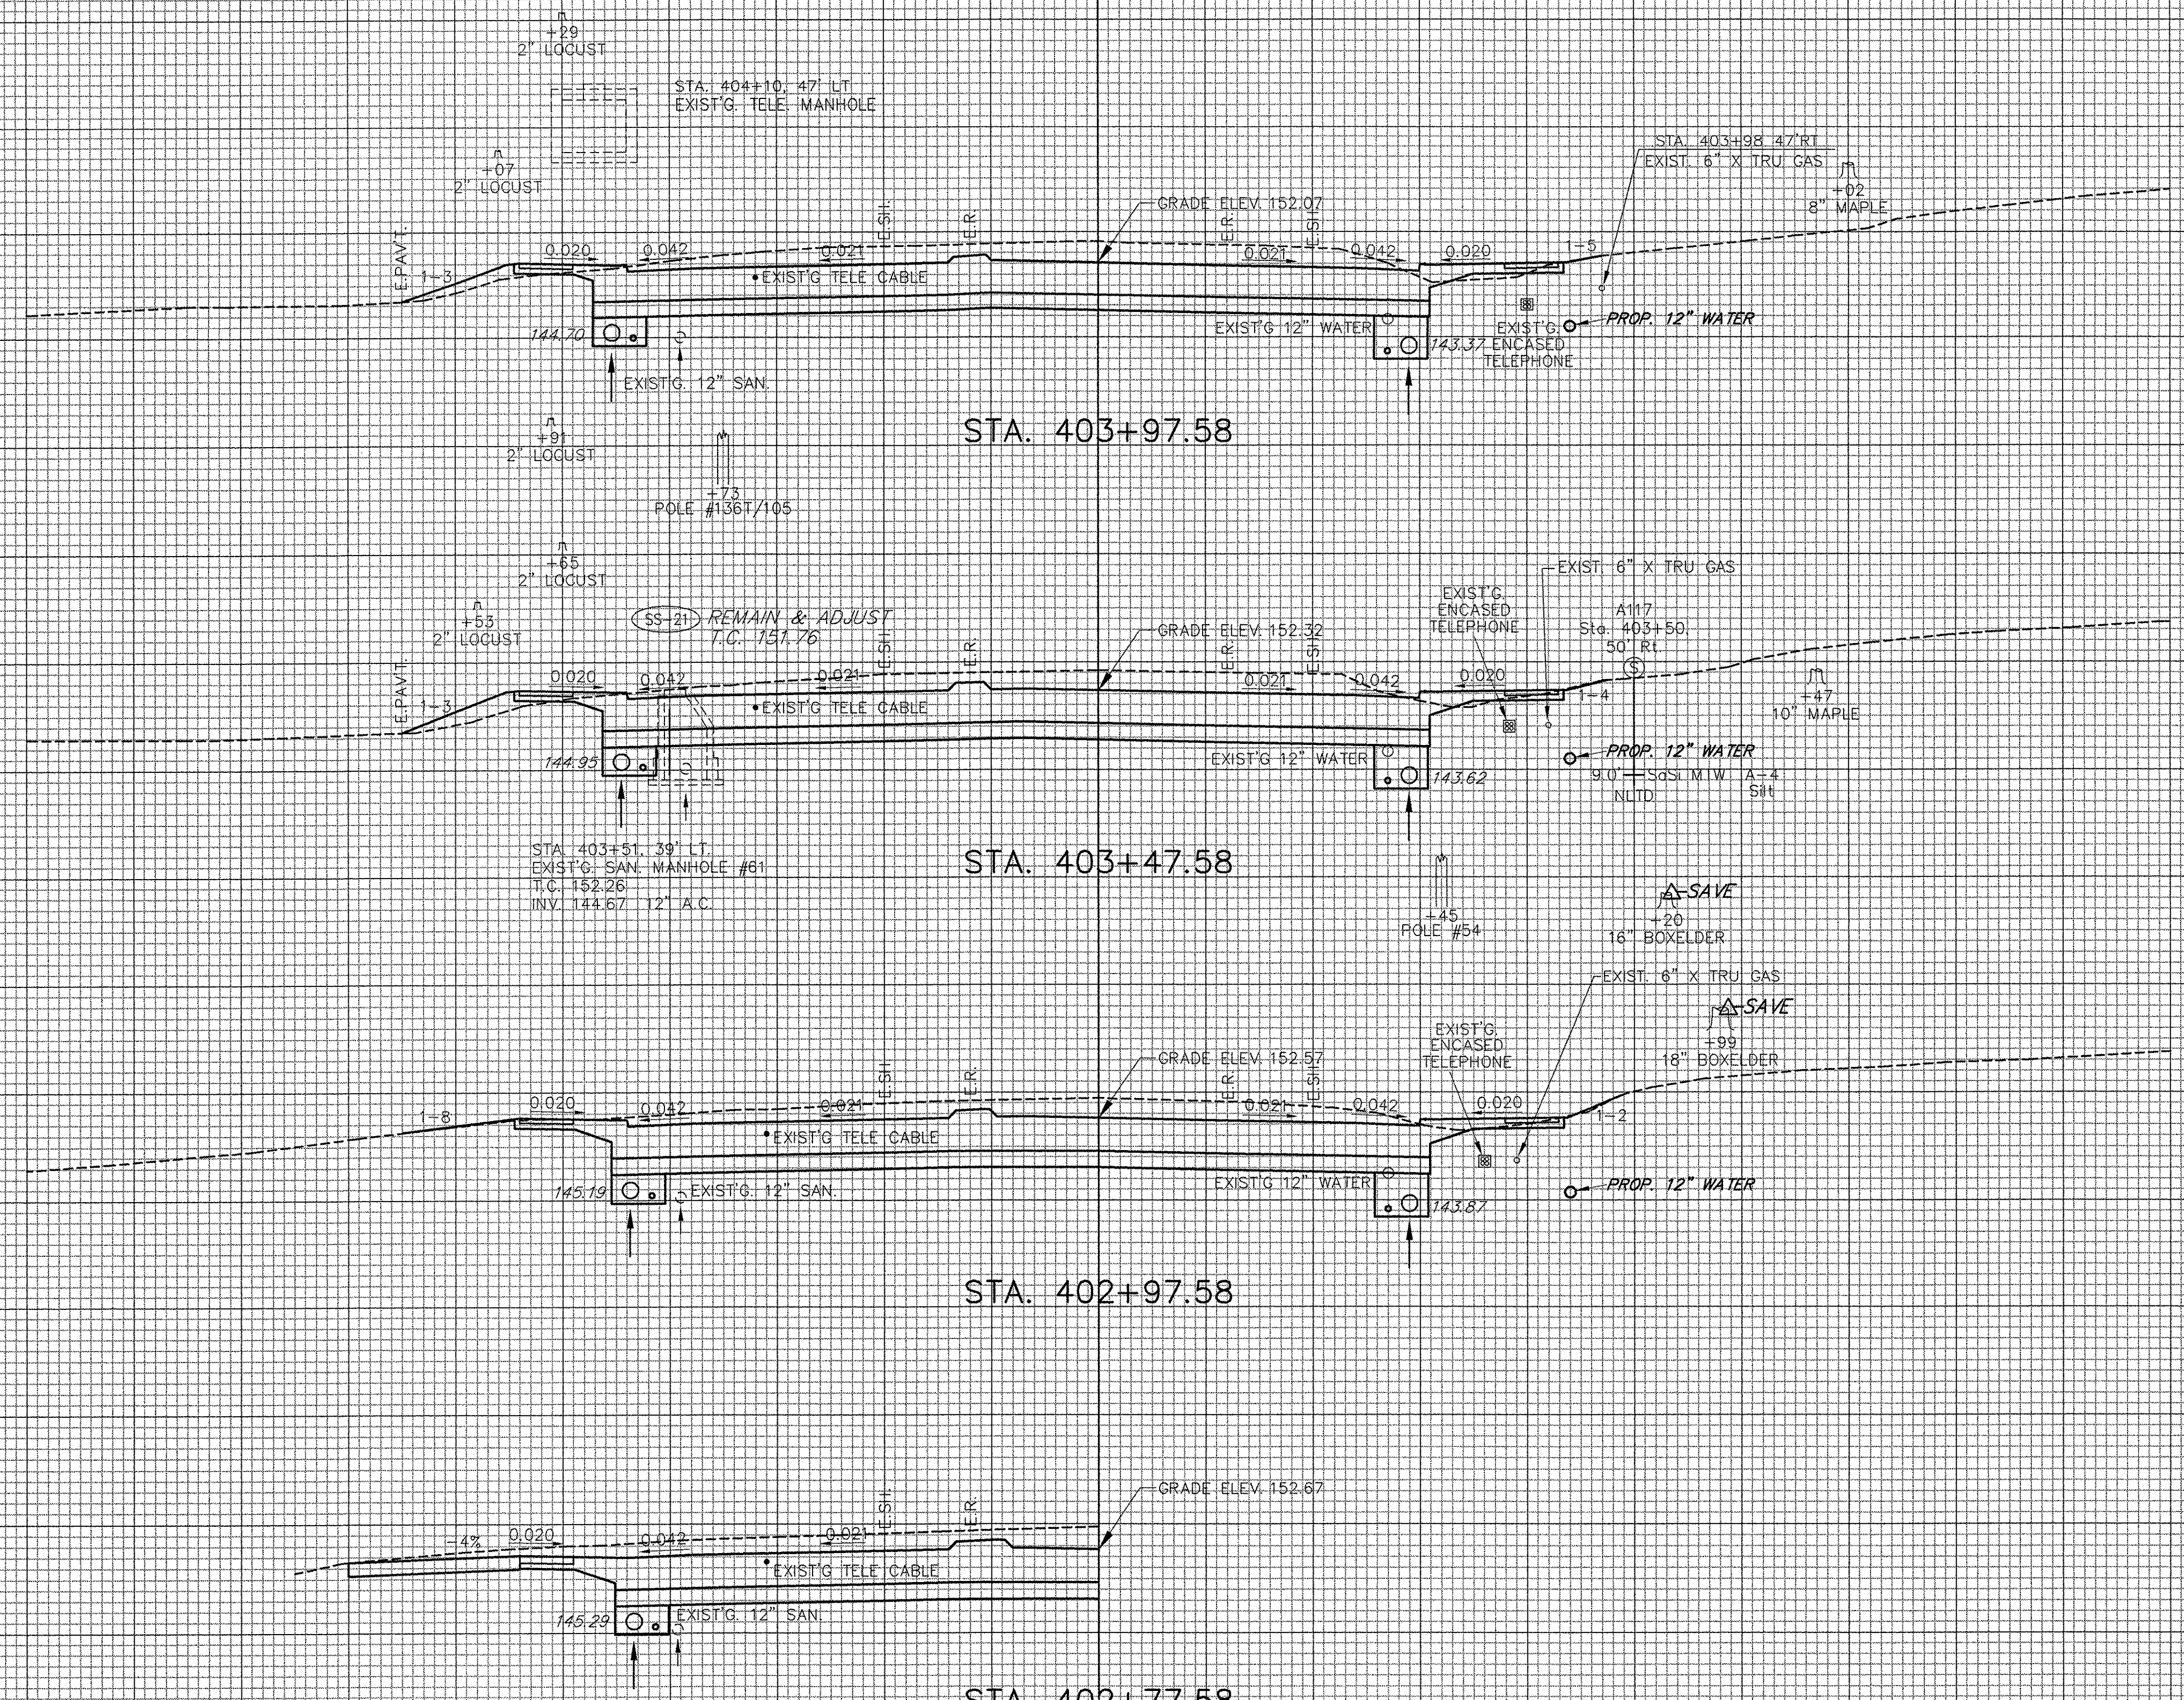

STA. 401+00 - 405+80.5 RT
 EXIST. 6" X TRU GAS TO REMAIN IN PLACE

SHELburnE - SOUTH BURLINGTON

STA. 402+78 TO STA. 403+98

SURVEYED BY V.S.C. INC. DATE _____
 DRAWN BY E.A.A. INC. DATE _____
 TRACED BY E.A.A. INC. DATE _____

PROJECT NH-EGC-019-4(28)
 CROSS-SECTION DWG. NO. 105

SHEET 197 OF 283