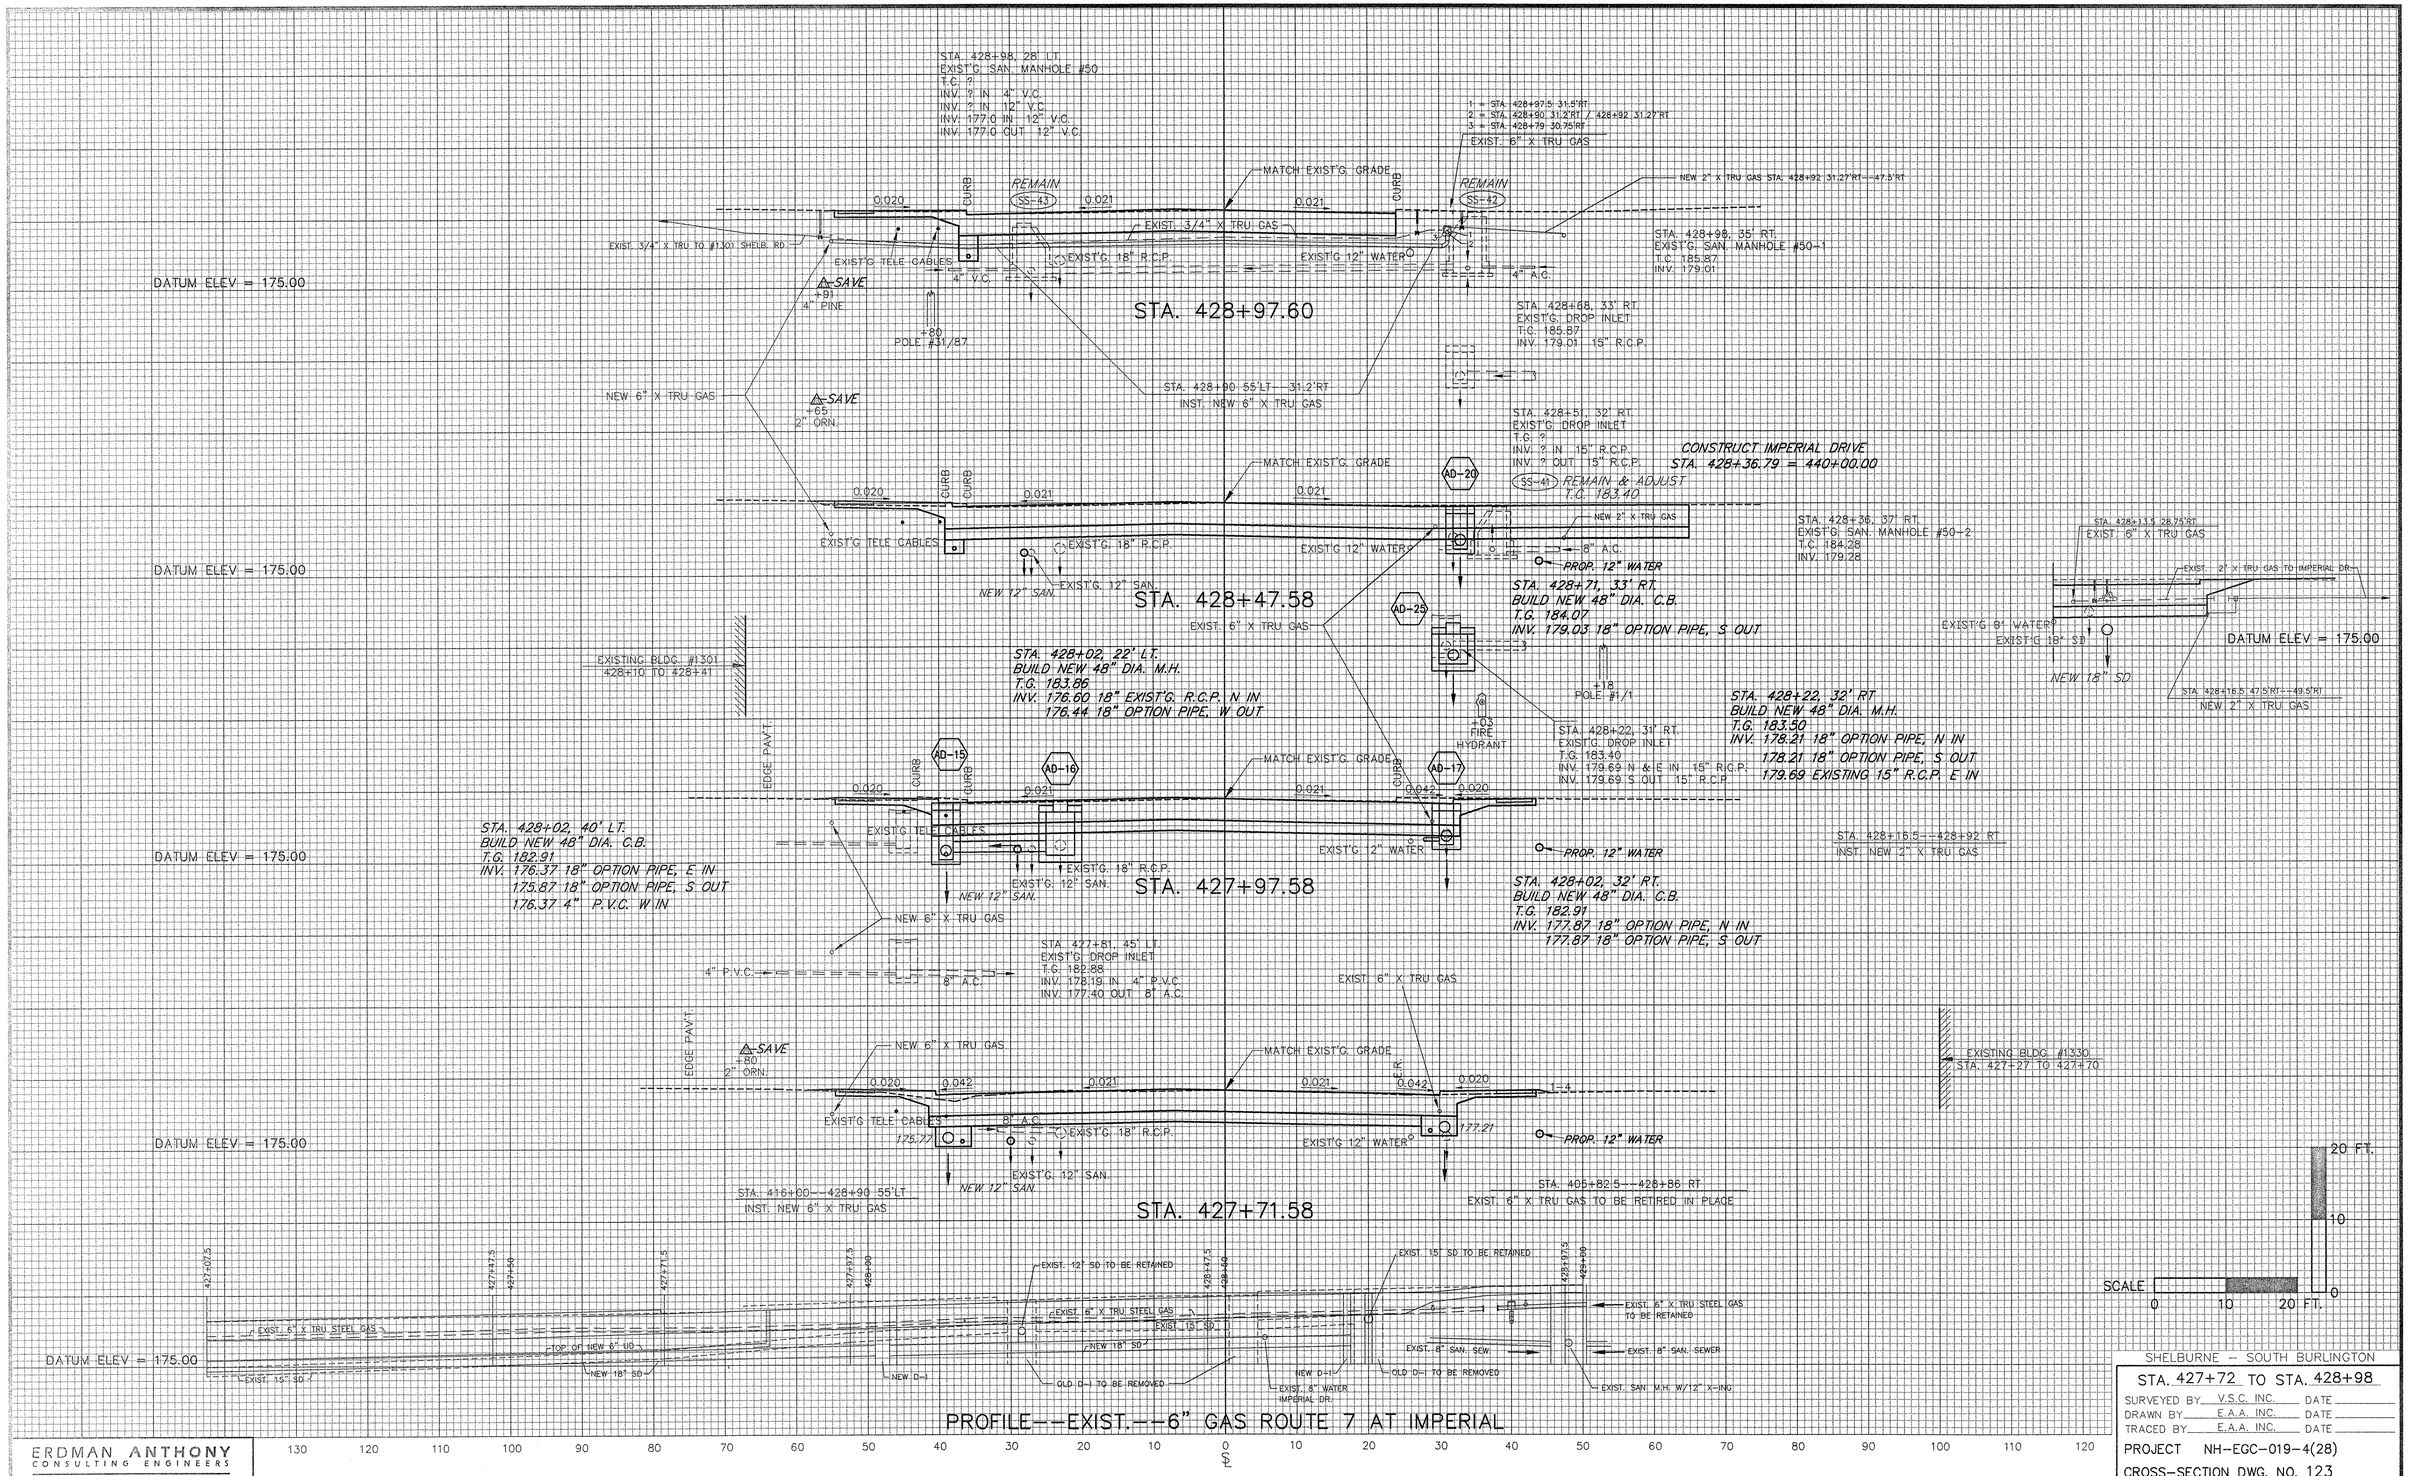

ERDMAN ANTHONY
CONSULTING ENGINEERS
Rochester, New York Camp Hill, Pennsylvania
Boston, Massachusetts

4/4/03

SHELBURNE - SOUTH BURLINGTON
STA. 427+72 TO STA. 428+98
SURVEYED BY V.S.C. INC. DATE
DRAWN BY E.A.A. INC. DATE
TRACED BY E.A.A. INC. DATE
PROJECT NH-EGC-019-4(28)
CROSS-SECTION DWG. NO. 123
SHEET 215 OF 283