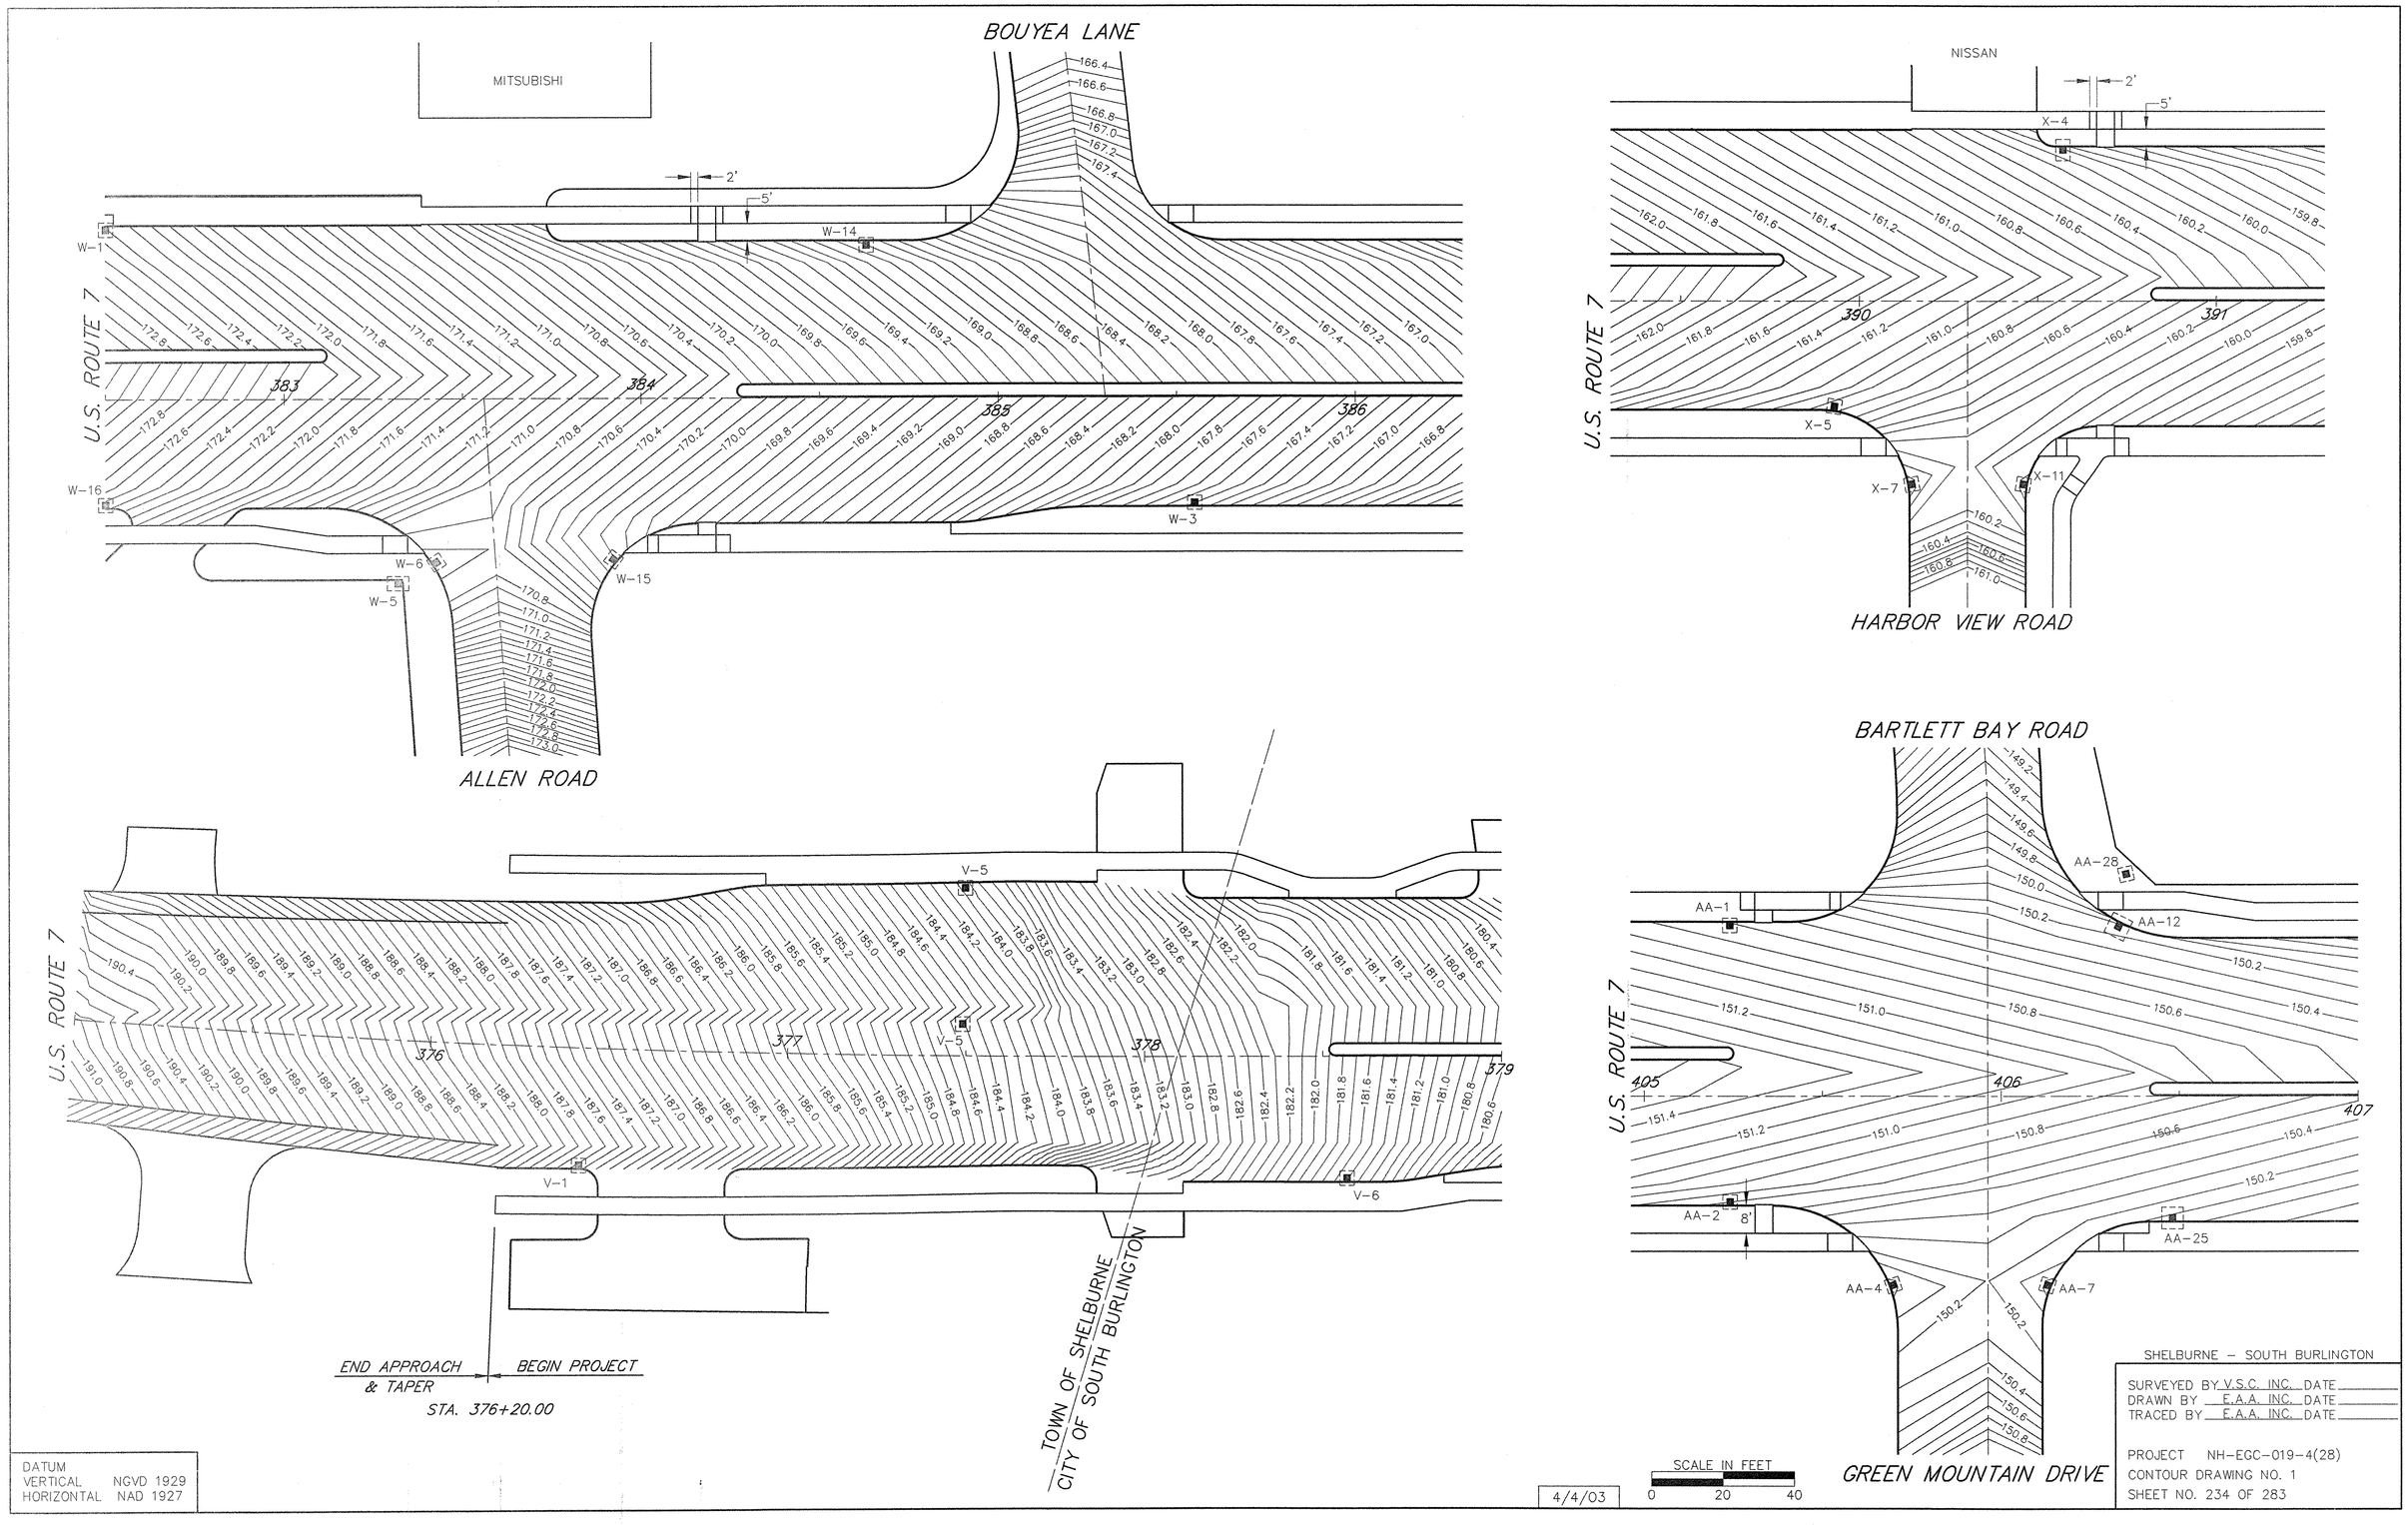
BOUYEA LANE
MITSUBISHI
U.S. ROUTE 7
ALLEN ROAD
NISSAN
HARBOR VIEW ROAD
BARTLETT BAY ROAD
GREEN MOUNTAIN DRIVE
TOWN OF SHELBURNE
CITY OF SOUTH BURLINGTON
END APPROACH & TAPER
BEGIN PROJECT
STA. 376+20.00
SCALE IN FEET
0 20 40
DATUM
VERTICAL NGVD 1929
HORIZONTAL NAD 1927
4/4/03
SHELBURNE – SOUTH BURLINGTON
SURVEYED BY V.S.C. INC. DATE
DRAWN BY E.A.A. INC. DATE
TRACED BY E.A.A. INC. DATE
PROJECT NH-EGC-019-4(28)
CONTOUR DRAWING NO. 1
SHEET NO. 234 OF 283