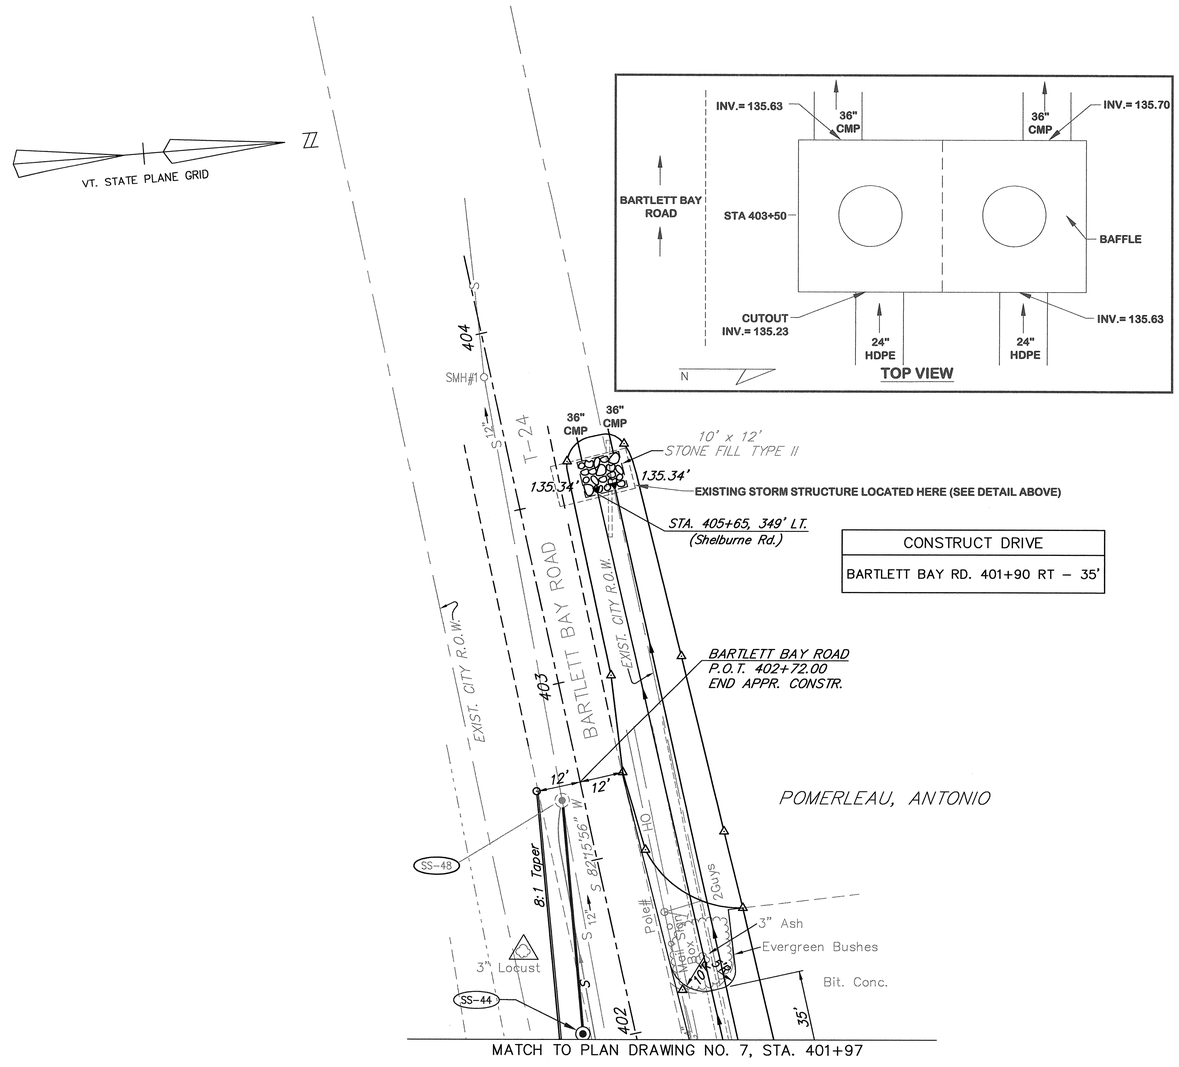

AS-BUILT LEGEND

- WATER AS-BUILTS
- SEWER AS-BUILTS
- DRAINAGE AS-BUILTS
- ELECTRICAL AS-BUILTS
- PAVEMENT \OTHER AS-BUILTS

NOTES:

1. *UNDERGROUND UTILITY LOCATIONS ARE PLOTTED BASED ON THE BEST AVAILABLE INFORMATION. LOCATIONS SHOULD BE VERIFIED BY THE CONTRACTOR BEFORE WORK.*
2. *SEE PLAN NOTES DRAWING NO. 1 FOR PLAN NOTES AND GENERAL NOTES.*

FOR PROFILE SEE PROFILE DRAWING NO. 11

AS-BUILT REVISIONS

NO.	DATE	DESCRIPTION
1.	3/3/06	ADDED DRAINAGE DETAIL
2.	8/9/06	SEWER STRUCTURE SS-44 ADDED

SCALE IN FEET
0 20 40

DATUM
VERTICAL NGVD 1929
HORIZONTAL NAD 1927

SHELBURNE – SOUTH BURLINGTON

SURVEYED BY V.S.C. INC. DATE
DRAWN BY E.A.A. INC. DATE
TRACED BY E.A.A. INC. DATE

PROJECT NH-EGC-019-4(28)
PLAN DRAWING NO. 11
SHEET NO. 79 OF 283

K:\6530008 (US Rte 7 Shelburne Rd)\AS-BUILTS\WATER-SEWER\AS BUILT PL-35_4_11.DWG, Layout1, 9/12/2006 1:38:53 PM, parmatis, \\vt-bri-fs01\VT-BRL-HP1055cm East