PLAN

NOTE BOOK NO.	SURVEYED	BY	DATE
	PLOTTED		
	ALIGNMENT CHECKED		
	RT. OF WAY CHECKED		

PROFILE

NOTE BOOK NO.	SURVEYED	BY	DATE
	PLOTTED		
	GRADES CHECKED		
	STRUCTURE NOTATNS CHKD		

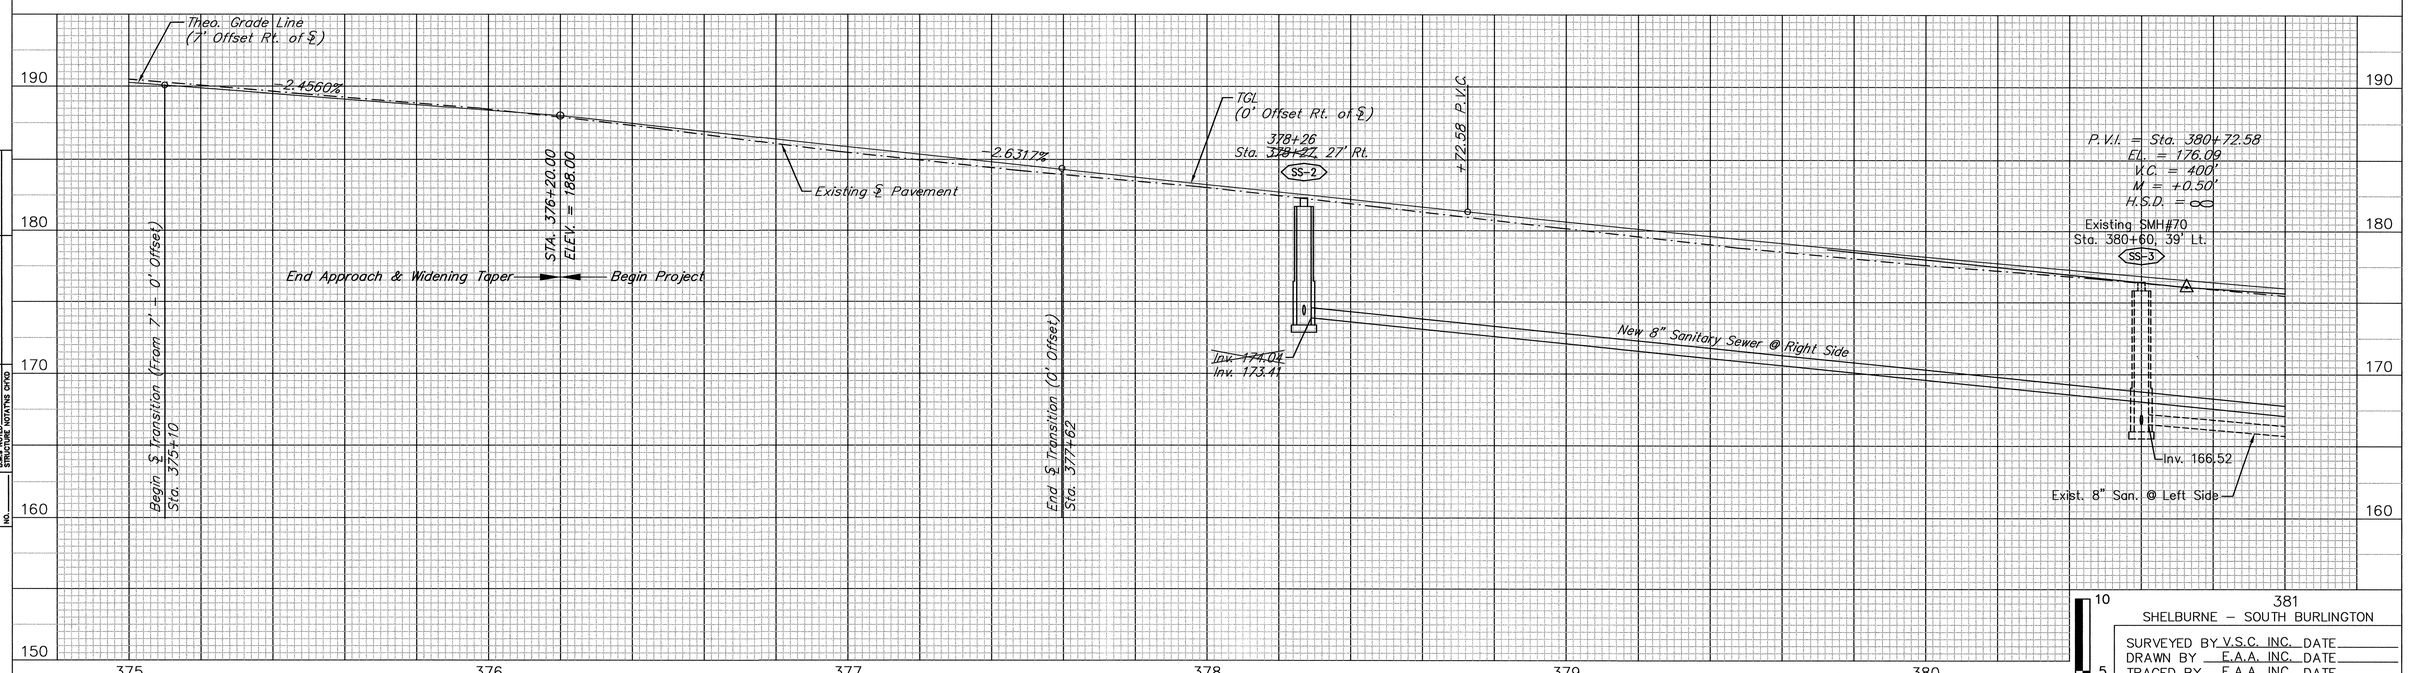

DATUM
VERTICAL NGVD 1929
HORIZONTAL NAD 1927

AS-BUILT REVISIONS

DATE	DESCRIPTION
2/06	SEWER UPDATES

FOR PLAN SEE PLAN DRAWING NO. 2

SCALE IN FEET
0 20 40
10 5 0

SHELBURNE – SOUTH BURLINGTON

SURVEYED BY V.S.C. INC. DATE
DRAWN BY E.A.A. INC. DATE
TRACED BY E.A.A. INC. DATE

PROJECT NH-EGC-019-4(28)
PROFILE DRAWING NO. 2
SHEET NO. 81 OF 283

C:\6330008 (US Rte 7 Shelburne Rd)\AS-BUILTS\WATER-SEWER\AS-BUILT SEWER PR-24_4_02.DWG, 3/3/2006 8:49:00 AM