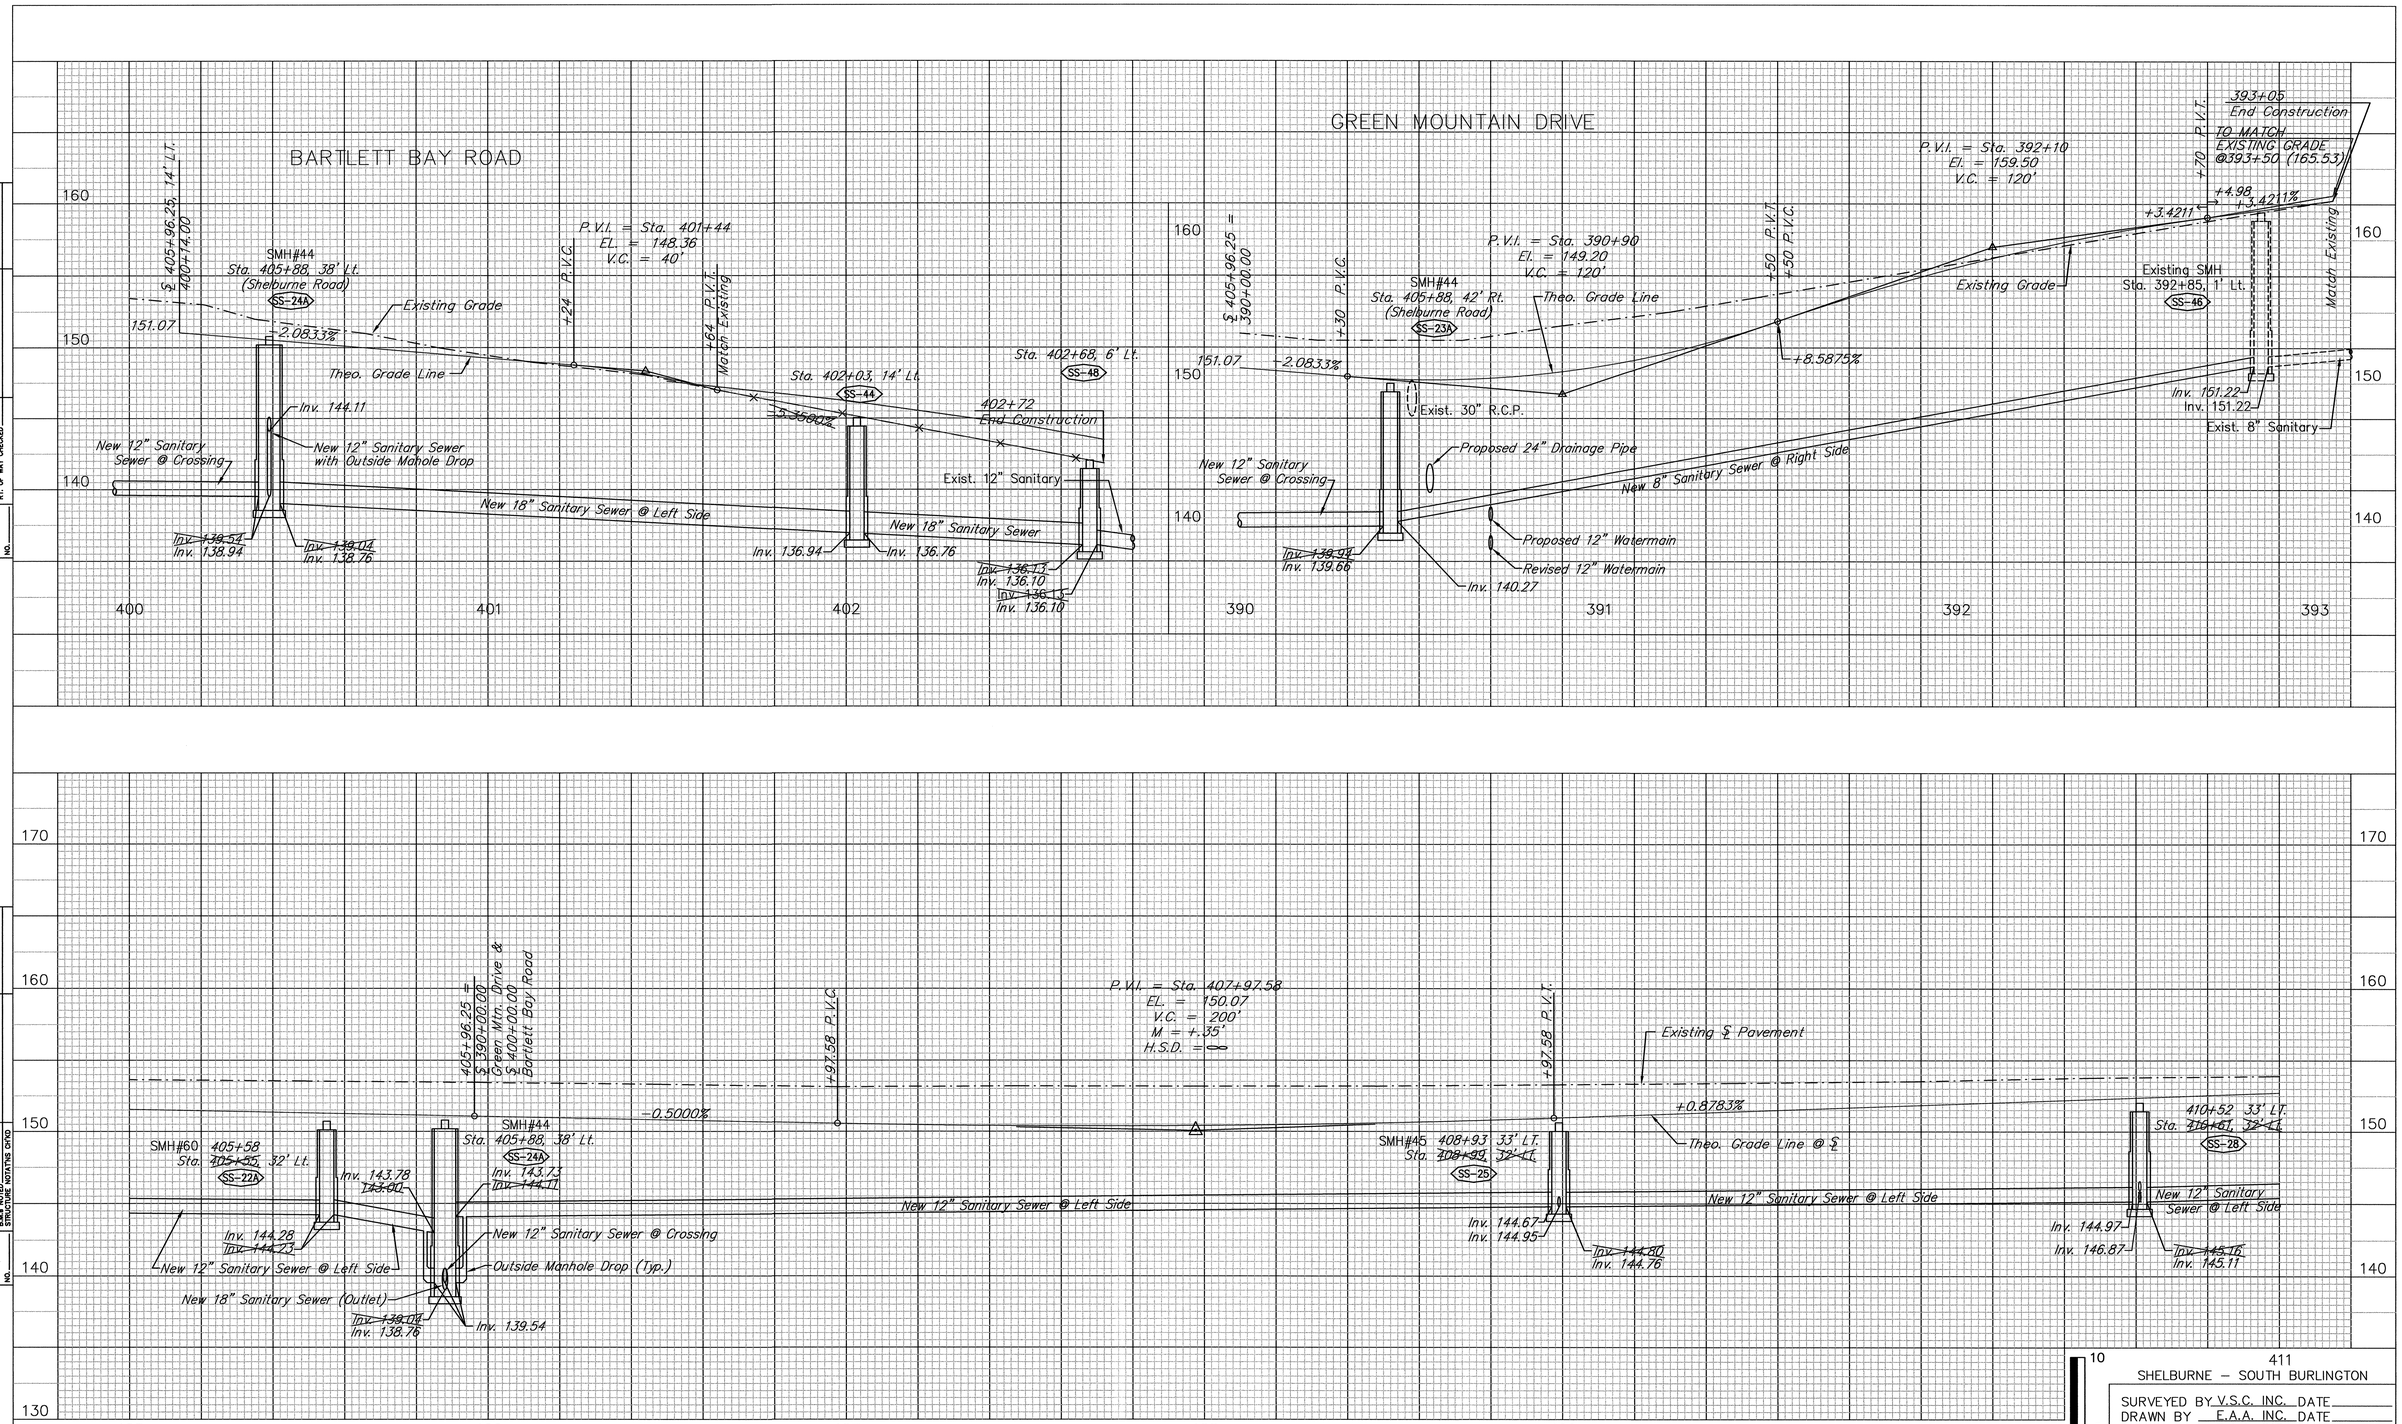

C:\6330008 (US Rte 7 Shelburne Rd)\AS-BUILTS\WATER-SEWER\AS-BUILT SEWER PR-29_4_07.DWG, 8/9/2006 3:38:12 PM