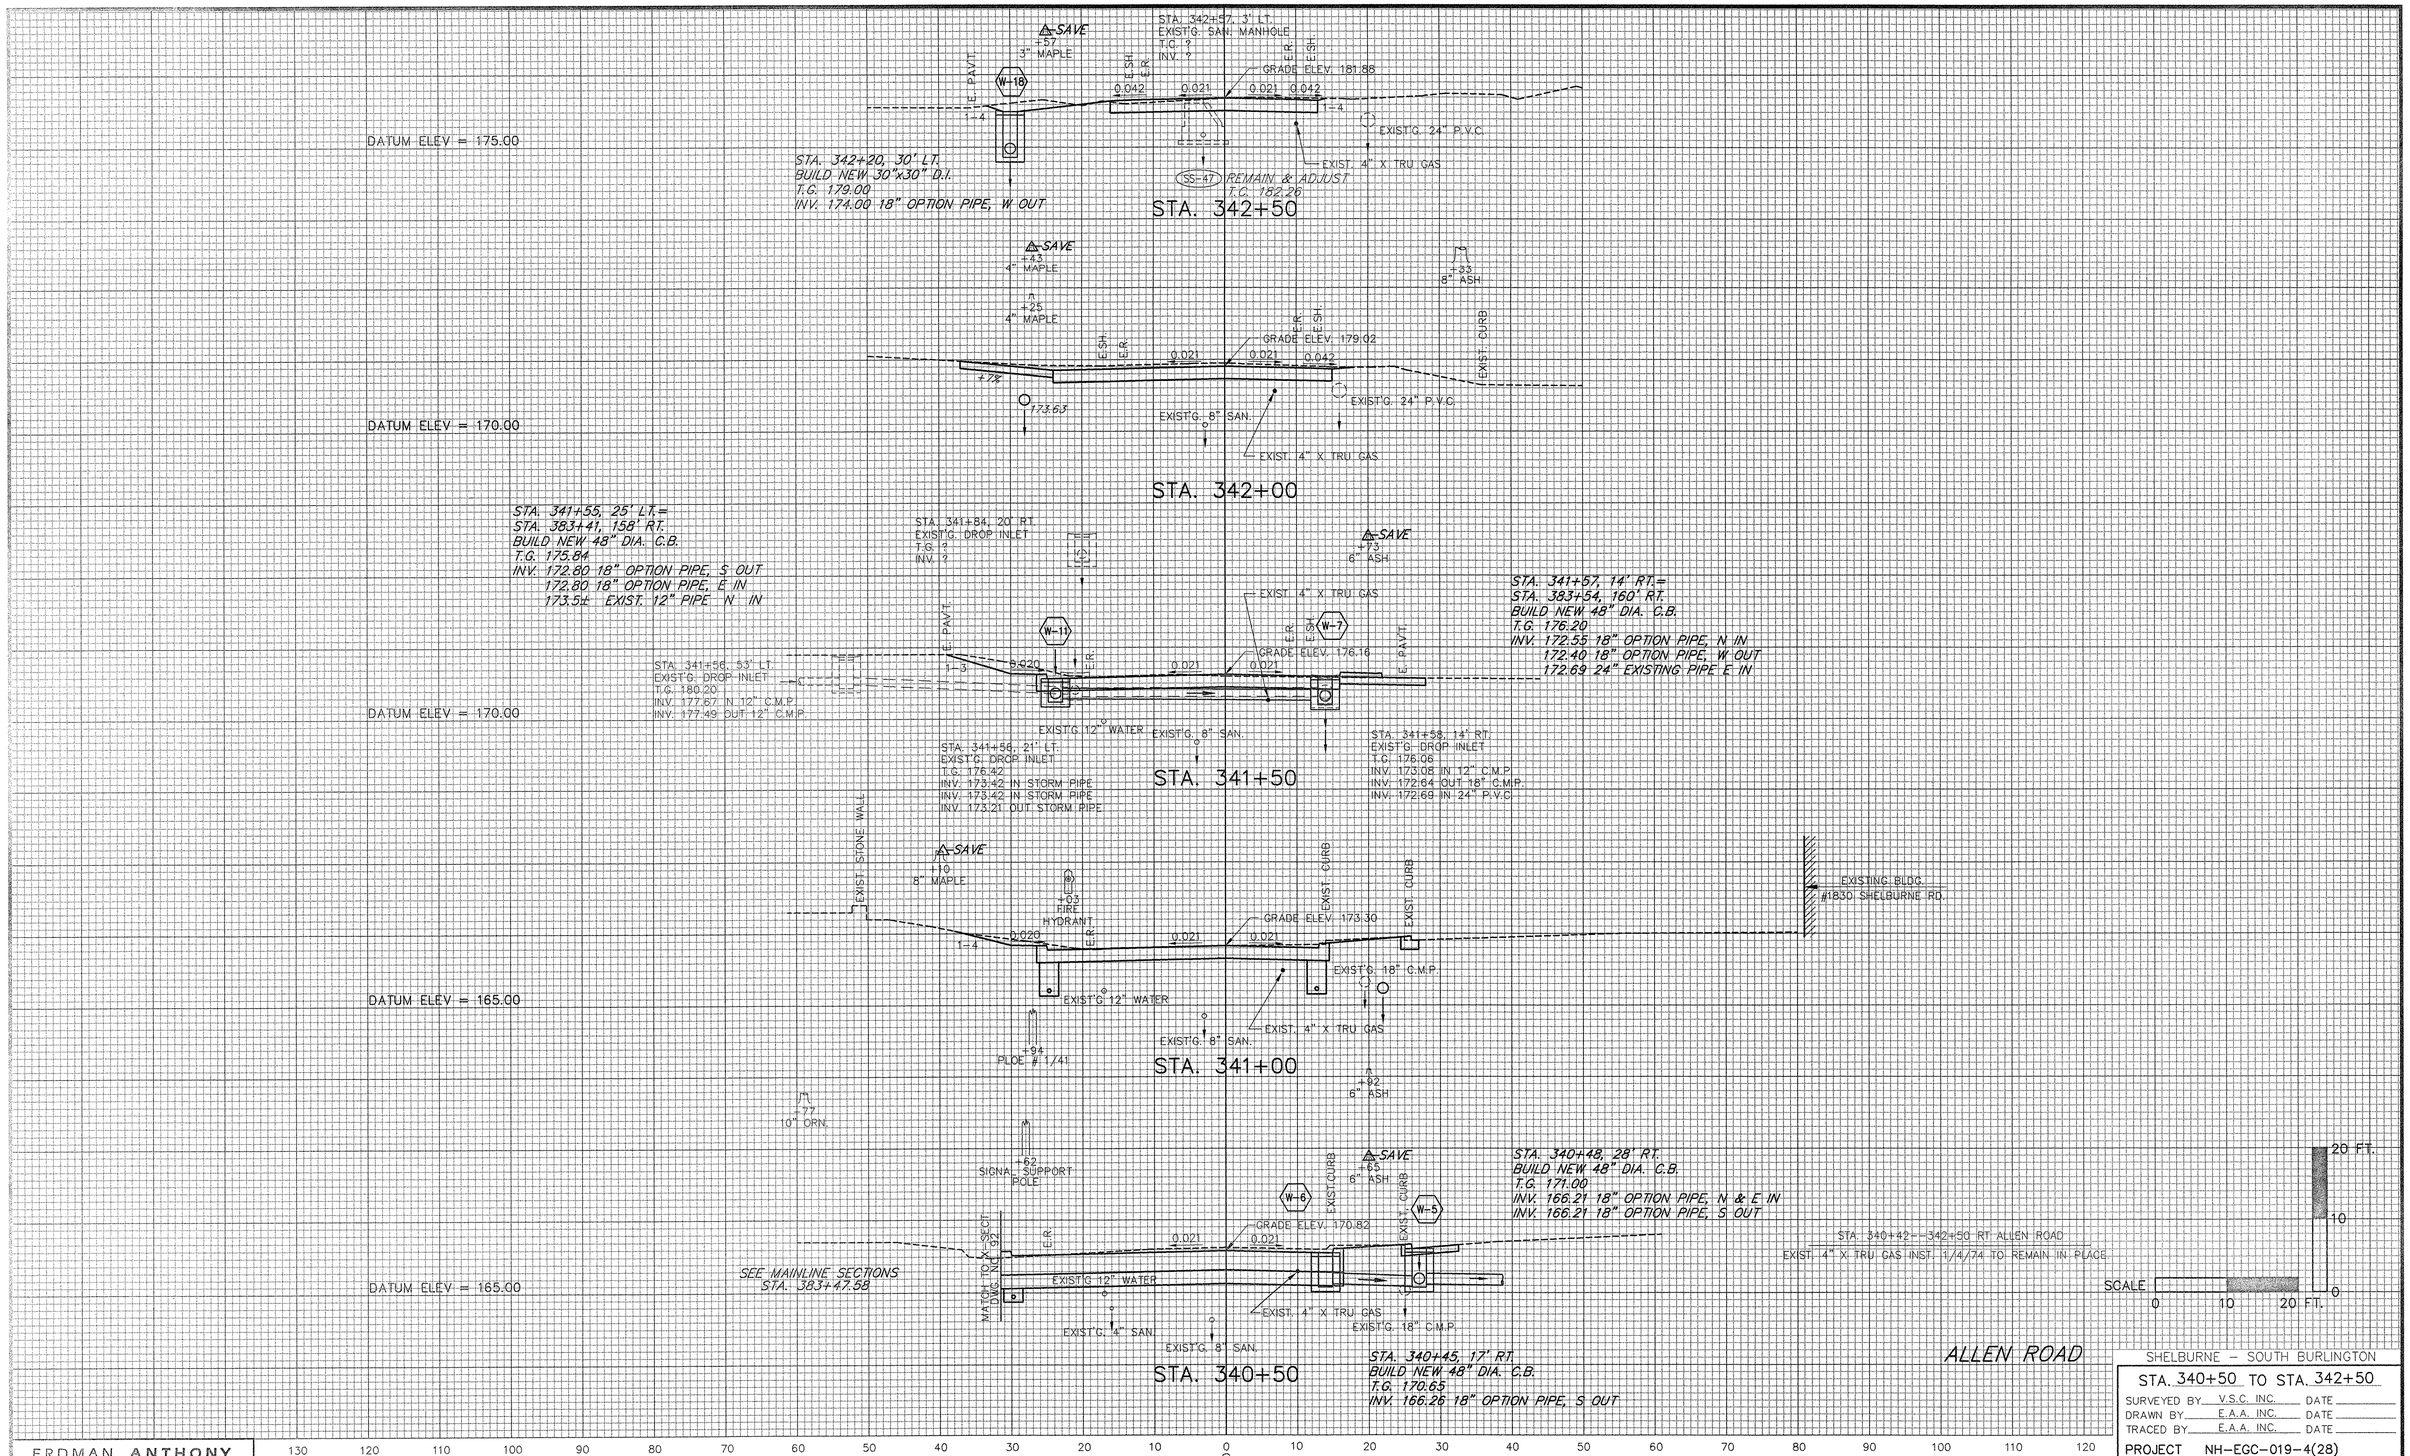

ERDMAN ANTHONY
CONSULTING ENGINEERS
Rochester, New York Camp Hill, Pennsylvania
Boston, Massachusetts

4/4/03

SHELBURNE – SOUTH BURLINGTON

STA. 340+50 TO STA. 342+50

SURVEYED BY V.S.C. INC. DATE
DRAWN BY E.A.A. INC. DATE
TRACED BY E.A.A. INC. DATE

PROJECT NH-EGC-019-4(28)
CROSS-SECTION DWG. NO. 144
SHEET 216 OF 283