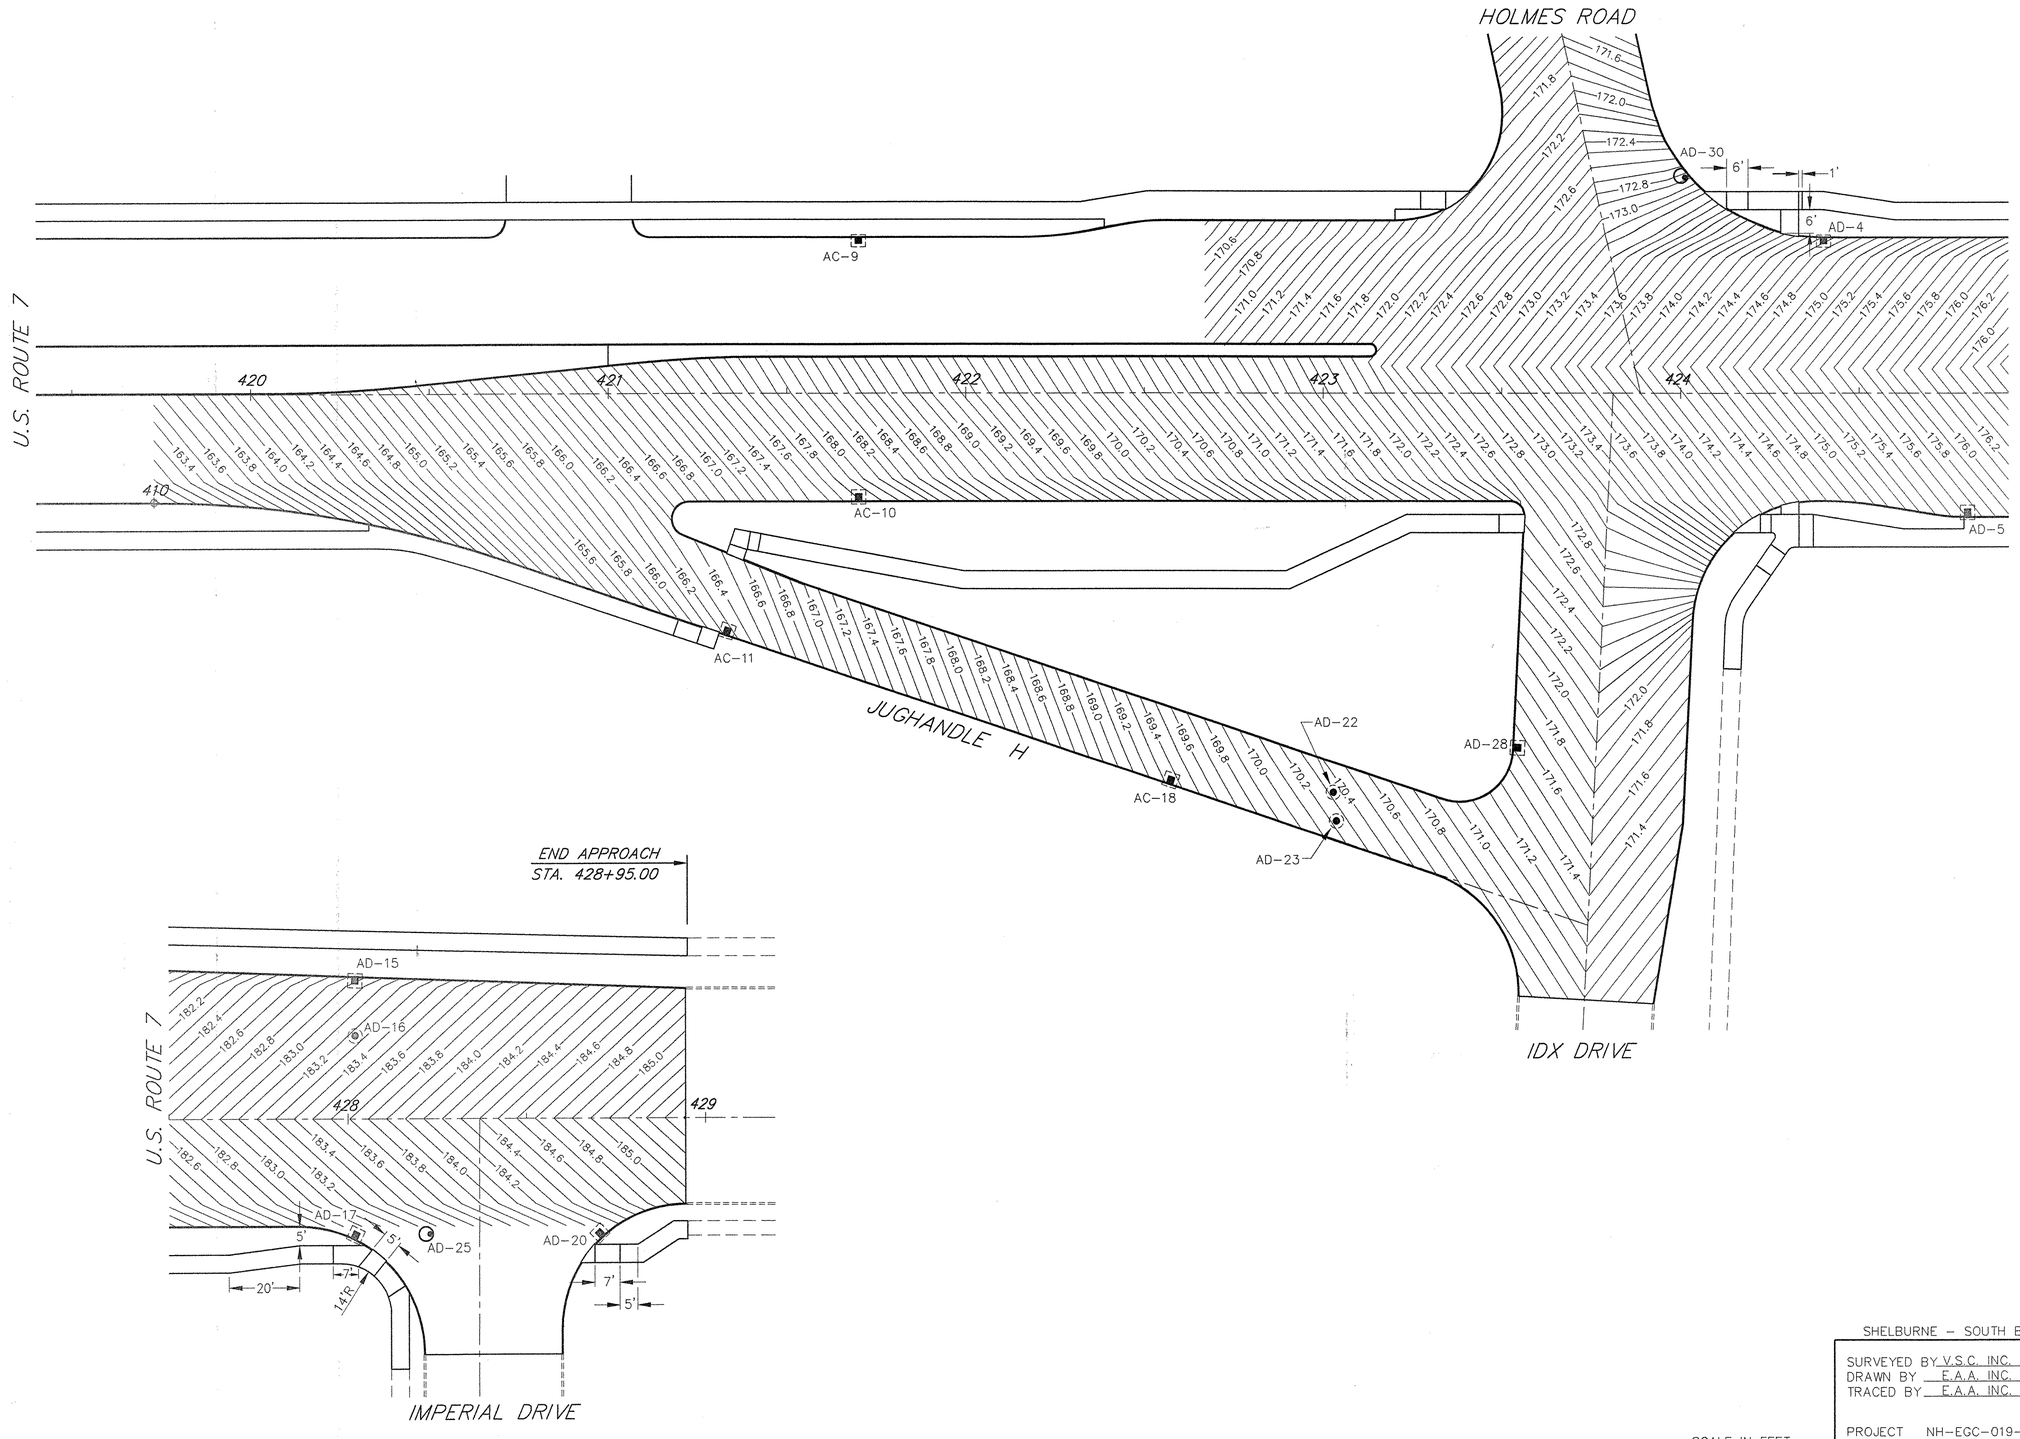

DATUM
VERTICAL NGVD 1929
HORIZONTAL NAD 1927

4/4/03

SCALE IN FEET
0 20 40

SHELBURNE – SOUTH BURLINGTON

SURVEYED BY V.S.C. INC. DATE
DRAWN BY E.A.A. INC. DATE
TRACED BY E.A.A. INC. DATE

PROJECT NH-EGC-019-4(28)
CONTOUR DRAWING NO. 2
SHEET NO. 235 OF 283