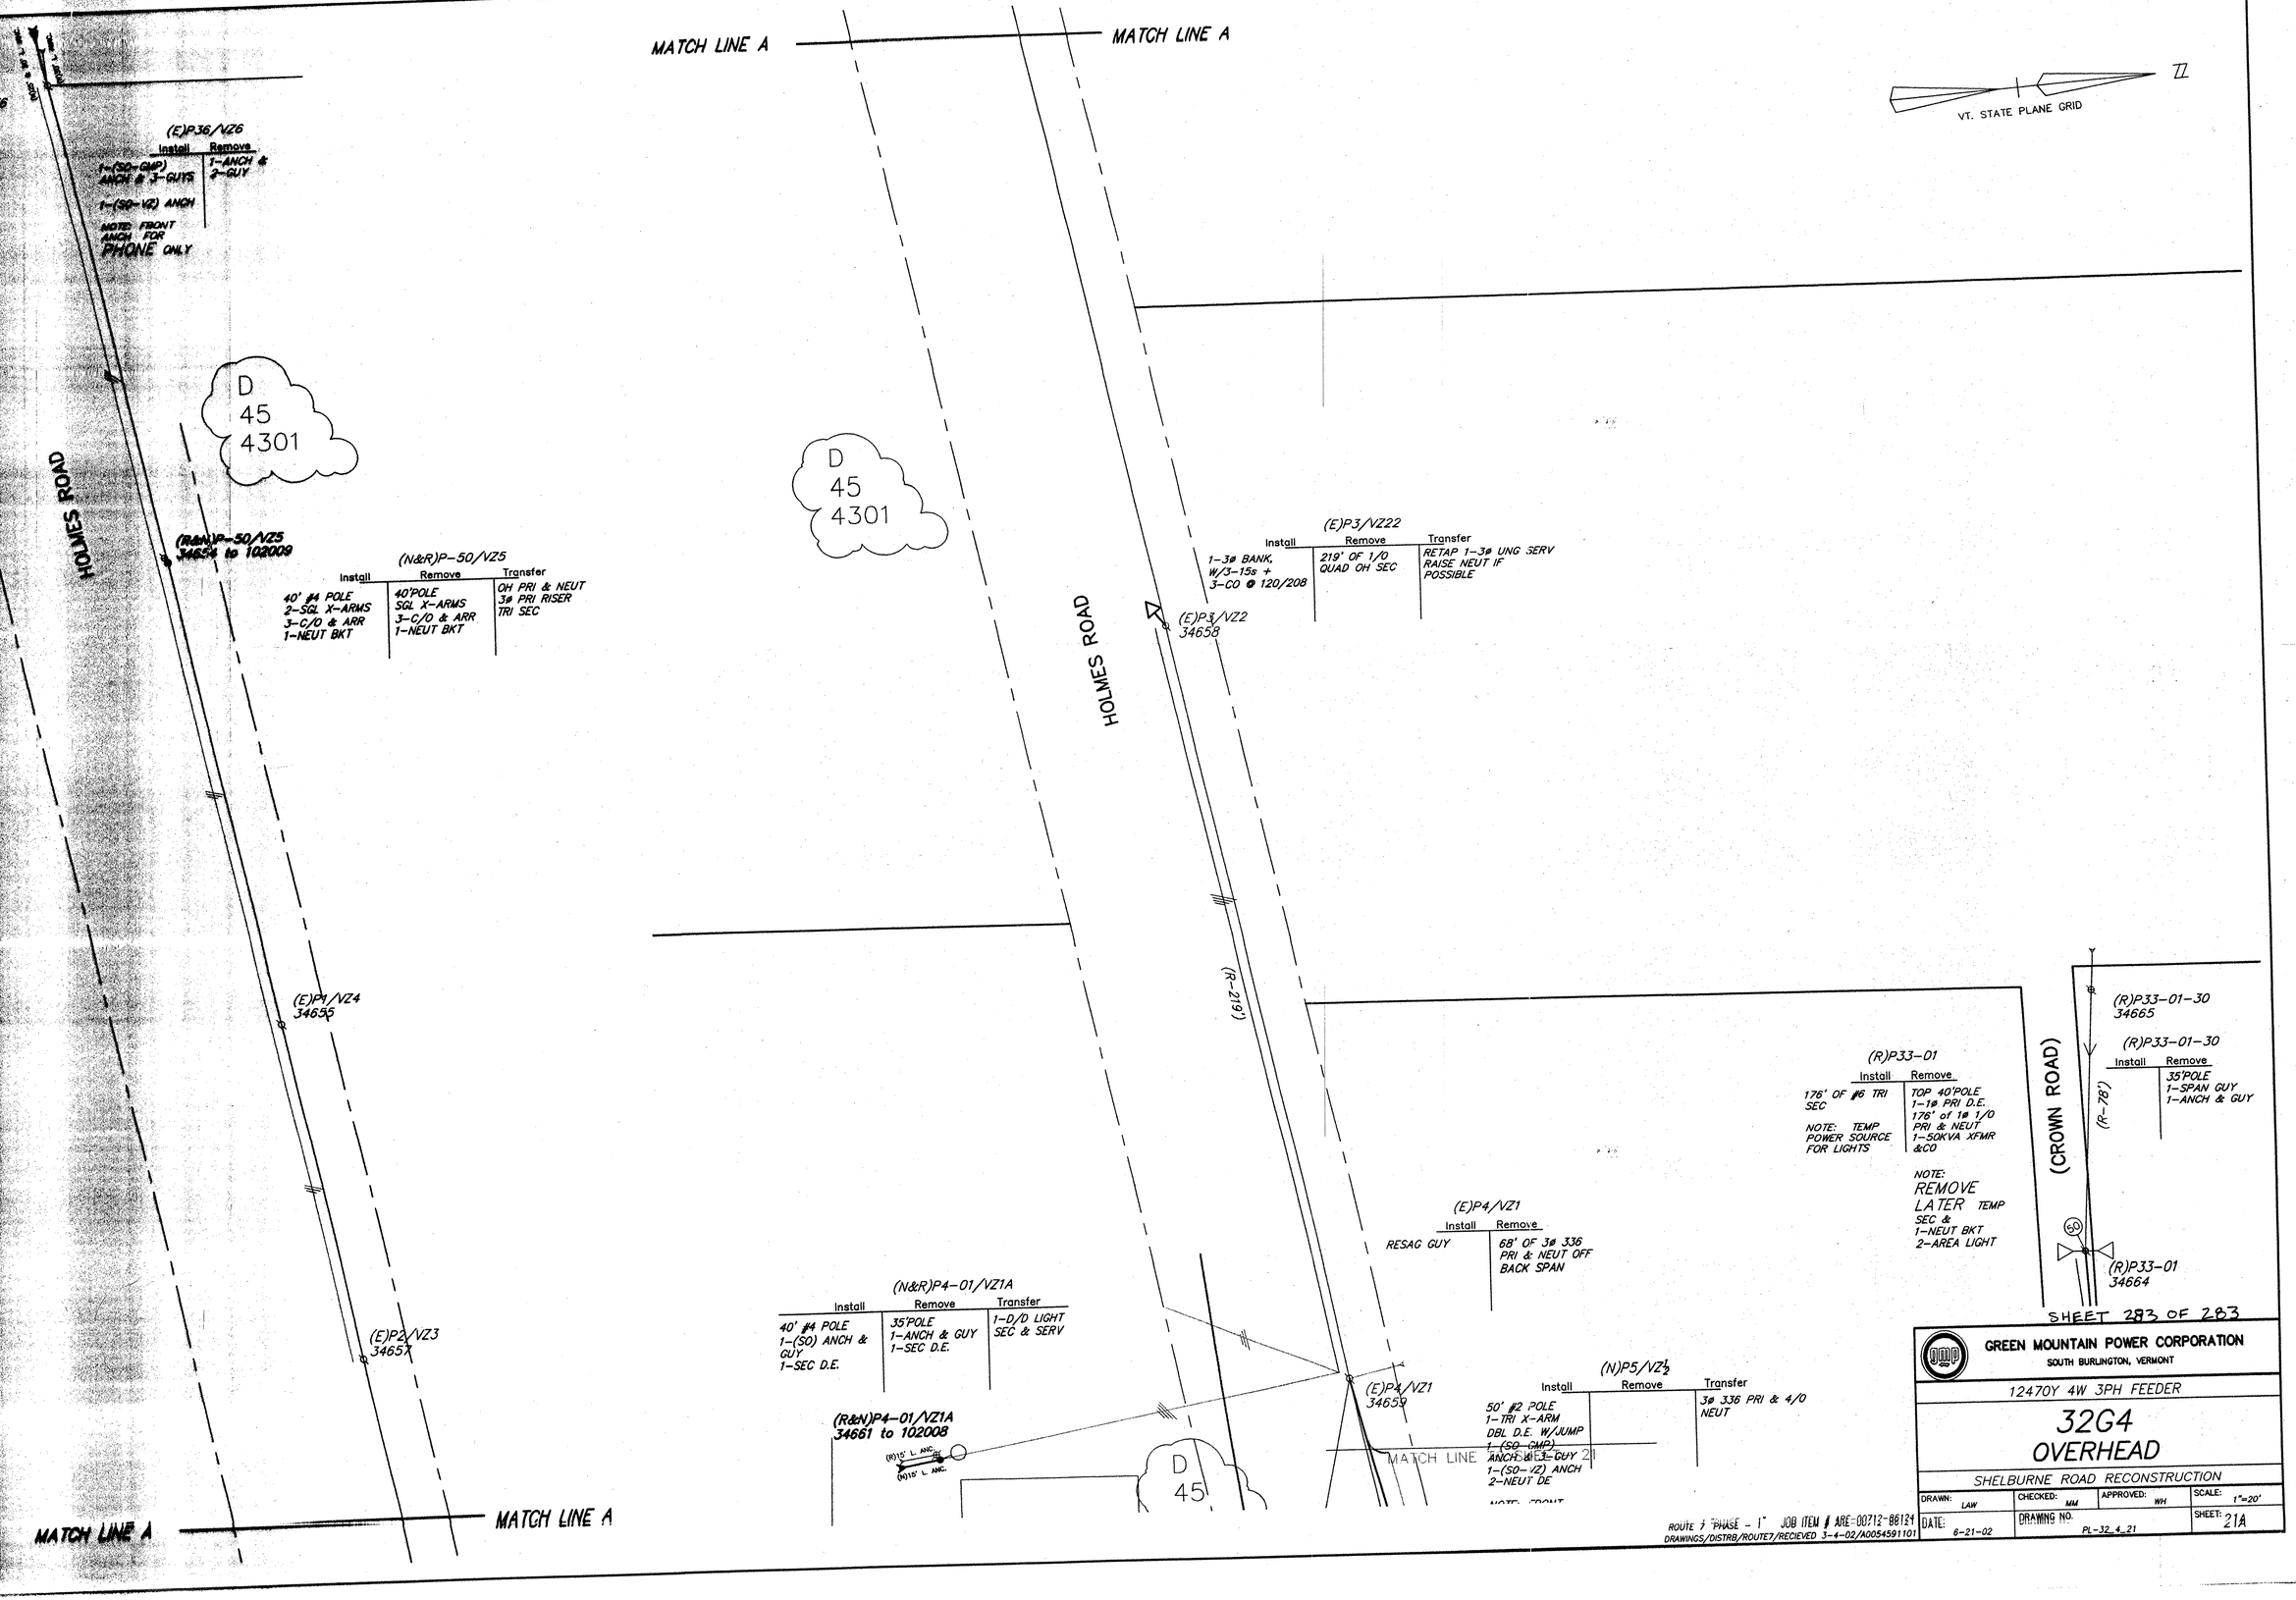

GREEN MOUNTAIN POWER CORPORATION
SOUTH BURLINGTON, VERMONT

12470Y 4W 3PH FEEDER

32G4
OVERHEAD

SHELBURNE ROAD RECONSTRUCTION

DRAWN: LAW	CHECKED: MM	APPROVED: WH	SCALE: 1"=20'
DATE: 6-21-02	DRAWING NO. PL-32_4_21		SHEET: 21A

ROUTE 7 PHASE - 1 JOB ITEM # ARE-00712-86124
DRAWINGS/DISTRB/ROUTE7/RECIEVED 3-4-02/A00545911101