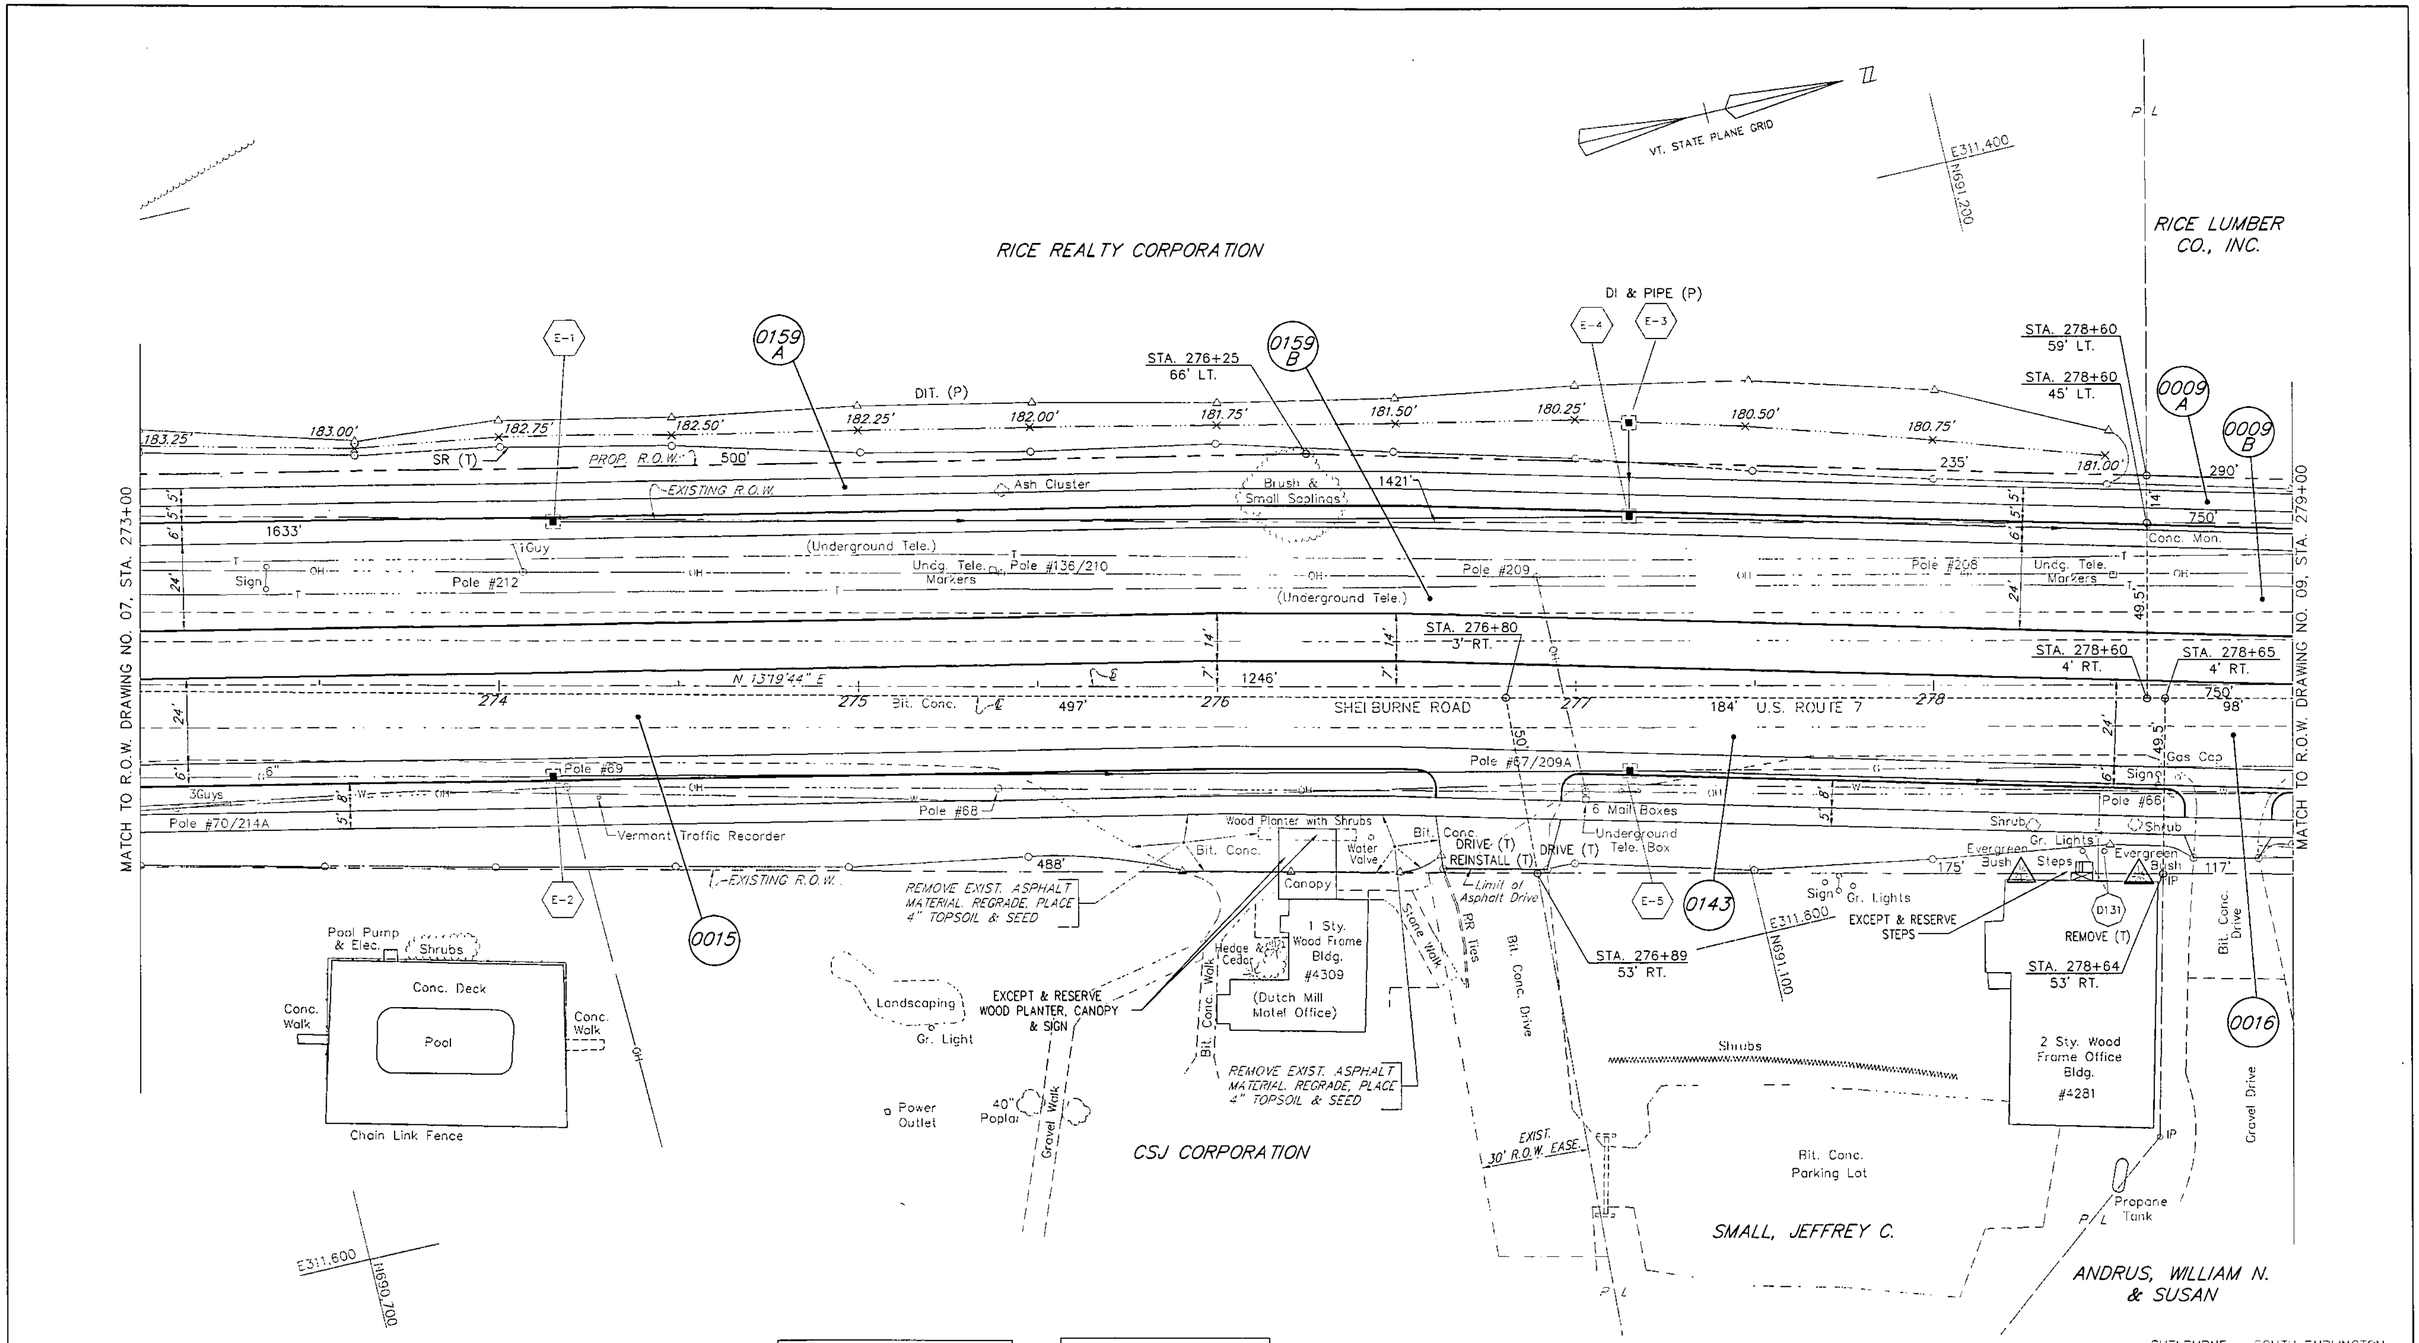

DEMOLITION & DISPOSAL OF:
D131 @ 278+45, RT (2 GLs)

CONSTRUCT DRIVE
276+78 RT – 35'
278+82 RT – 24'

DATUM
VERTICAL NGVD 1929
HORIZONTAL NAD 1927

R.O.W. PLAN

THIS SHEET TO BE USED FOR R.O.W. INFORMATION ONLY.

SHELBURNE – SOUTH BURLINGTON

SURVEYED BY V.S.C. INC. DATE
DRAWN BY E.A.A. INC. DATE
TRACED BY E.A.A. INC. DATE

PROJECT F-EGC-019-4(19)
R.O.W. DRAWING NO. 08
SHEET NO. 61 OF 129 47 OF 537

C.O.#12, 9/13/02