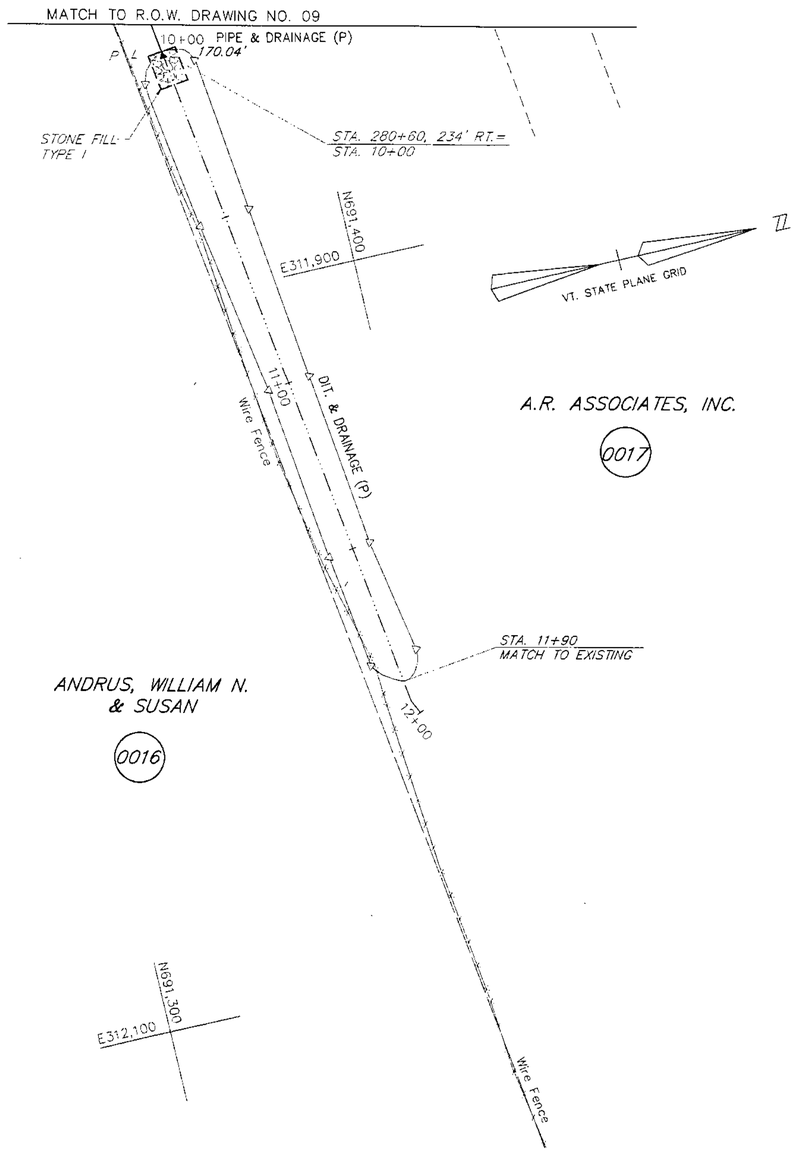

A.R. ASSOCIATES, INC.

0017

ANDRUS, WILLIAM N.
& SUSAN

0016

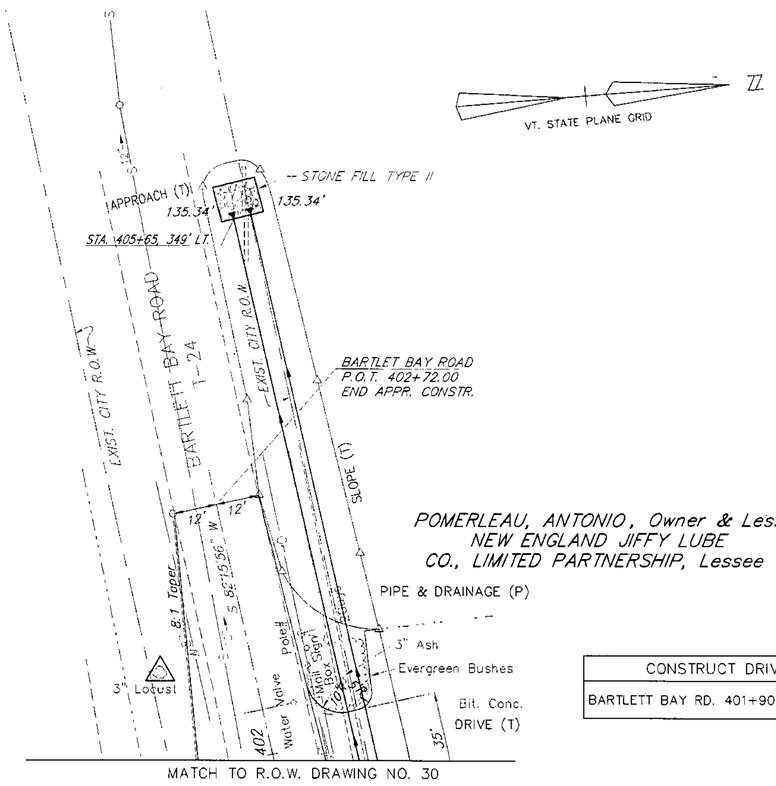

POMERLEAU, ANTONIO, Owner & Lessor,
NEW ENGLAND JIFFY LUBE
CO., LIMITED PARTNERSHIP, Lessee

PIPE & DRAINAGE (P)

CONSTRUCT DRIVE
BARTLETT BAY RD. 401+90 RT - 35'

DATUM
VERTICAL NGVD 1929
HORIZONTAL NAD 1927

SCALE IN FEET
0 20 40

R.O.W. PLAN

THIS SHEET TO BE USED
FOR R.O.W. INFORMATION ONLY.

SHELBURNE - SOUTH BURLINGTON

SURVEYED BY V.S.C. INC. DATE
DRAWN BY E.A.A. INC. DATE
TRACED BY E.A.A. INC. DATE

PROJECT F-ECC-019-4(19)
R.O.W. DRAWING NO. 34
SHEET NO. 87 OF 129 65 OF 537

C.O.#11, 4/19/02