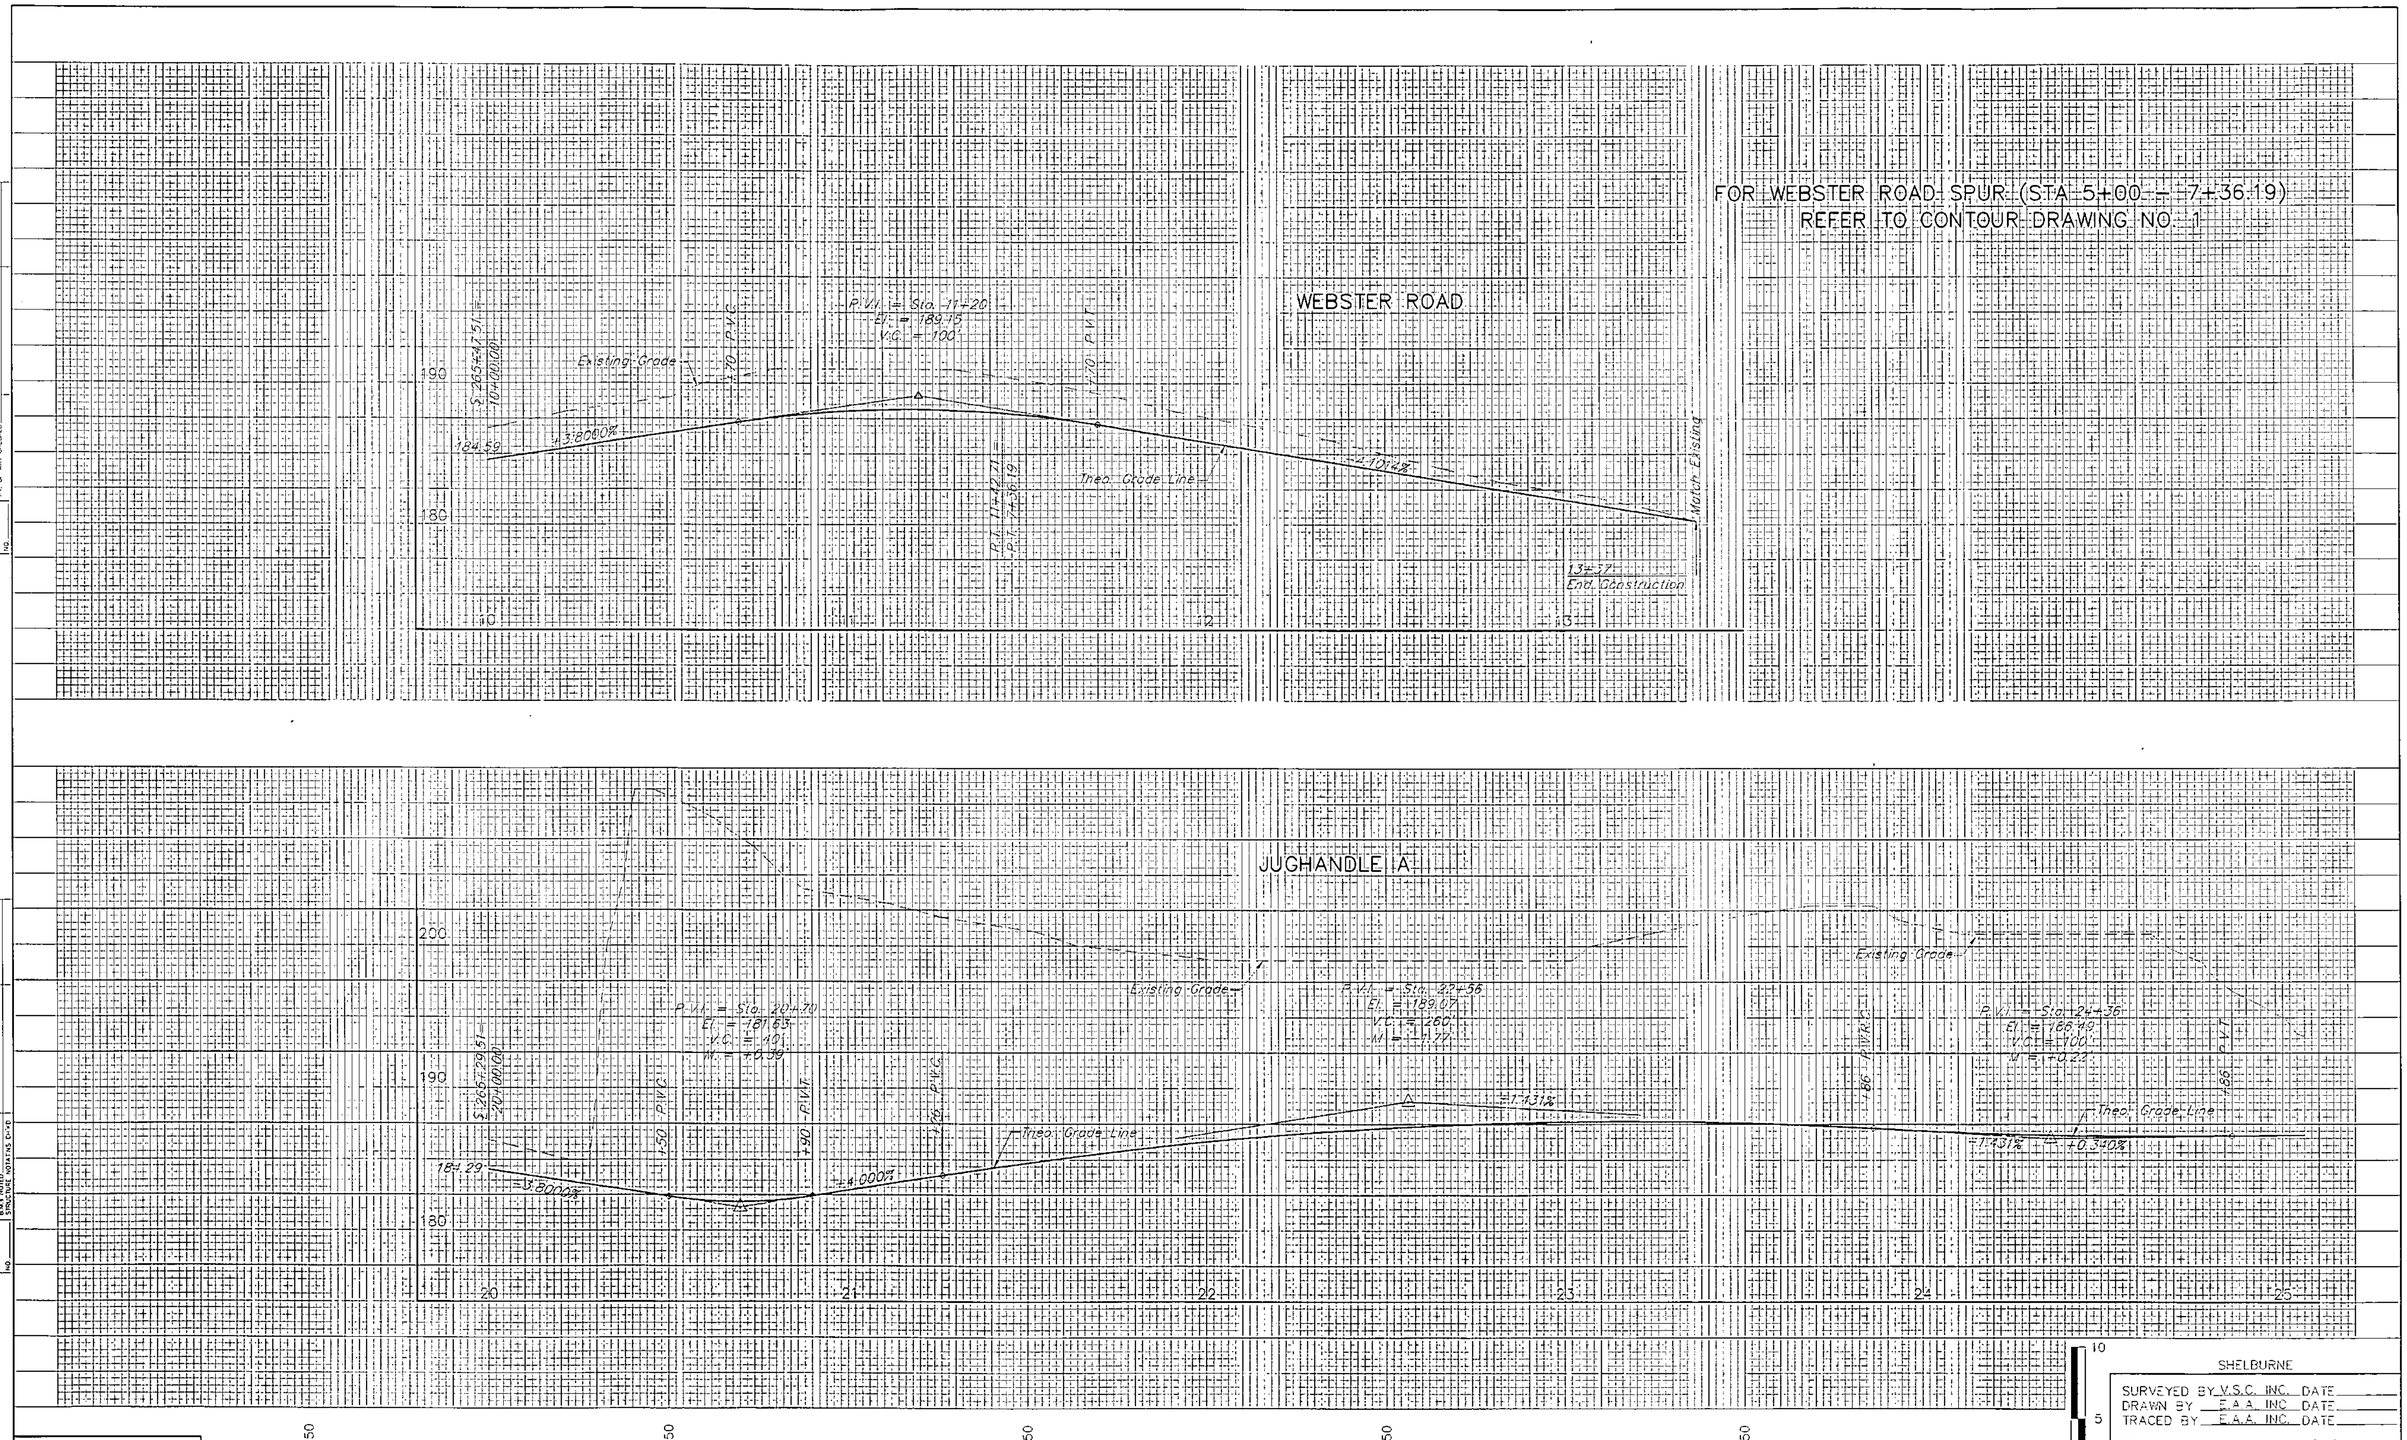

DATUM
VERTICAL NGVD 1929
HORIZONTAL NAD 1927

4/13/04

FOR PLAN SEE PLAN DRAWING NO. 2/3

SCALE IN FEET
0 20 40

SHELBURNE

SURVEYED BY V.S.C. INC. DATE
DRAWN BY E.A.A. INC. DATE
TRACED BY E.A.A. INC. DATE

PROJECT NH-EGC-019-4(27)
PROFILE DRAWING NO. 3
SHEET NO. 130 OF 537