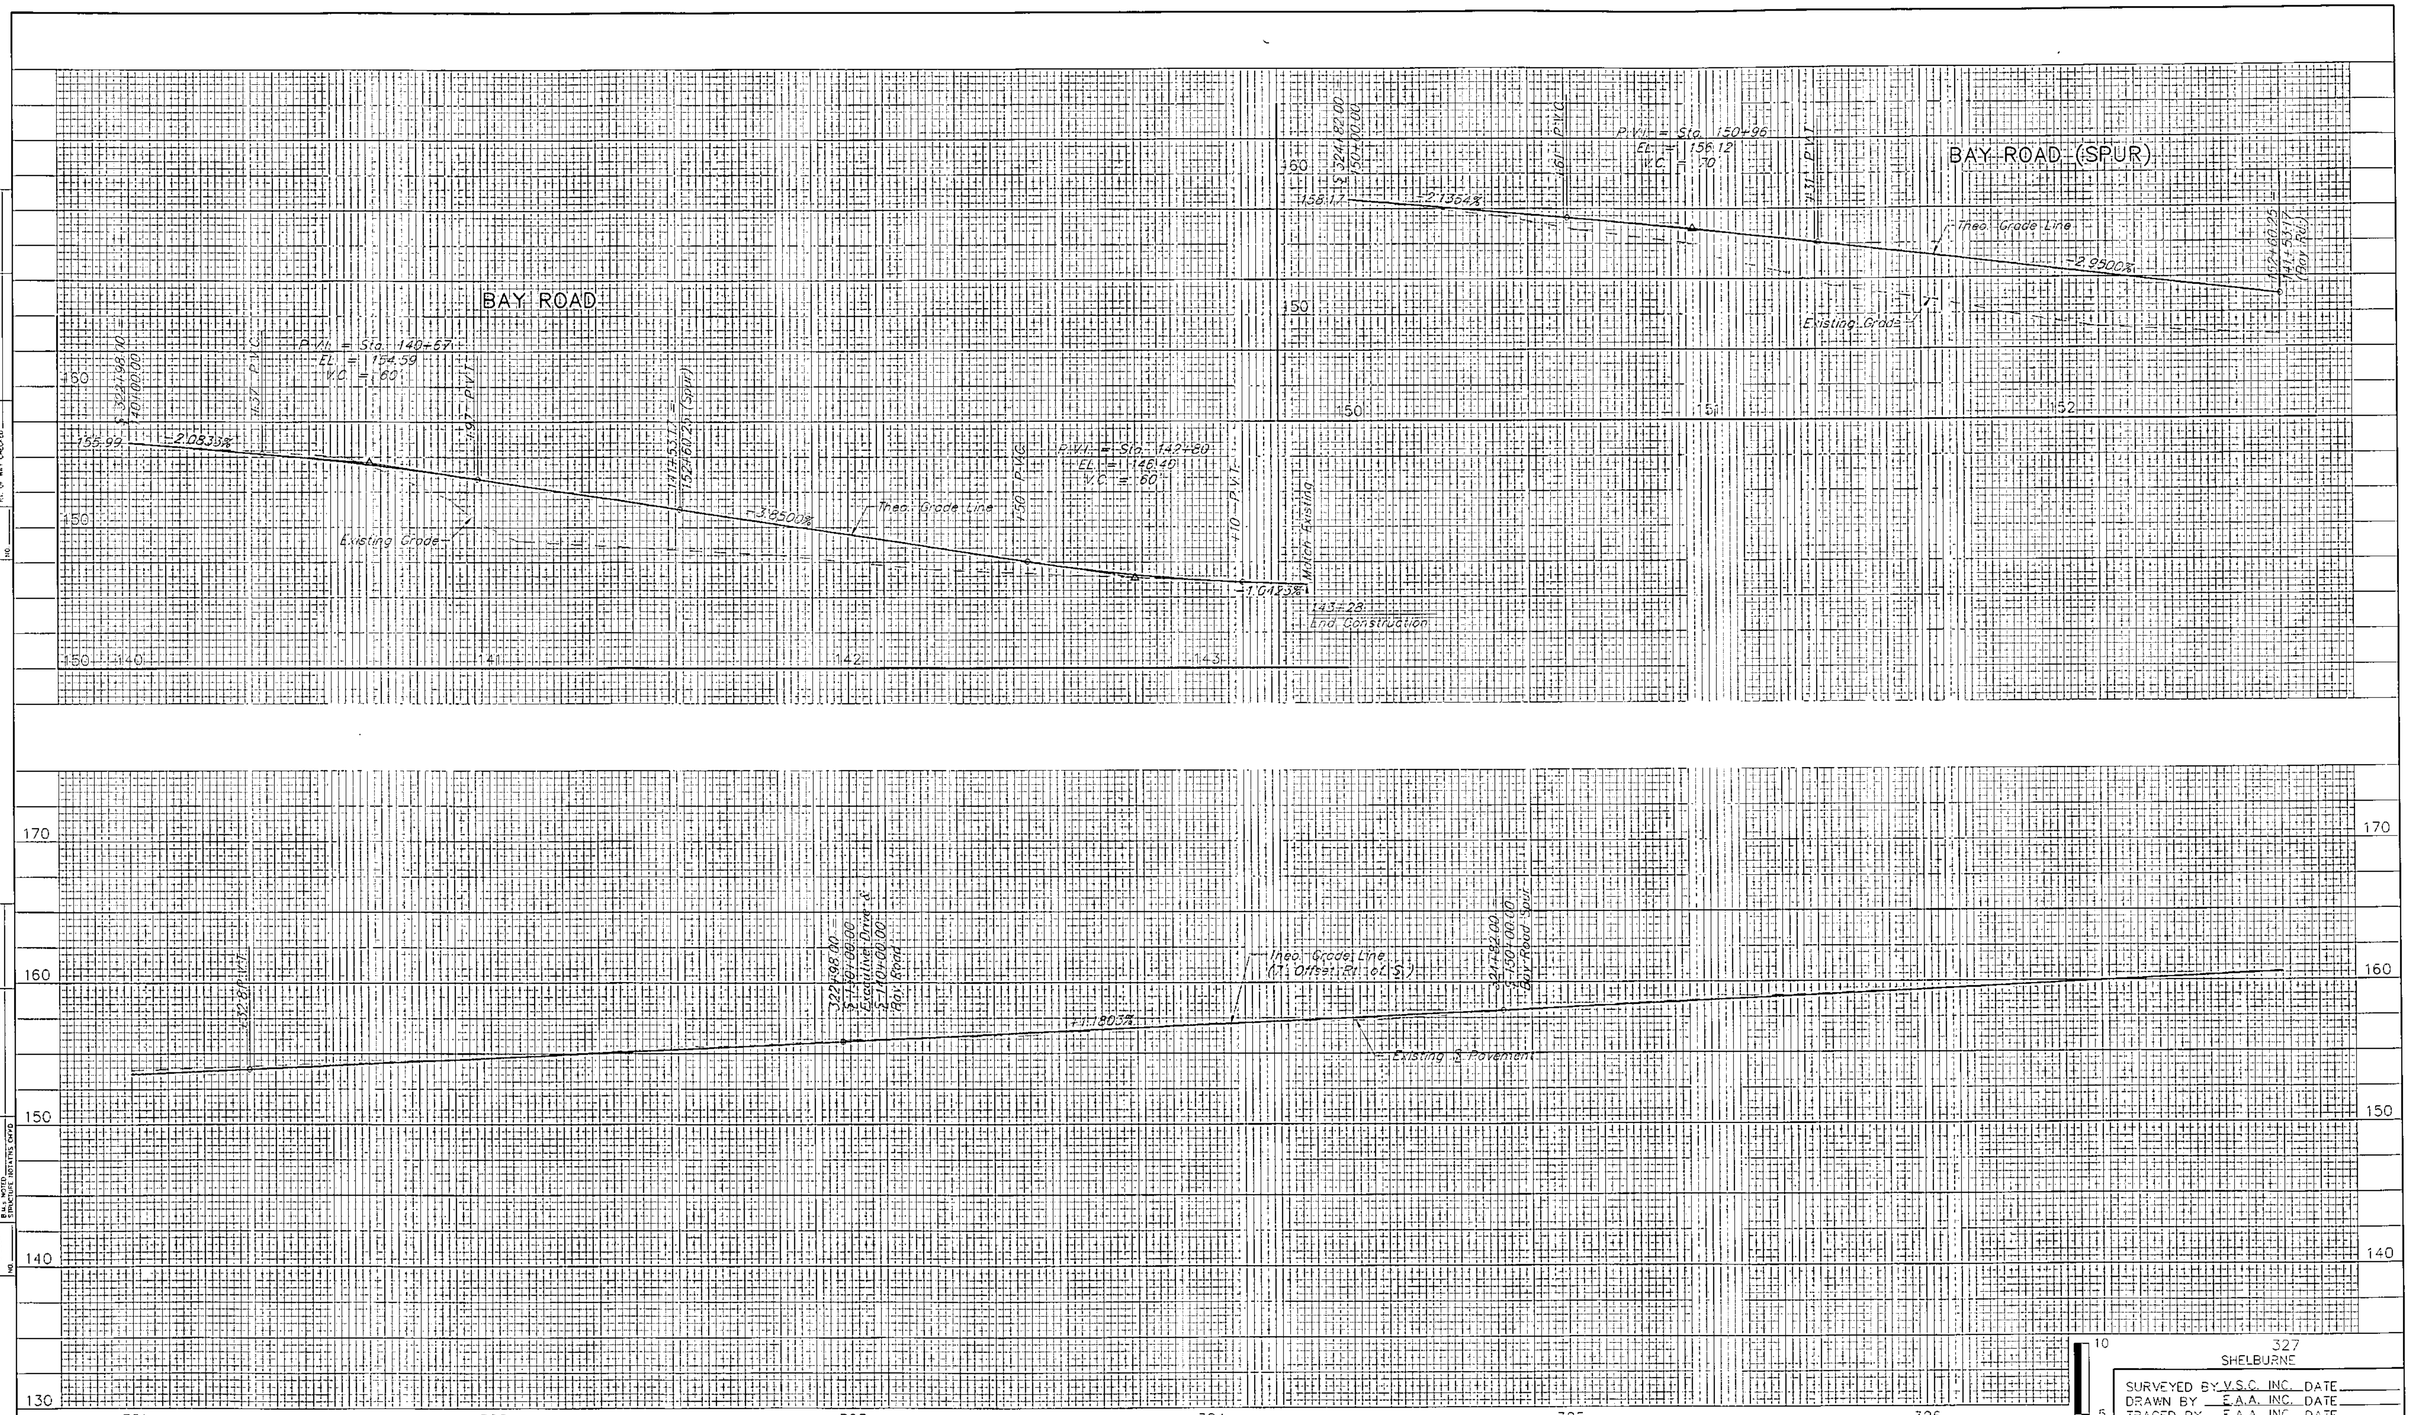
BAY ROAD
BAY ROAD (SPUR)
P.V.I. = Sta. 140+57
EL = 154.59
V.C. = 60'
155.99
-2.0833%
Existing Grade
Theo. Grade Line
-3.8500%
-1.0417%
P.V.I. = Sta. 142+80
EL = 148.40
V.C. = 60'
143+28
End Construction
Match Existing
P.V.I. = Sta. 150+95
EL = 156.12
V.C. = 70'
158.17
-2.1364%
-2.9500%
Existing Grade
Theo. Grade Line
Theo. Grade Line
(1' Offset Rt. Lot 5)
+1.8034%
Existing ℄ Pavement
Bay Road Spur
Existing Drive &
Bay Road
DATUM
VERTICAL NGVD 1929
HORIZONTAL NAD 1927
4/13/04
FOR PLAN SEE PLAN DRAWING NO. 12
SCALE IN FEET
0 20 40
SHELBURNE
SURVEYED BY V.S.C. INC. DATE
DRAWN BY E.A.A. INC. DATE
TRACED BY E.A.A. INC. DATE
PROJECT NH-EGC-019-4(27)
PROFILE DRAWING NO. 13
SHEET NO. 140 OF 537
PLAN
PROFILE