PLAN

NOTE BOOK NO.

SURVEYED
PLOTTED
ALIGNMENT CHECKED
R/L OF WAY CHECKED

BY

DATE

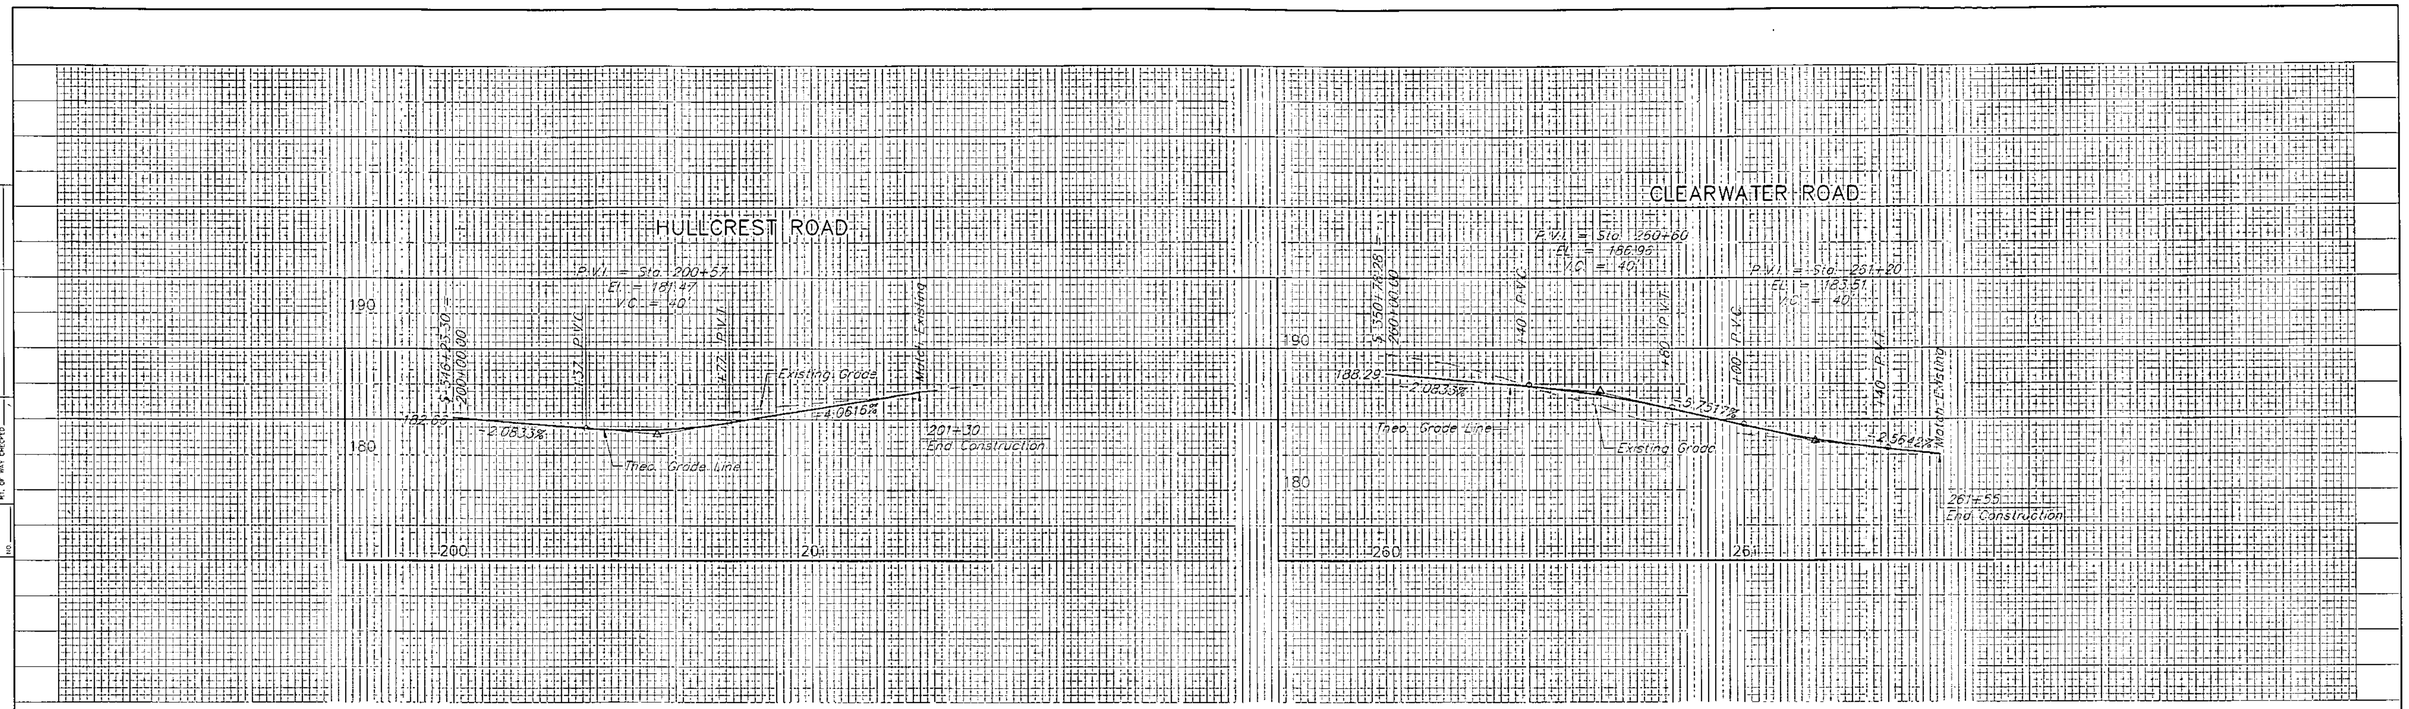

PROFILE

NOTE BOOK NO.

SURVEYED
PLOTTED
GRADES CHECKED
B.M.'s NOTED
STRUCTURE NOTES CKD.

BY

DATE

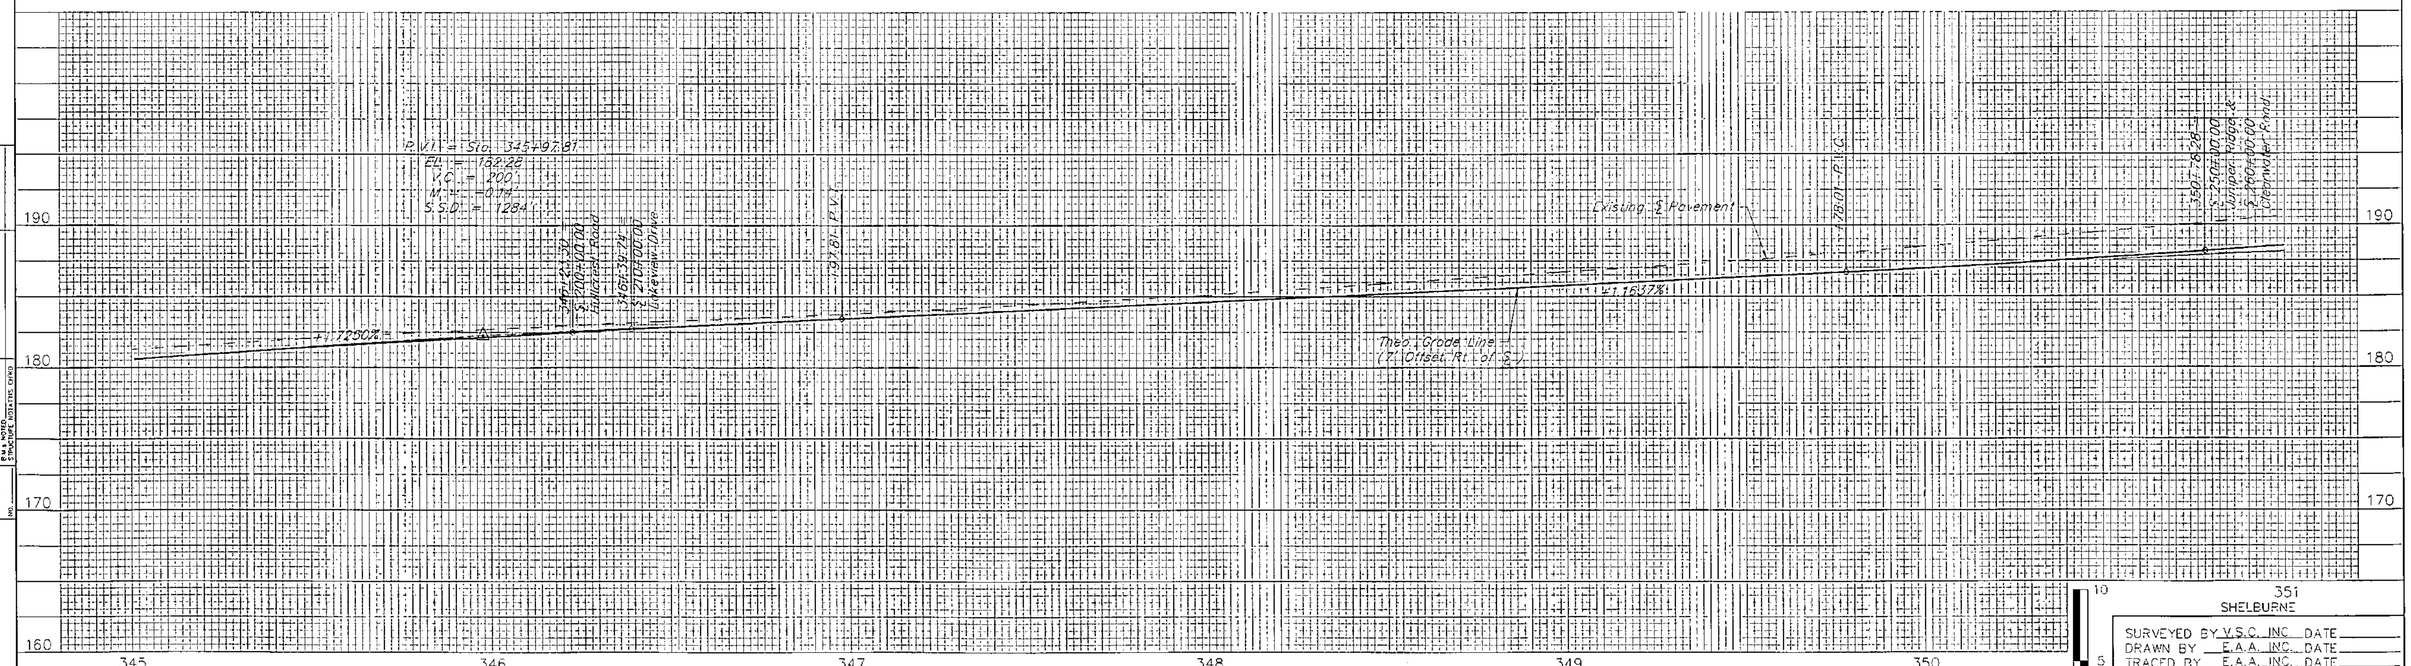

DATUM
VERTICAL NGVD 1929
HORIZONTAL NAD 1927

4/13/04

FOR PLAN SEE PLAN DRAWING NO. 16

SURVEYED BY V.S.C. INC. DATE
DRAWN BY E.A.A. INC. DATE
TRACED BY E.A.A. INC. DATE

PROJECT NH-EGC-019-4(27)
PROFILE DRAWING NO. 17
SHEET NO. 144 OF 537