PLAN

NOTE BOOK NO.

SURVEYED
PLOTTED
ALIGNMENT CHECKED
RT. OF WAY CHECKED

BY

DATE

PROFILE

NOTE BOOK NO.

SURVEYED
PLOTTED
GRADES CHECKED
B.M.'S NOTED
STRUCTURE NOTES CKD.

BY

DATE

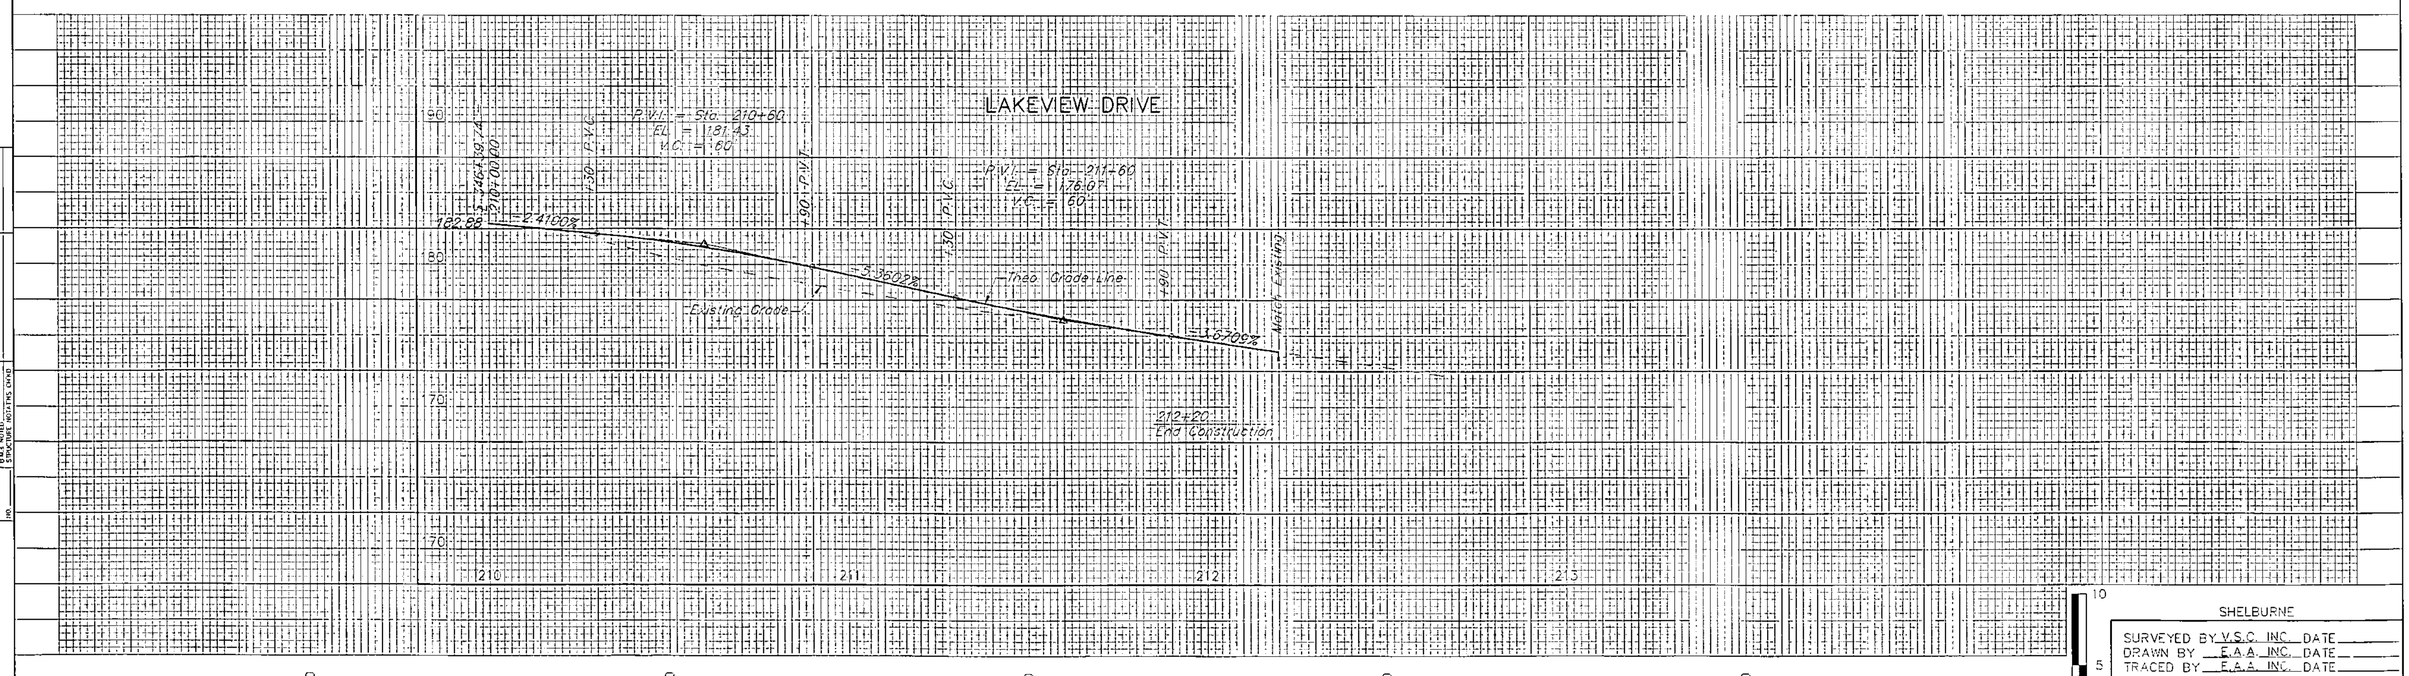

DATUM
VERTICAL NGVD 1929
HORIZONTAL NAD 1927

4/13/04

FOR PLAN SEE PLAN DRAWING NO. 16

SHELBURNE

SURVEYED BY V.S.C. INC. DATE
DRAWN BY E.A.A. INC. DATE
TRACED BY E.A.A. INC. DATE

PROJECT NH-EGC-019-4(27)
PROFILE DRAWING NO. 18
SHEET NO. 145 OF 537